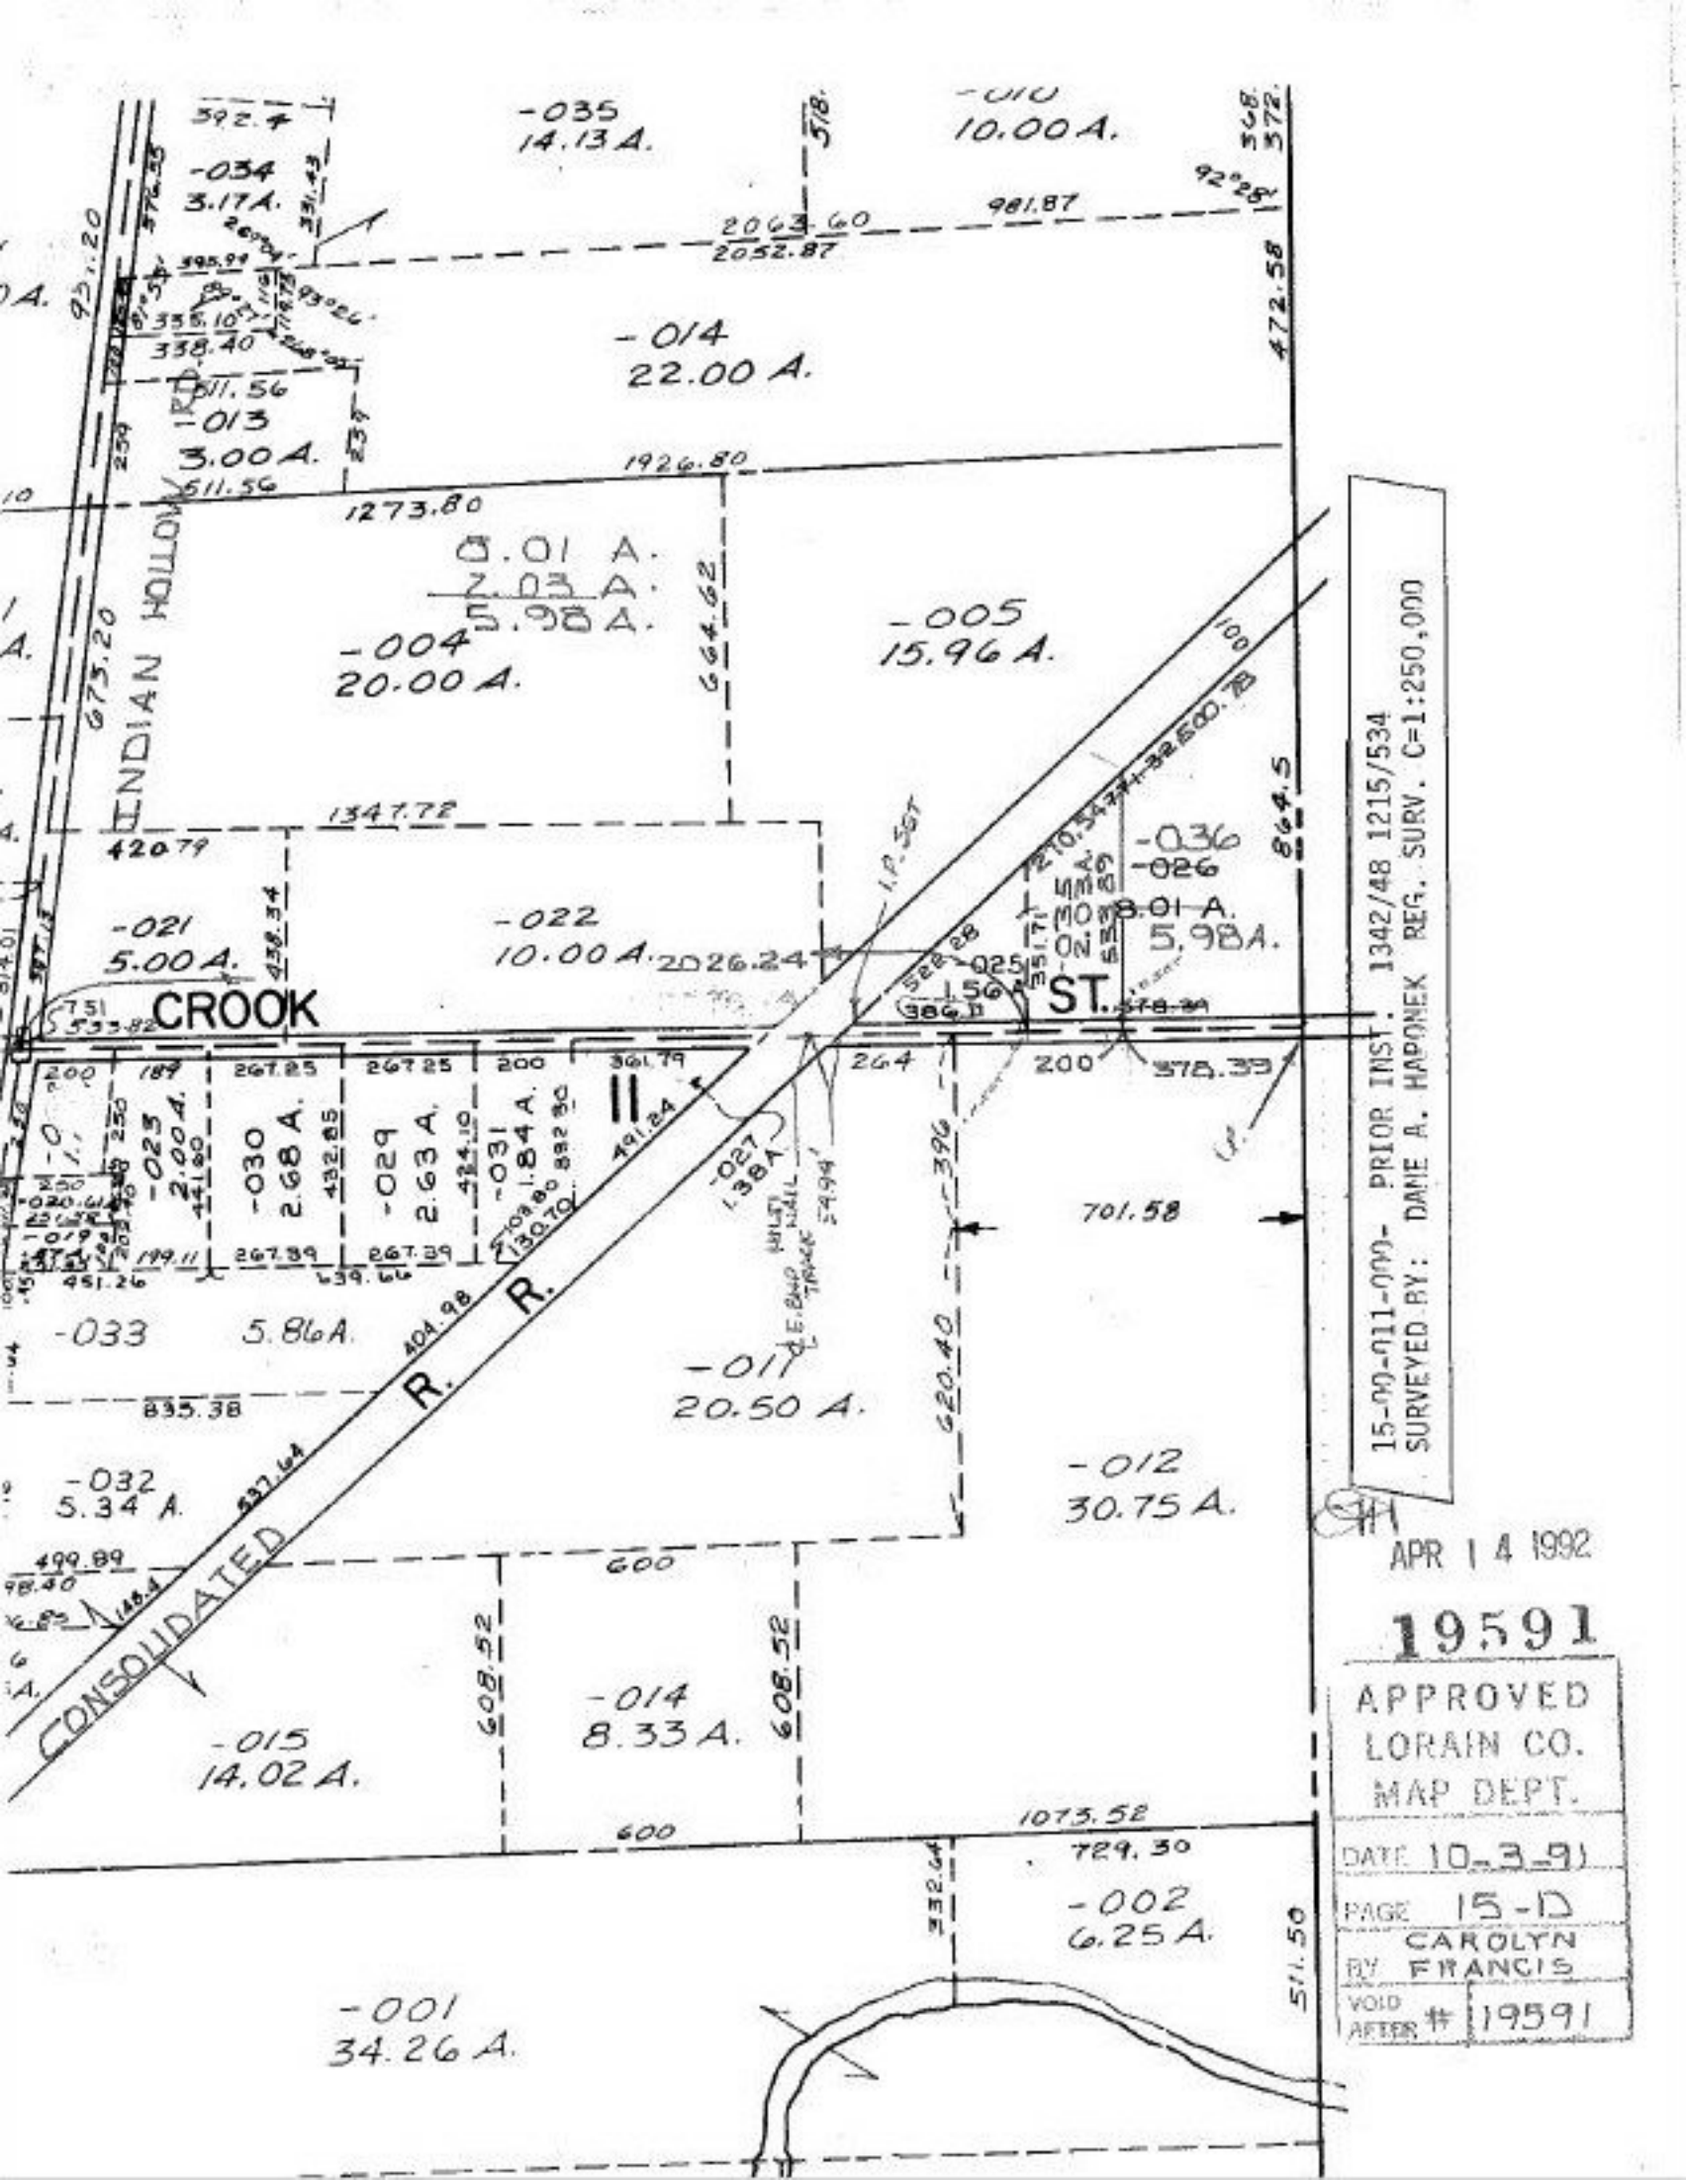
-035
14.13 A.
-010
10.00 A.
-034
3.17 A.
-014
22.00 A.
-013
3.00 A.
INDIAN HOLLOW
-004
20.00 A.
0.01 A.
2.03 A.
5.98 A.
-005
15.96 A.
-021
5.00 A.
-022
10.00 A.
CROOK
ST.
-036
-026
8.01 A.
5.98 A.
-025
2.00 A.
-030
2.68 A.
-029
2.63 A.
-031
1.84 A.
-033
5.86 A.
-011
20.50 A.
-012
30.75 A.
-032
5.34 A.
-015
14.02 A.
-014
8.33 A.
-002
6.25 A.
-001
34.26 A.
R.
R.
CONSOLIDATED
15-09-011-000- PRIOR INST.: 1342/48 1215/534
SURVEYED BY: DANE A. HAPONEK REG. SURV. C=1:250,000
APR 14 1992
19591
APPROVED
LORAIN CO.
MAP DEPT.
DATE 10-3-91
PAGE 15-D
BY CAROLYN FRANCIS
VOID AFTER # 19591