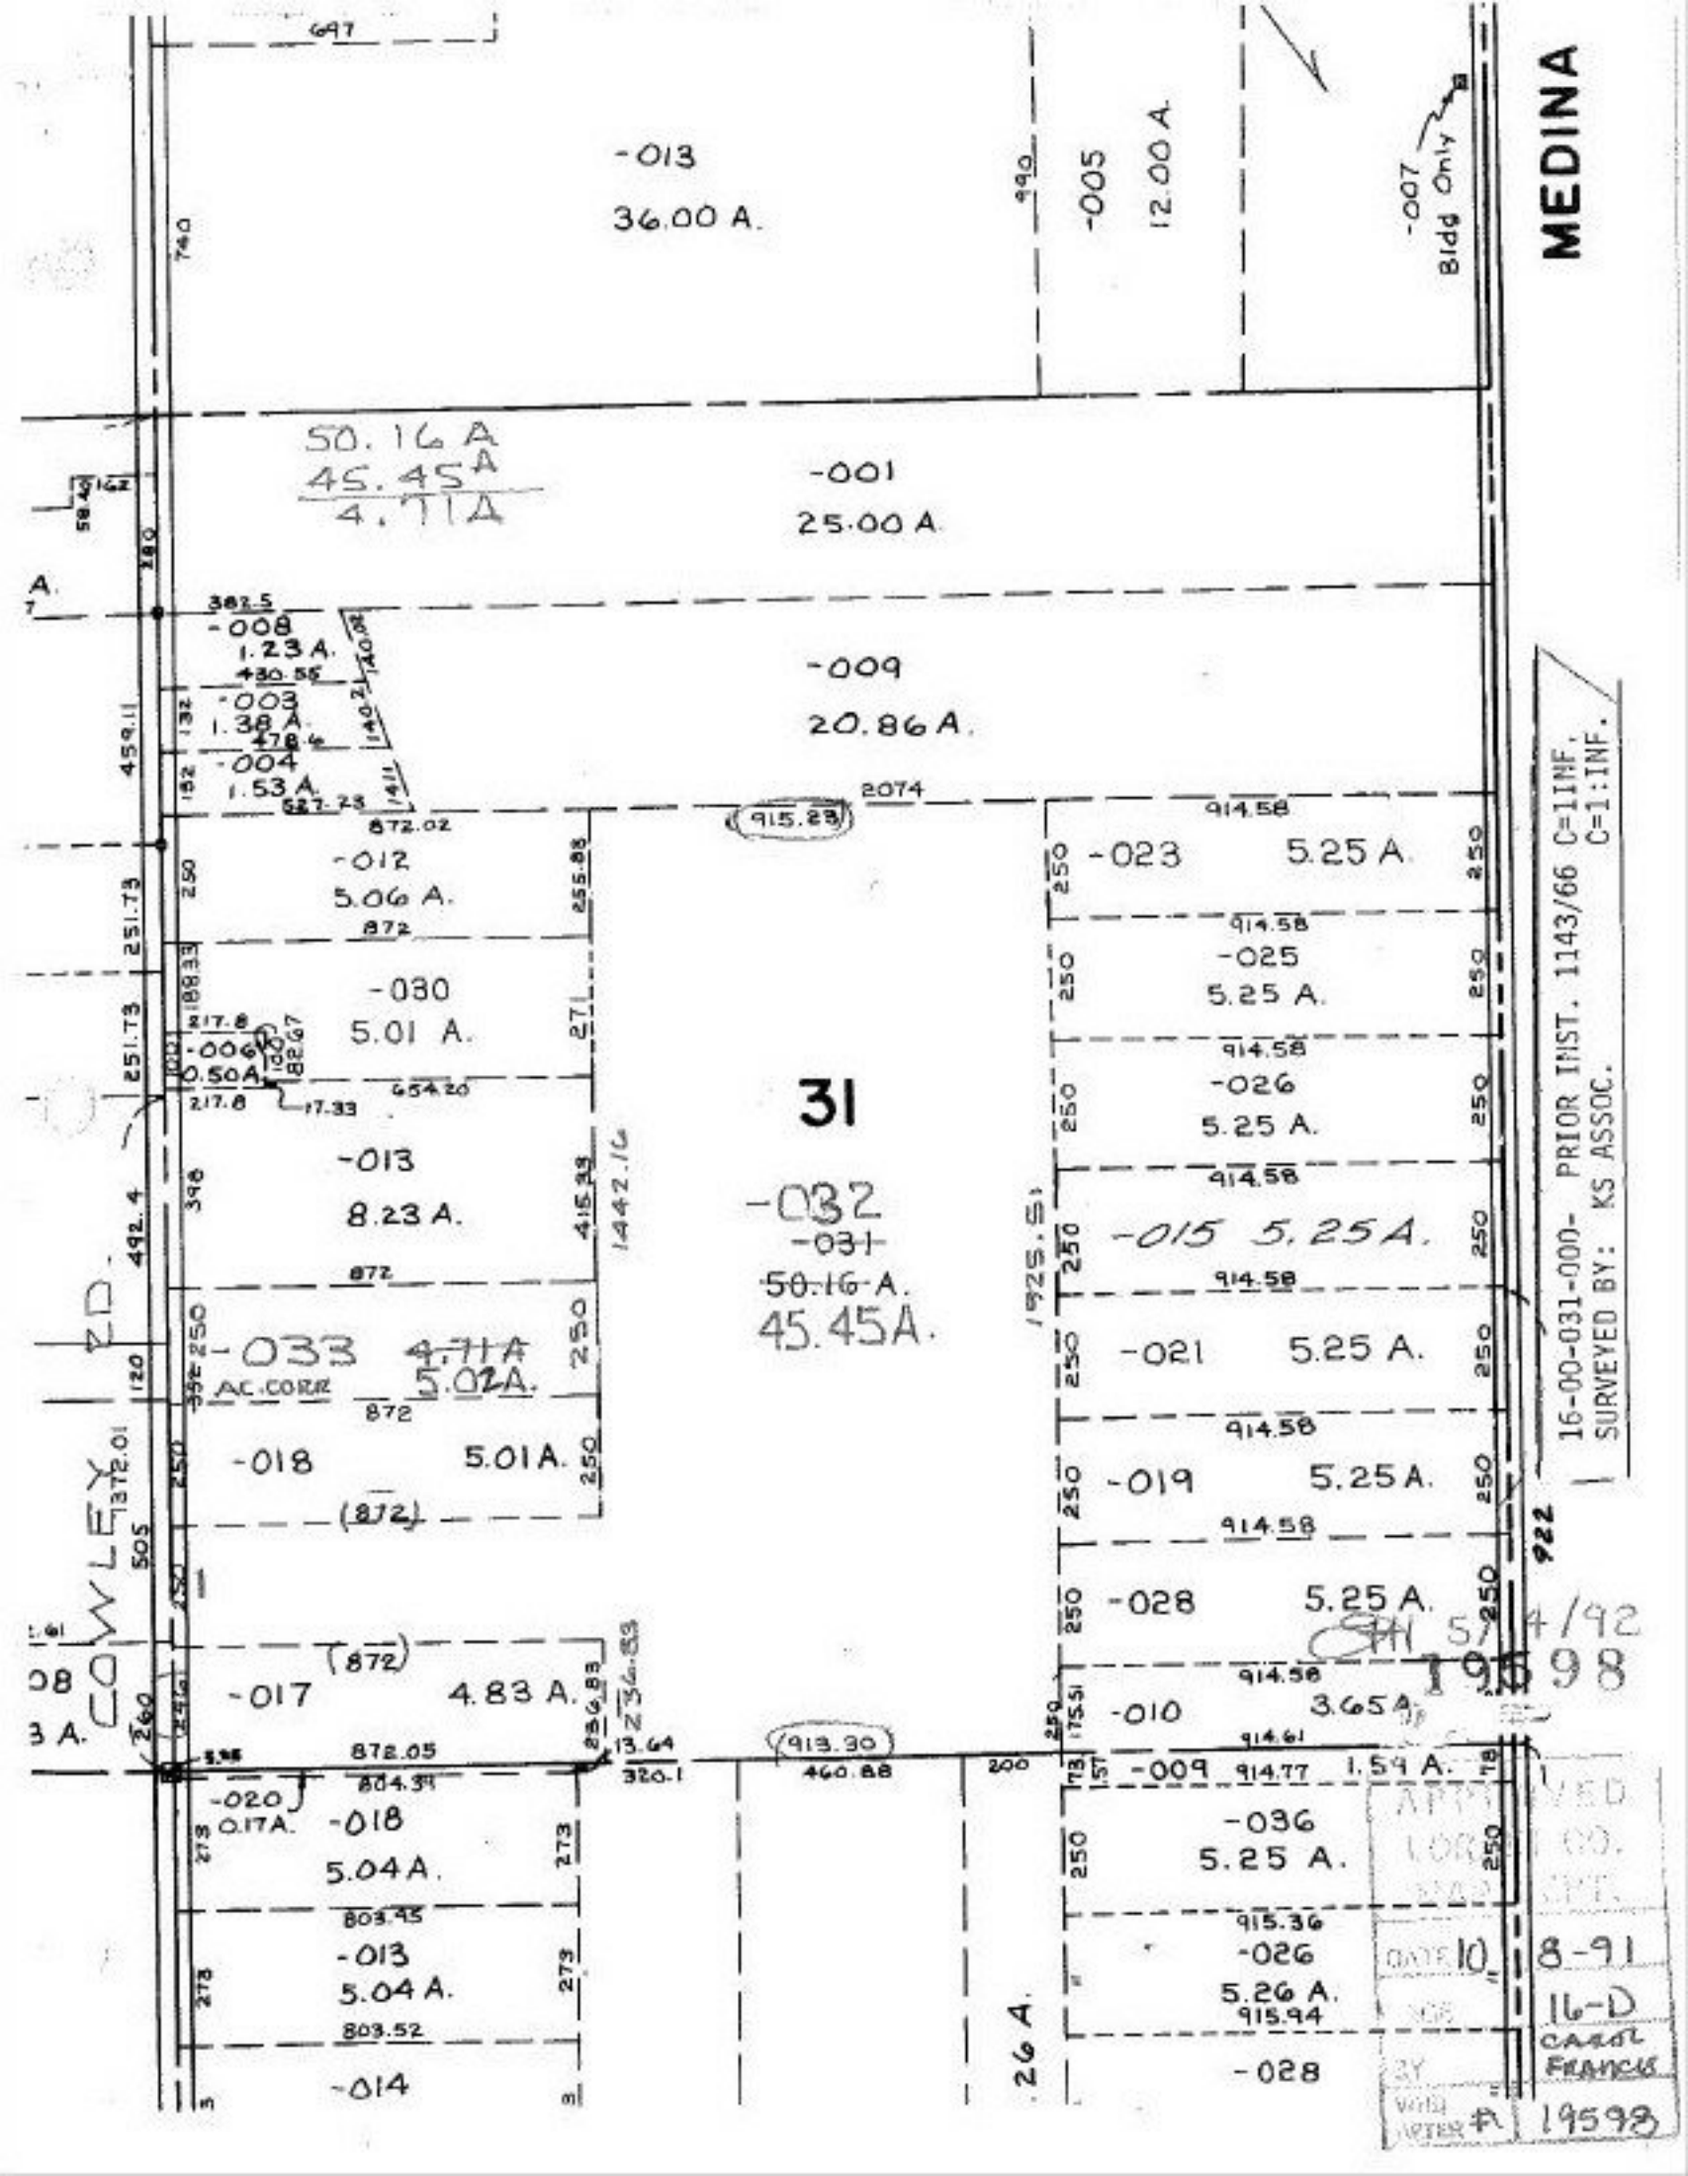
MEDINA
-013
36.00 A.
-005
12.00 A.
-007
Bldg Only
50.16 A
45.45 A
4.71 A
-001
25.00 A.
-008
1.23 A.
-003
1.38 A.
-004
1.53 A.
-009
20.86 A.
-012
5.06 A.
-030
5.01 A.
-006
0.50 A.
-013
8.23 A.
-033
4.71 A
5.02 A.
AC. CORR
-018
5.01 A.
-017
4.83 A.
-020
0.17 A.
-018
5.04 A.
-013
5.04 A.
-014
31
-032
-031
50.16 A.
45.45 A.
-023
5.25 A.
-025
5.25 A.
-026
5.25 A.
-015 5.25 A.
-021
5.25 A.
-019
5.25 A.
-028
5.25 A.
-010
3.65 A.
-009
1.59 A.
-036
5.25 A.
-026
5.26 A.
-028
COWLEY
16-00-031-000- PRIOR INST. 1143/66 C=1INF, C=1:INF.
SURVEYED BY: KS ASSOC.
APPROVED
DATE 10-8-91
MAP 16-D
BY CAROL FRANCIS
WELL NUMBER # 19598