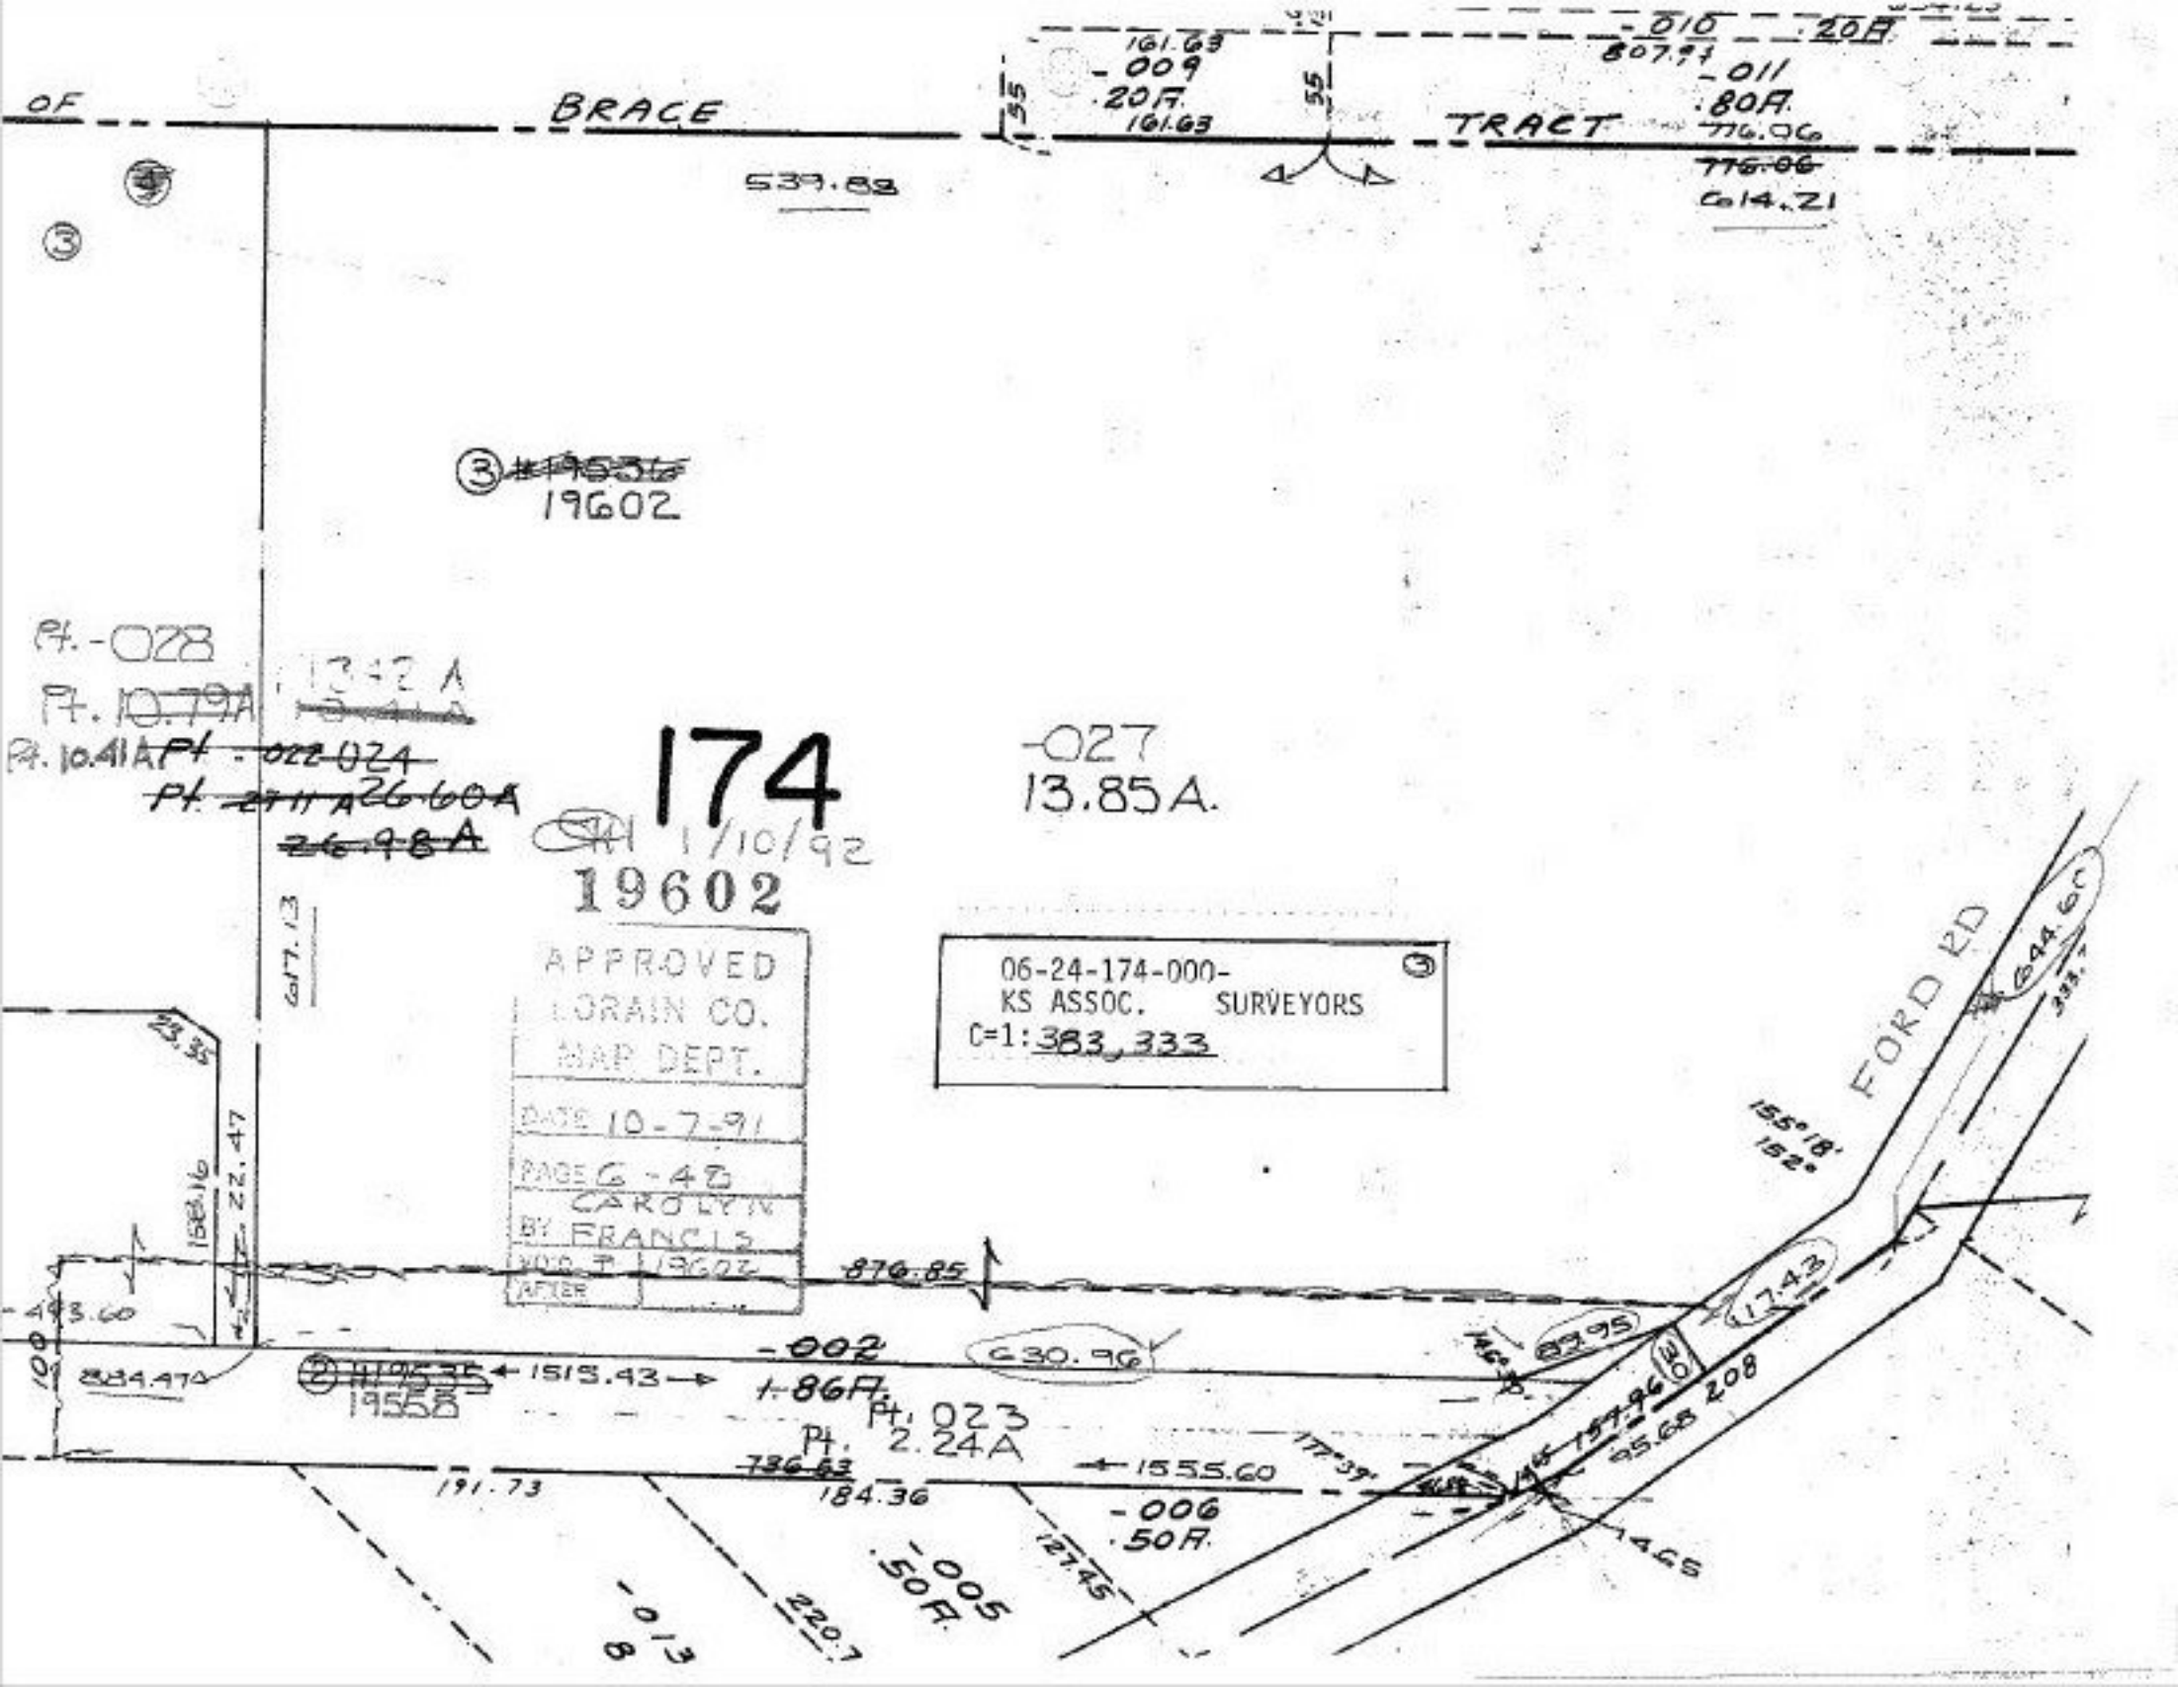
OF
BRACE
TRACT
539.83
161.63
-009
.20A.
161.63
-010
.20A.
807.97
-011
.80A.
776.06
776.06
614.21
19602
Pt.-028
Pt. 10.79A
1342 A
Pt. 10.41A
Pt. -022 024
Pt. 2711 A 26.60A
26.98A
174
1/10/92
19602
-027
13.85A.
APPROVED
LORAIN CO.
MAP DEPT.
DATE 10-7-91
PAGE 6-48
CAROLYN
BY FRANCIS
06-24-174-000-
KS ASSOC. SURVEYORS
C=1: 383, 333
FORD RD
644.60
155°18'
152°
876.85
630.96
-002
1.86A.
1515.43
19558
Pt. 023
Pt. 2.24A
1555.60
184.36
191.73
-006
.50A.
-005
.50A.
127.45
220.7
-013
8
17.43
89.95
157.96
95.68
208
4.65
617.13
23.35
22.47
158.16
493.60
884.47
100