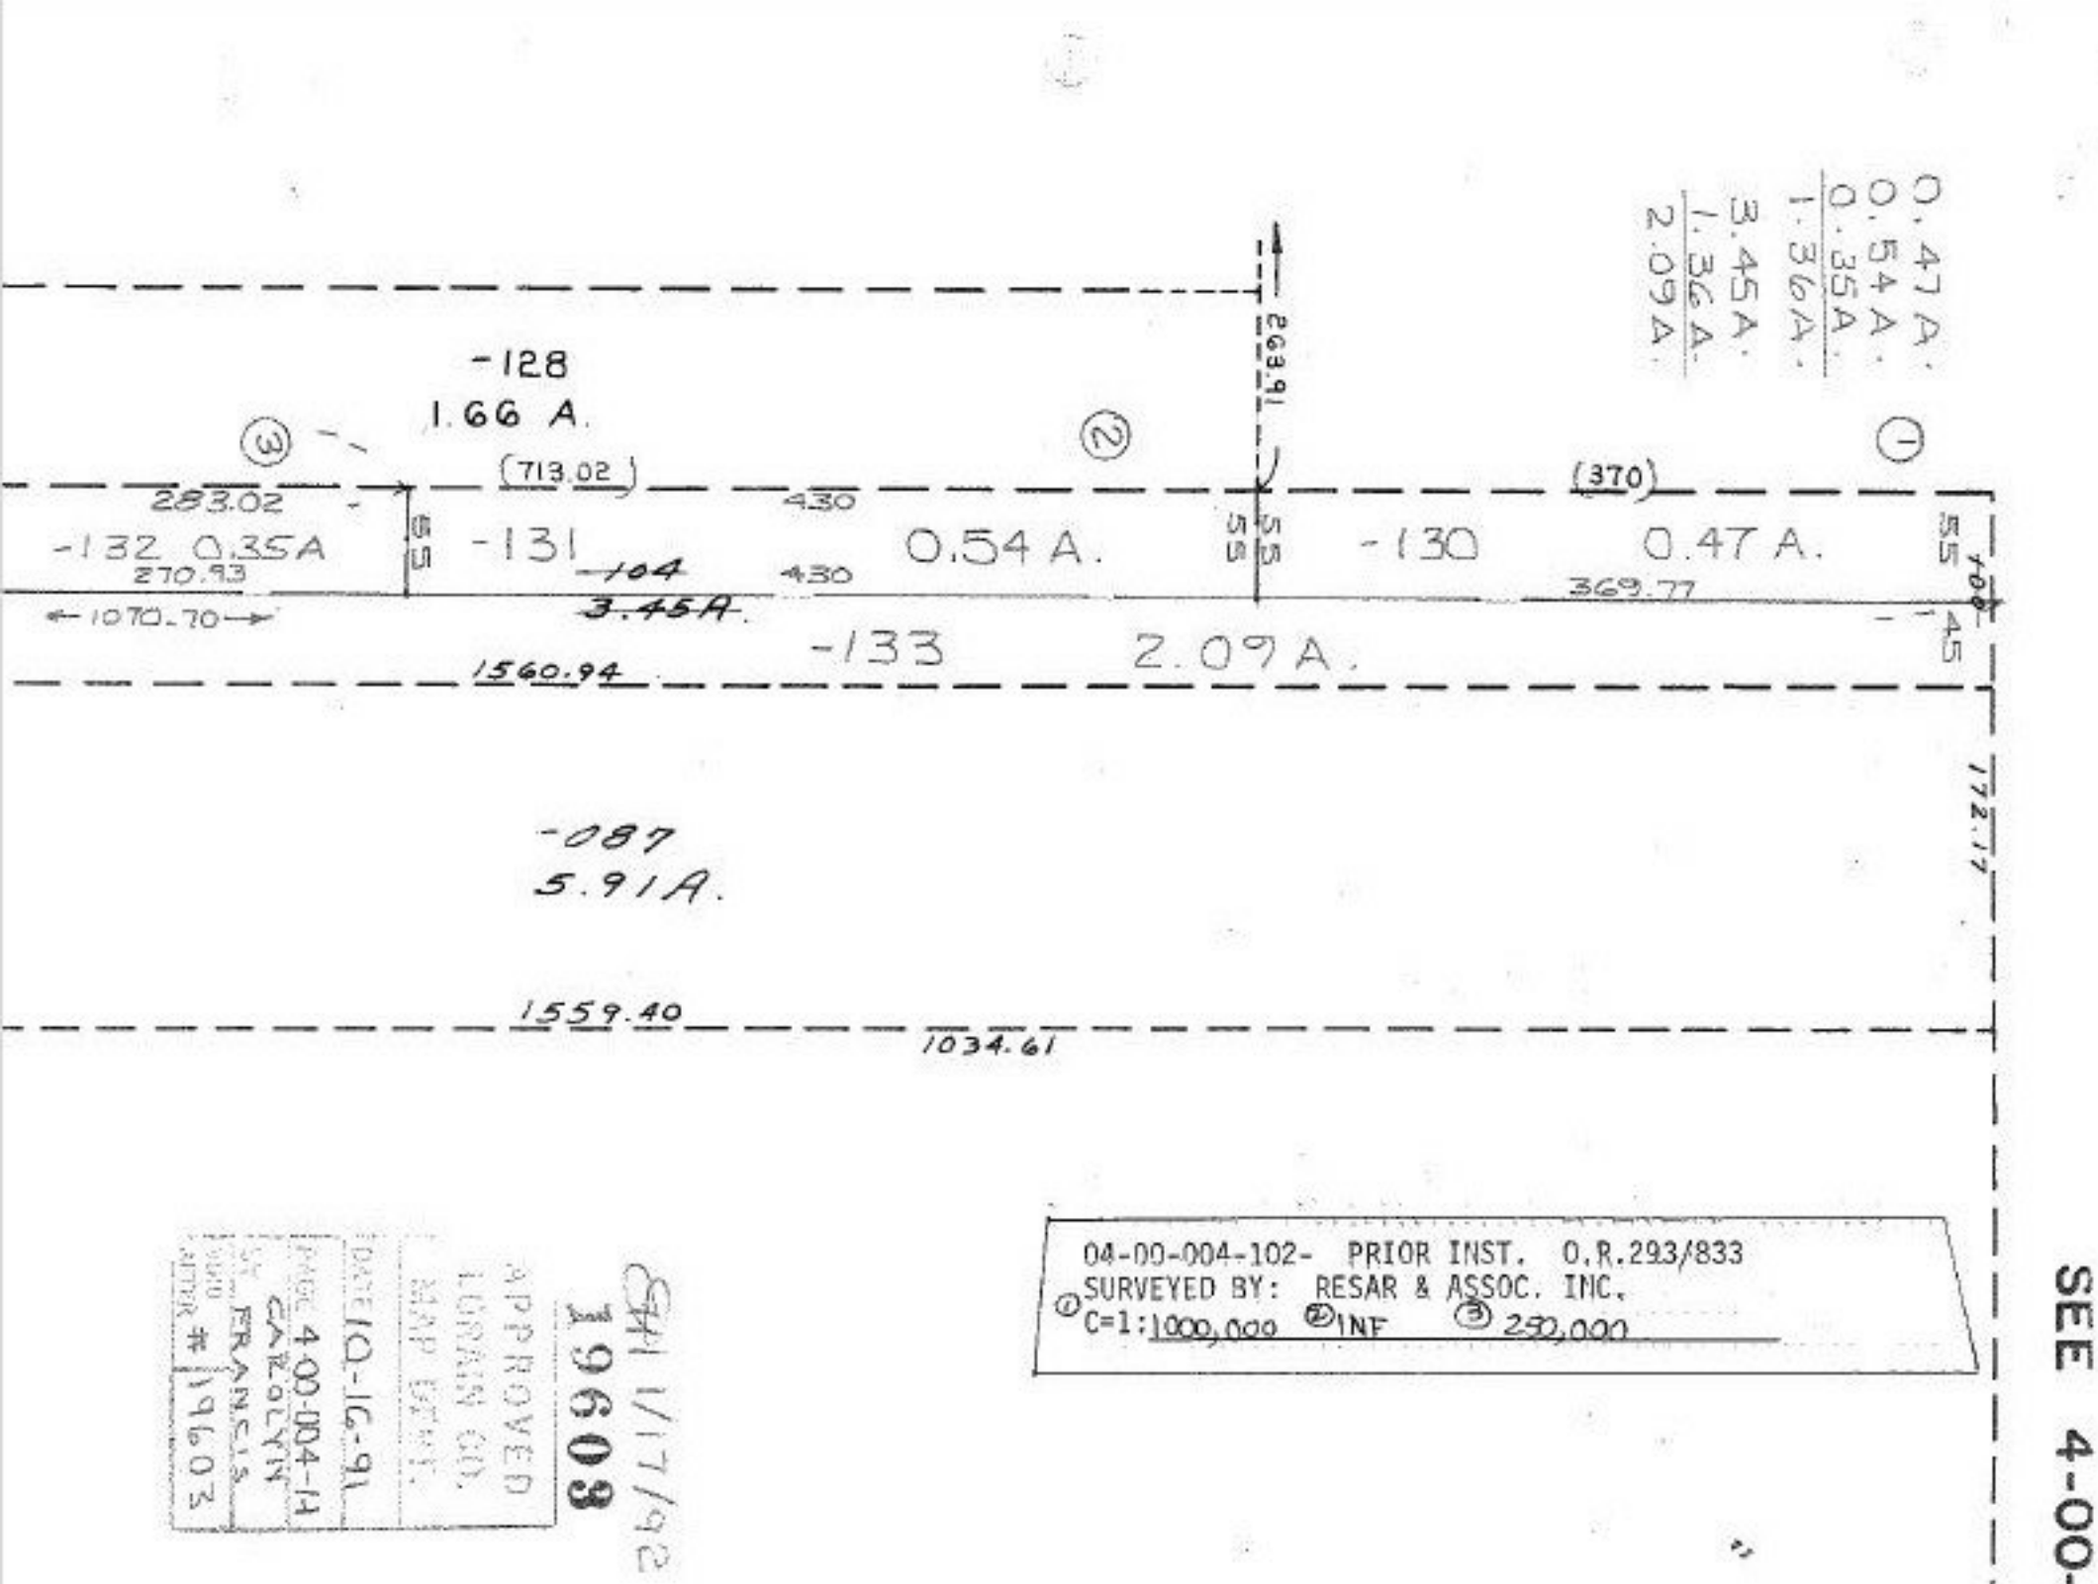
0.47 A.
0.54 A.
0.35 A.
1.36 A.
3.45 A.
1.36 A.
2.09 A.
-128
1.66 A.
③
②
①
(713.02)
(370)
293.02
430
263.91
55
55
55
-132 0.35A
270.93
-131
104
3.45A.
430
0.54 A.
-130
0.47 A.
369.77
104
45
1070.70
1560.94
-133
2.09 A.
772.17
-087
5.91A.
1559.40
1034.61
04-00-004-102- PRIOR INST. O.R.293/833
SURVEYED BY: RESAR & ASSOC. INC.
①C=1:1000,000 ②INF ③ 250,000
SEE 4-00-0(
APPROVED
LORAIN CO.
MAP DEPT.
DATE 10-16-91
PARCEL 4-00-004-1H
CAROLYN
ST. FRANCIS
WD
PLAT # 19603
19603
2/17/92