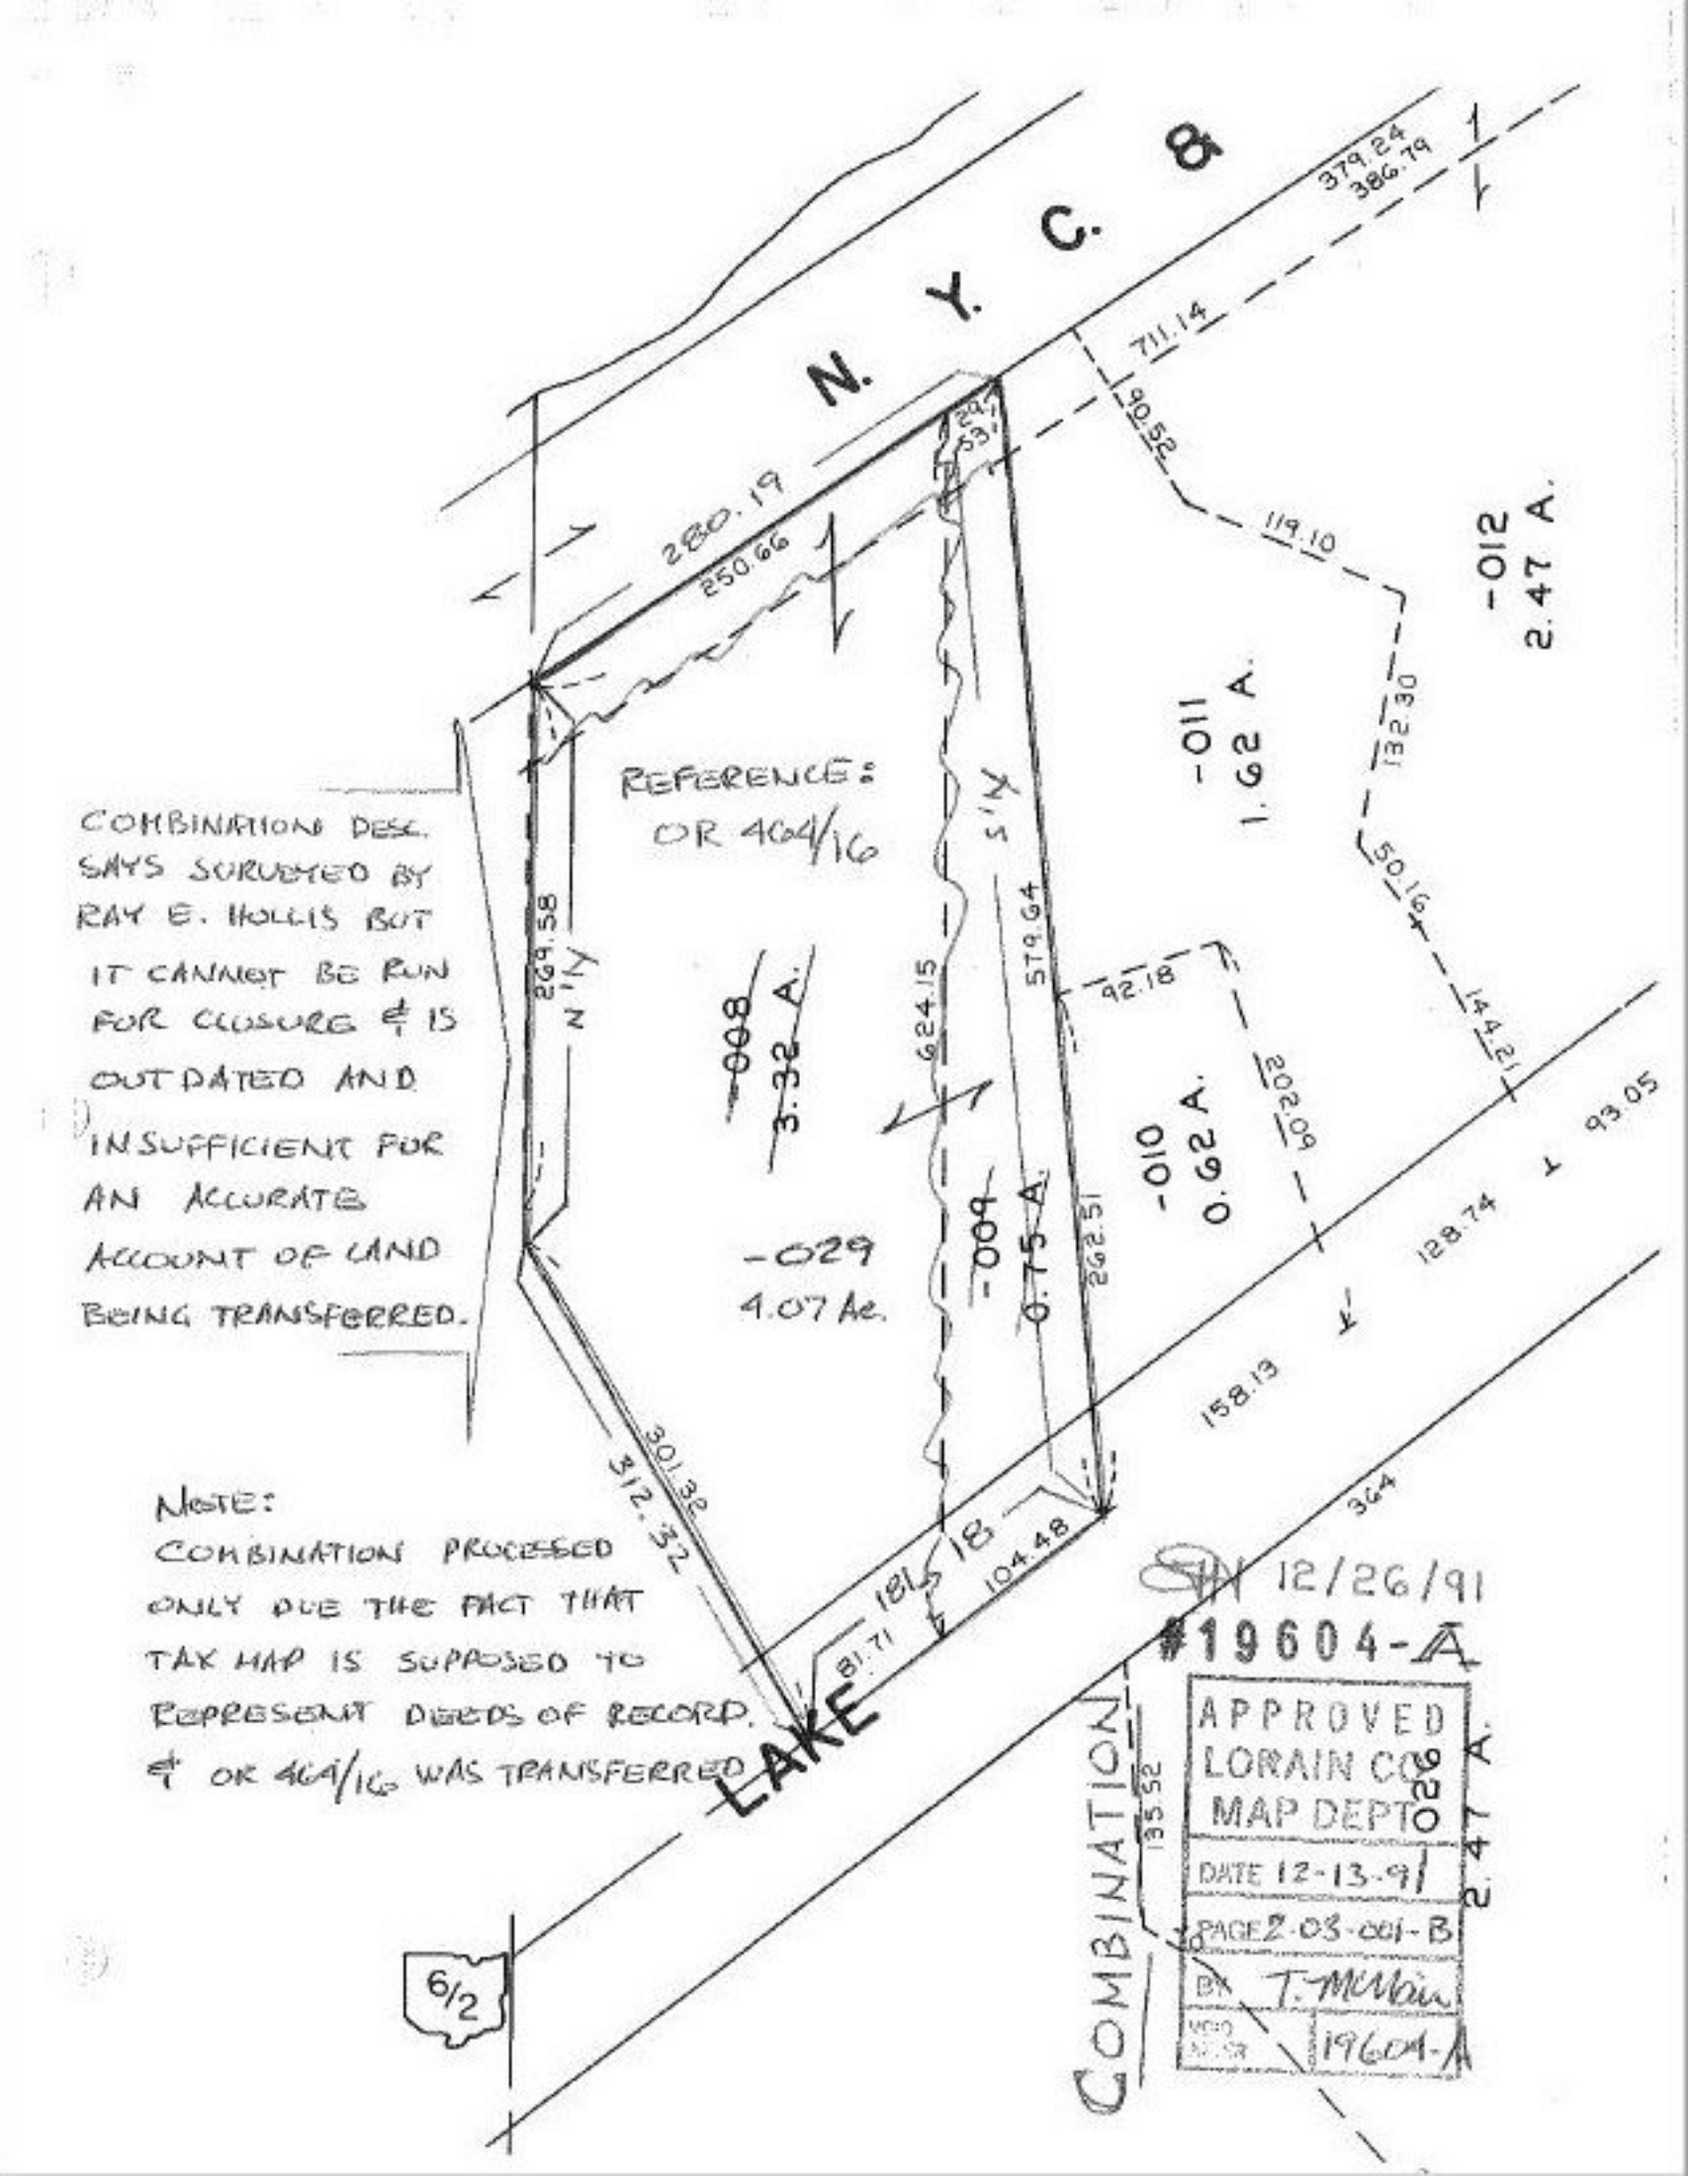
N. Y. C.
379.24
386.79
711.14
90.52
119.10
132.30
50.16
144.21
202.09
92.18
93.05
128.74
158.13
364
280.19
250.66
269.58
N 1° W
S 1° W
624.15
579.64
262.31
-012
2.47 A.
-011
1.62 A.
-010
0.62 A.
-009
0.75 A.
-008
3.32 A.
-029
4.07 Ac.
REFERENCE:
OR 464/16
COMBINATION DESC. SAYS SURVEYED BY RAY E. HOLLIS BUT IT CANNOT BE RUN FOR CLOSURE & IS OUTDATED AND INSUFFICIENT FOR AN ACCURATE ACCOUNT OF LAND BEING TRANSFERRED.
NOTE:
COMBINATION PROCESSED ONLY DUE THE FACT THAT TAX MAP IS SUPPOSED TO REPRESENT DEEDS OF RECORD. & OR 464/16 WAS TRANSFERRED
30.32
312.32
81.71
181.18
104.48
LAKE
6/2
COMBINATION
135.52
2.47 A.
12/26/91
#19604-A
APPROVED
LORAIN CO
MAP DEPT
029
DATE 12-13-91
PAGE 2-03-001-B
BY T. McMain
VOID AFTER 19604-A