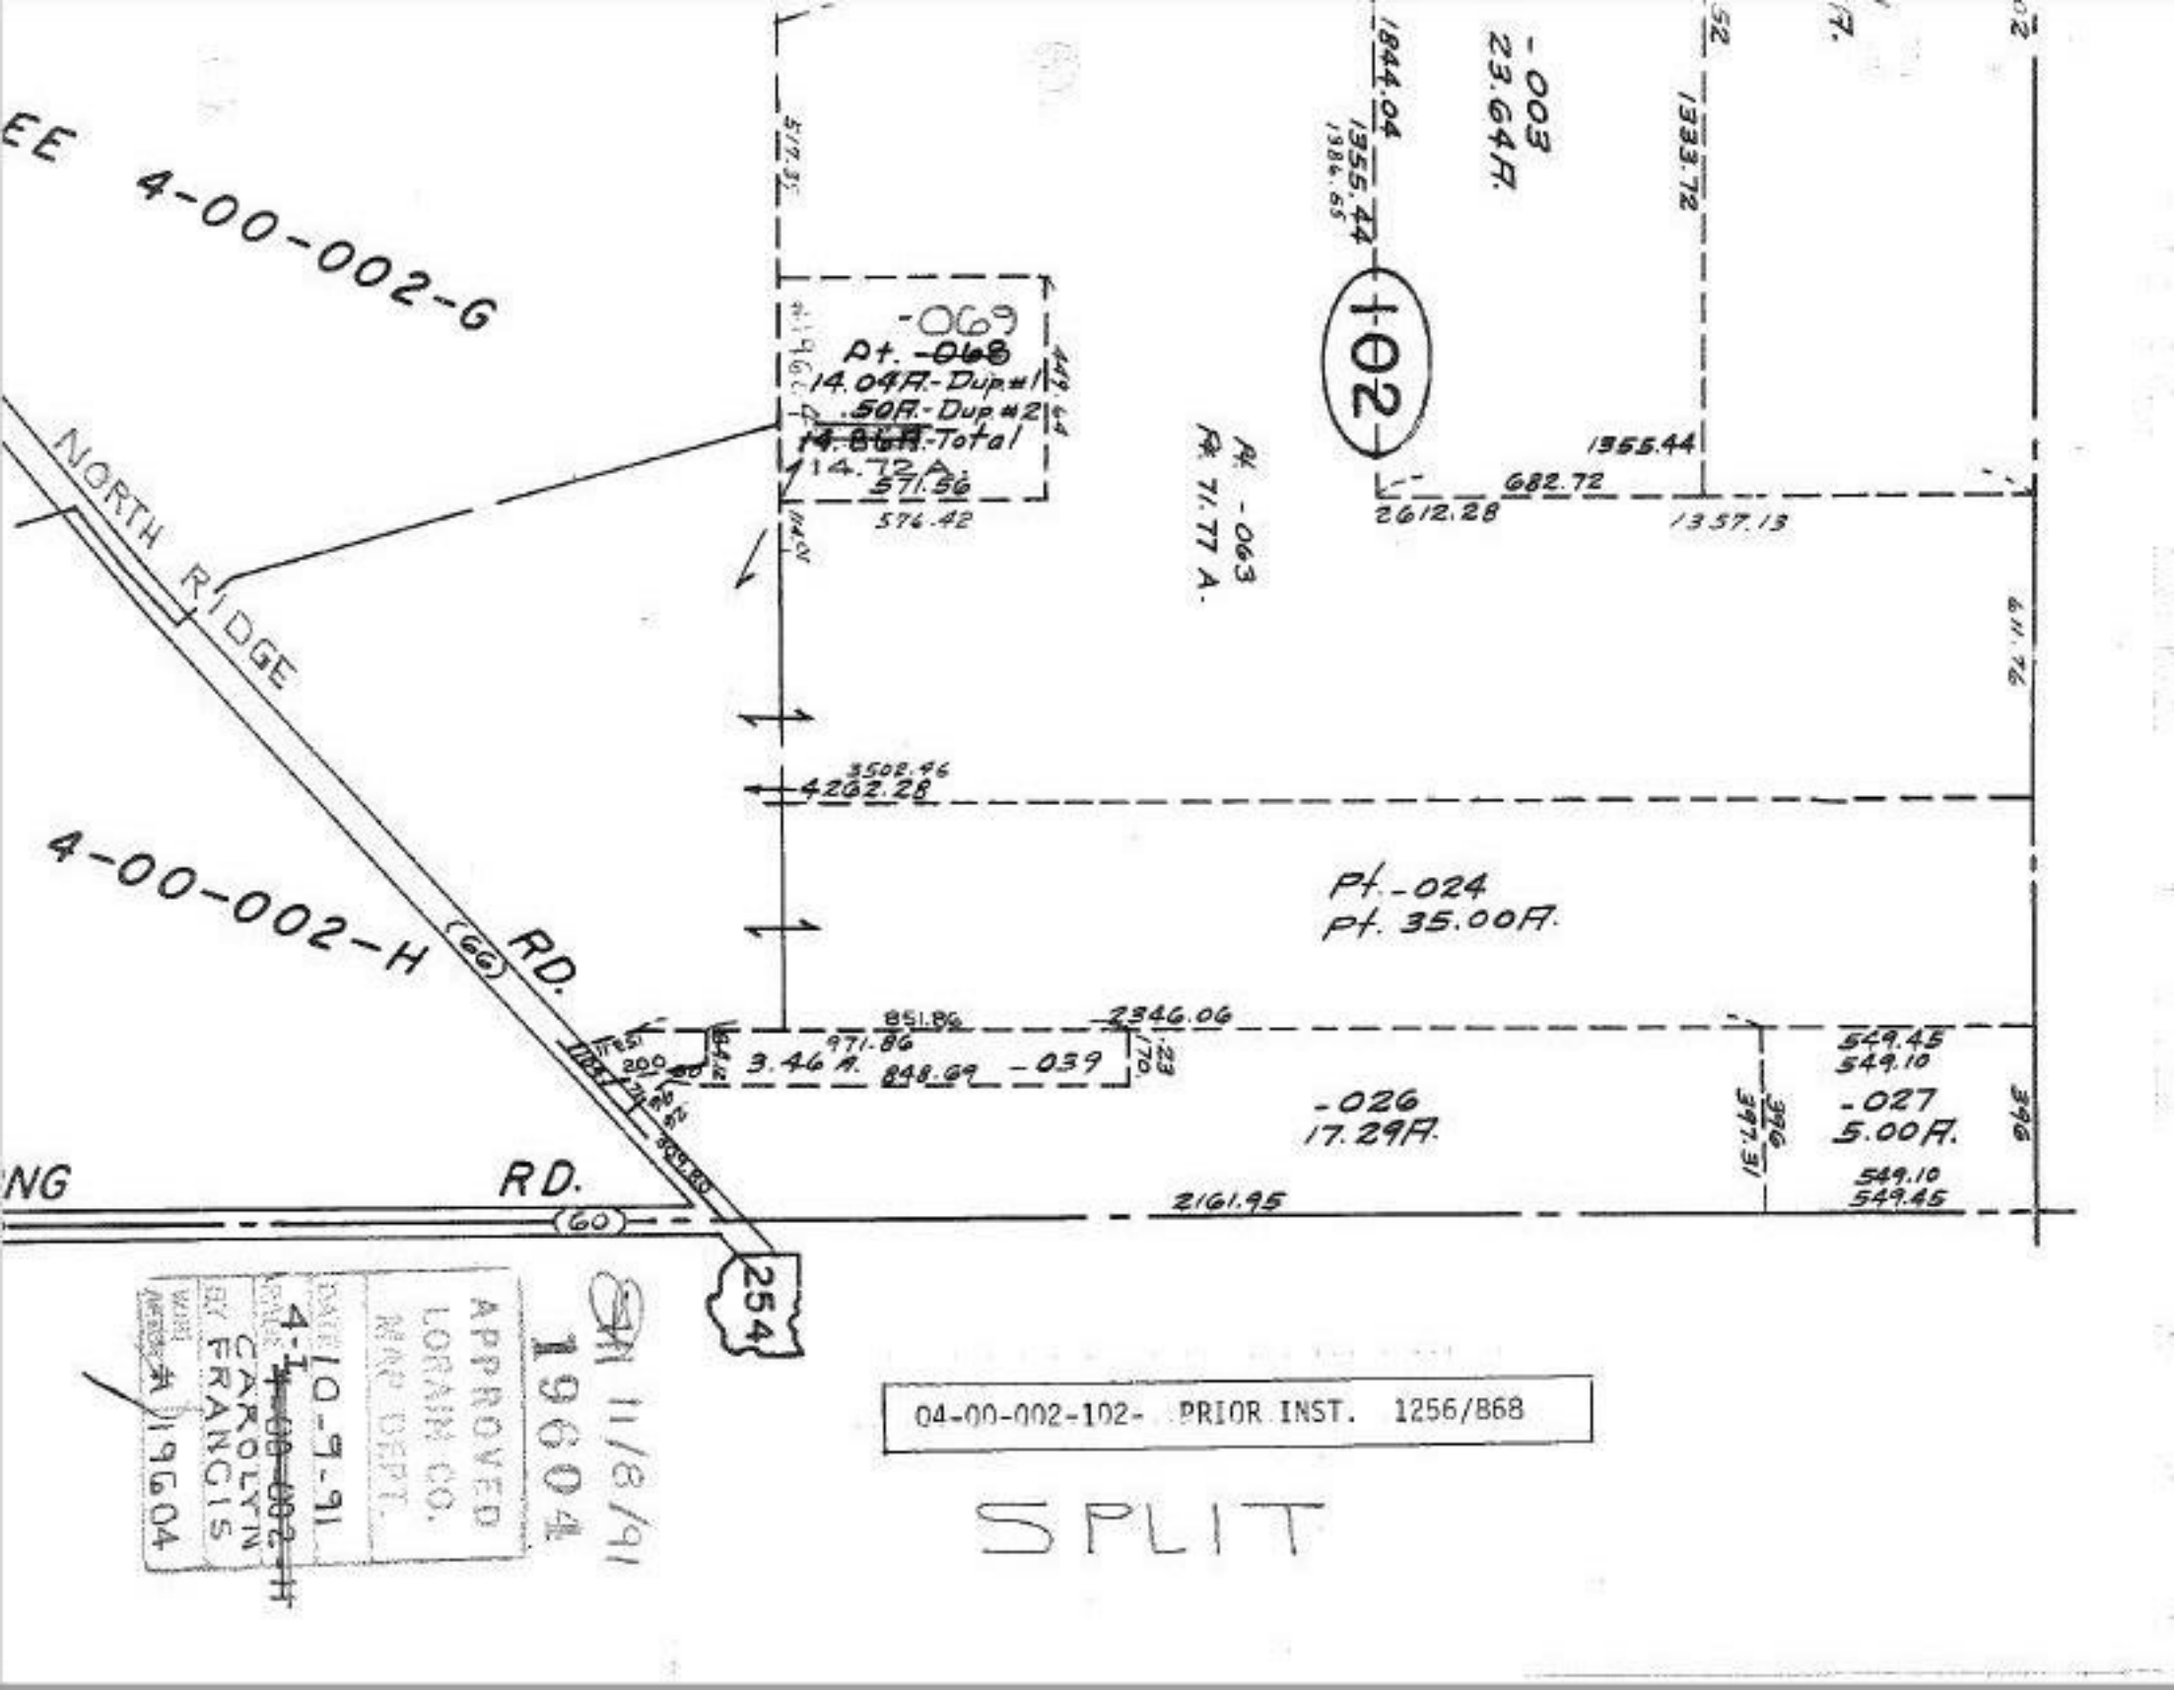
EE 4-00-002-G
NORTH RIDGE
4-00-002-H
RD.
(66)
NG
RD.
(60)
254
-069
Pt. -068
14.04A.-Dup#1
.50A.-Dup#2
14.54A.-Total
14.72A.
571.56
576.42
Pt. -063
Pt. 71.77 A.
-003
23.64A.
1844.04
1355.44
1333.72
1955.44
682.72
2612.28
1357.13
3502.96
4202.28
Pt.-024
Pt. 35.00A.
851.86
971.86
3.46 A.
848.69
-039
2346.06
-026
17.29A.
549.45
549.10
-027
5.00A.
2161.95
APPROVED
LORAIN CO.
MAP DEPT.
DATE 10-9-91
4-1
CAROLYN
BY FRANCIS
11/8/91
19604
04-00-002-102- PRIOR INST. 1256/868
SPLIT