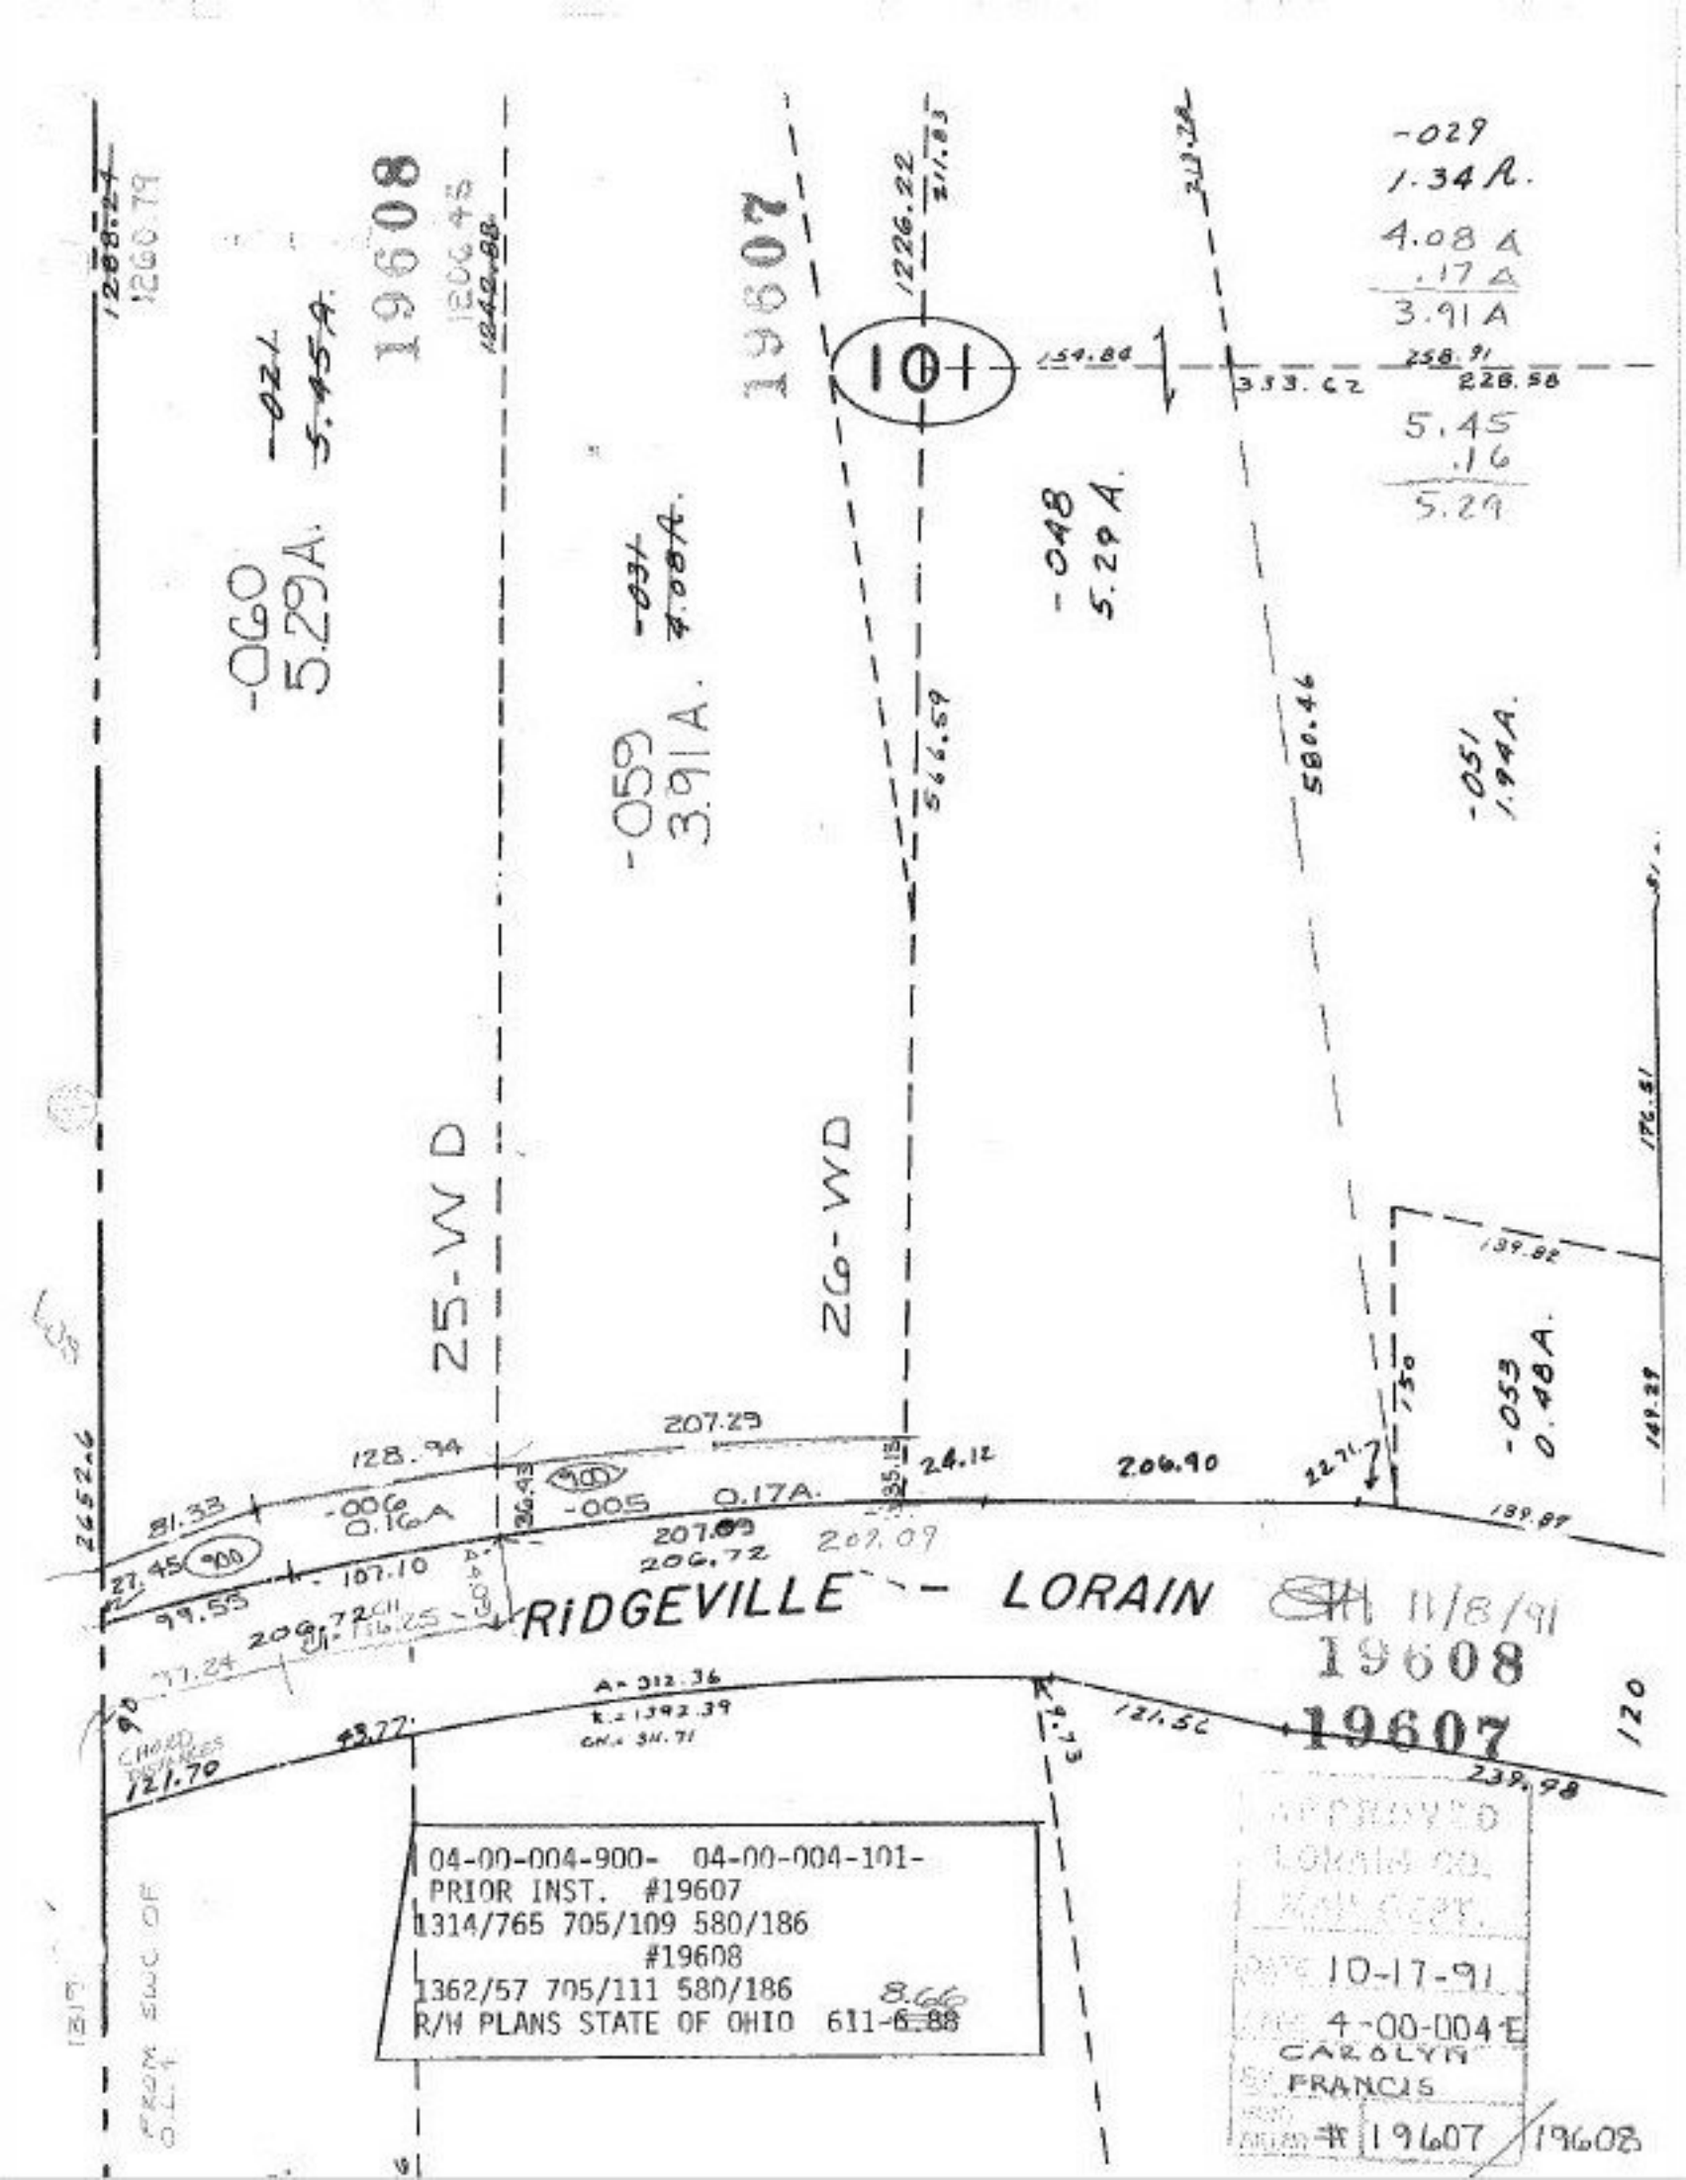

04-00-004-900- 04-00-004-101-
PRIOR INST. #19607
1314/765 705/109 580/186
#19608
1362/57 705/111 580/186
R/W PLANS STATE OF OHIO 611-~~6.88~~ 8.66

APPROVED
LORAIN CO.
MAIL DEPT.
DATE 10-17-91
4-00-004-E
CAROLYN
FRANCIS
19607 / 19608