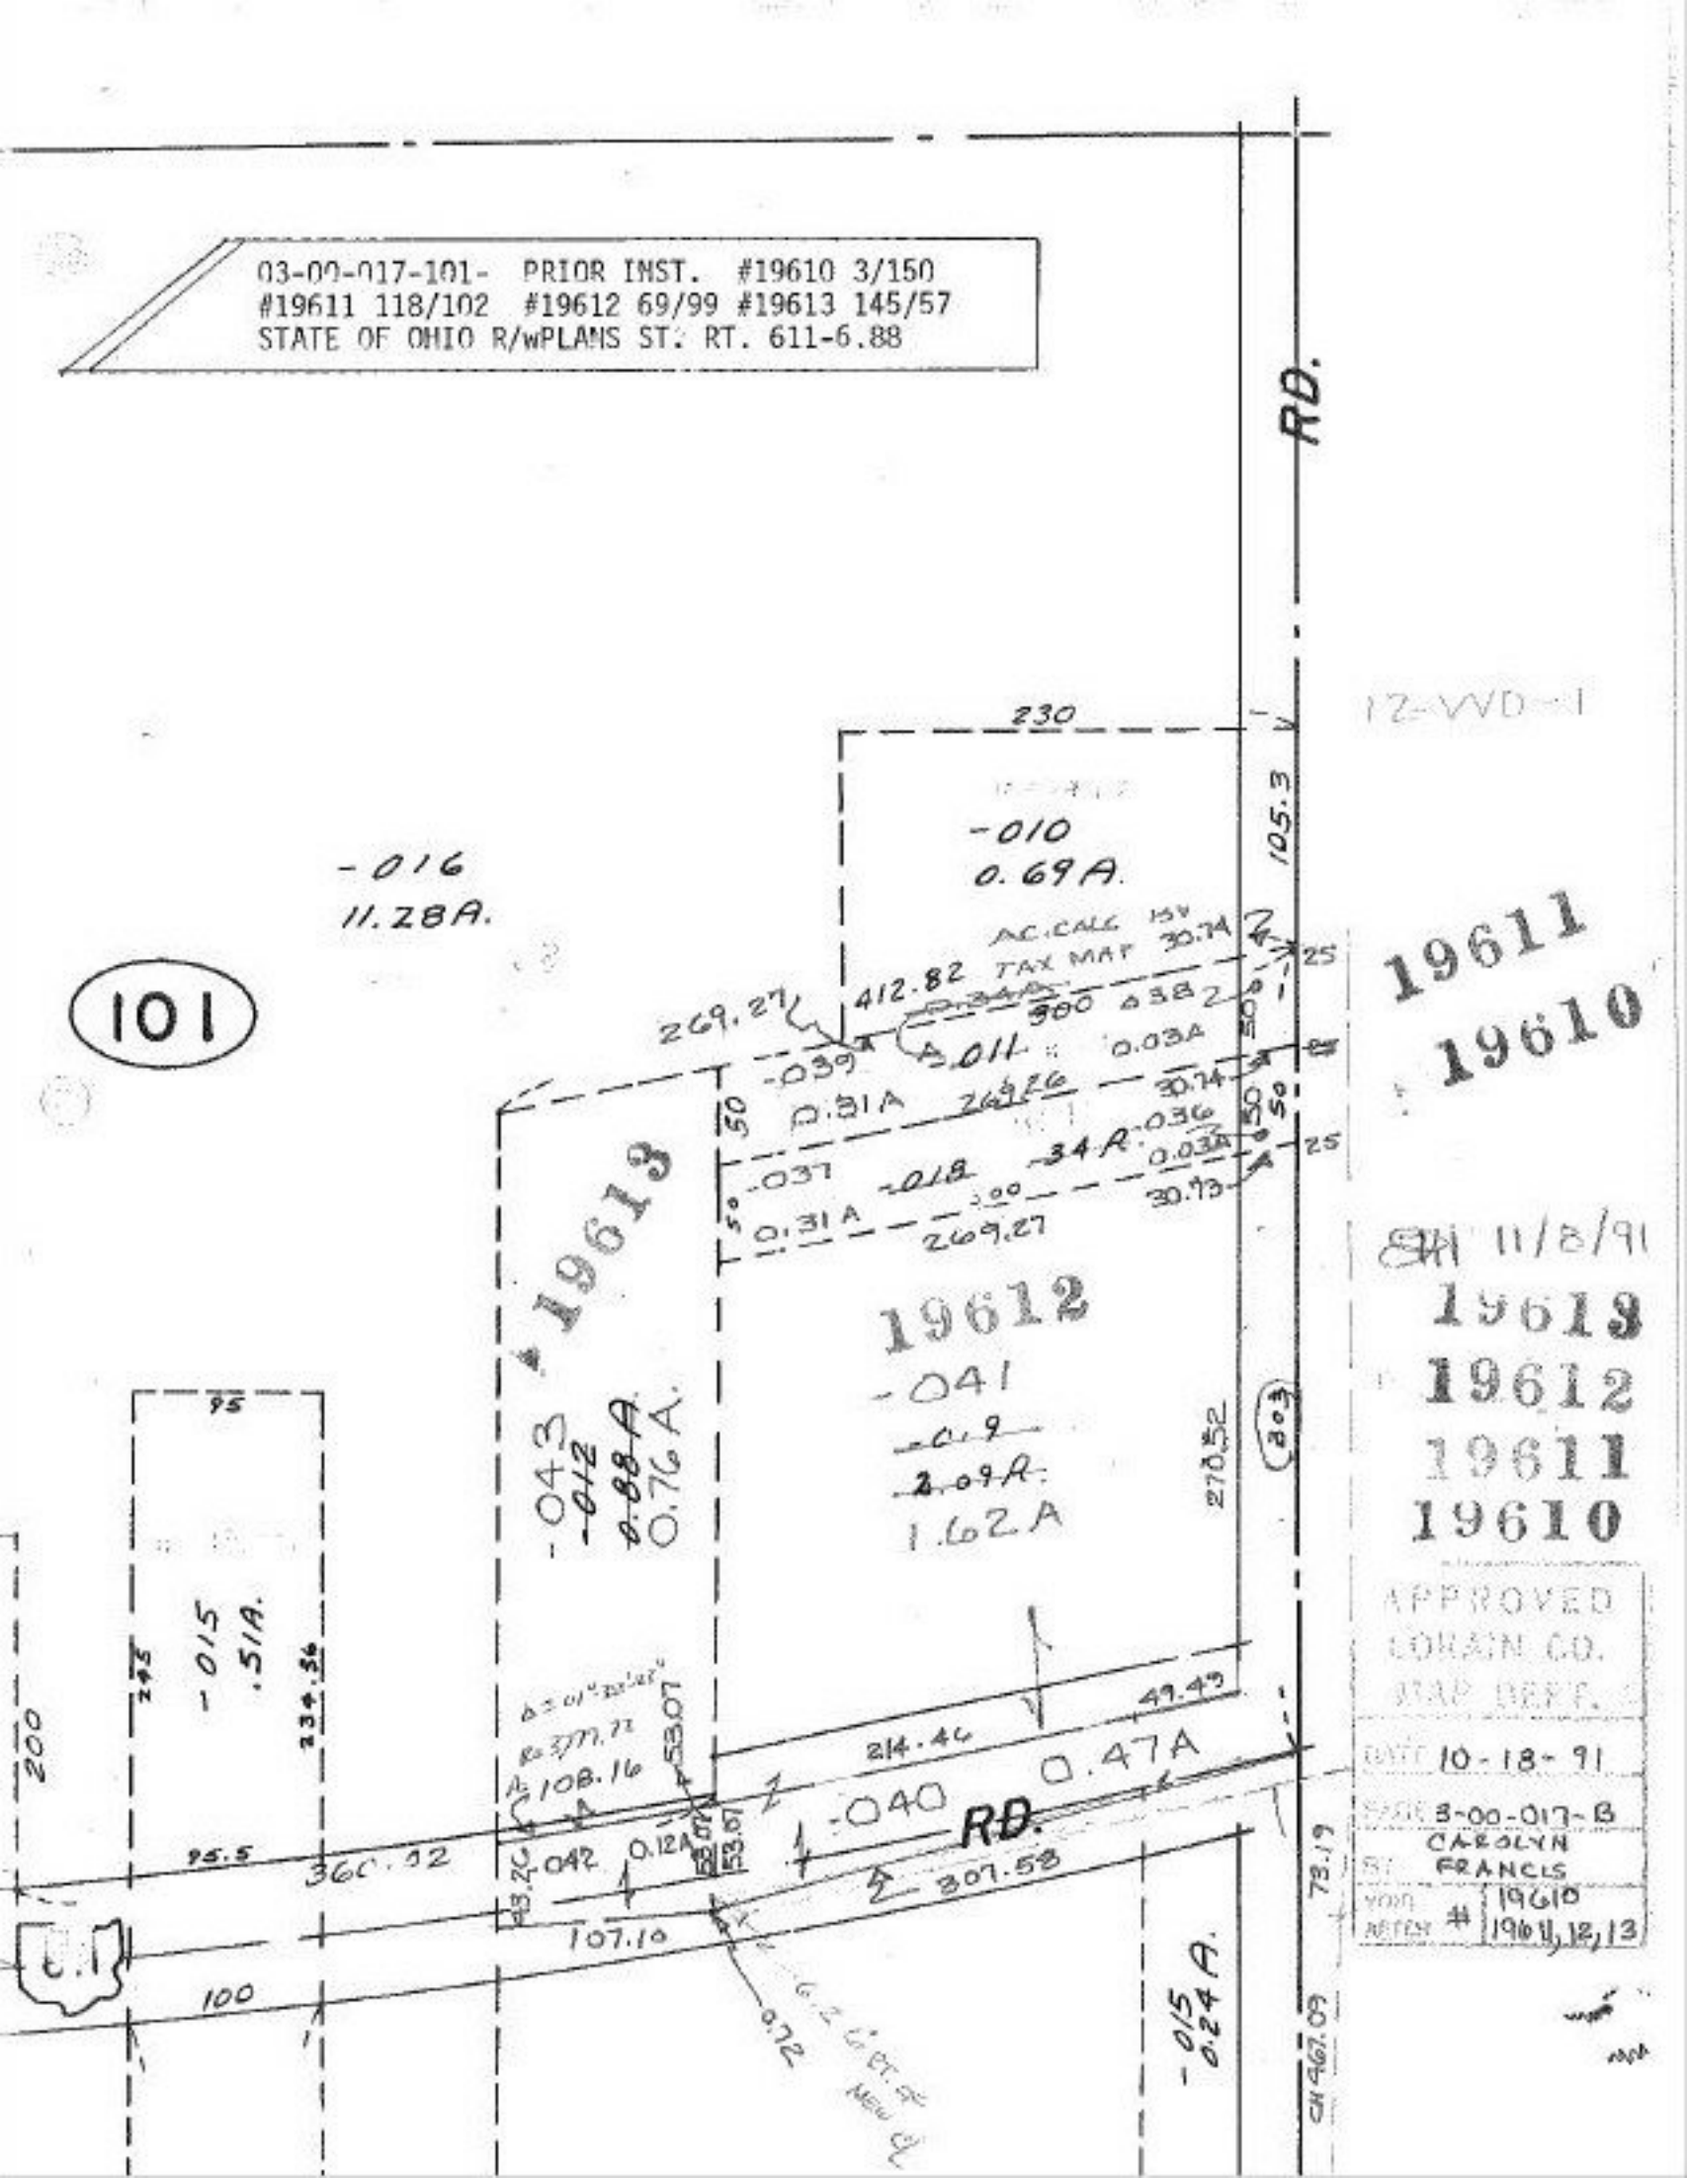
03-00-017-101- PRIOR INST. #19610 3/150
#19611 118/102 #19612 69/99 #19613 145/57
STATE OF OHIO R/wPLANS ST. RT. 611-6.88
RD.
230
105.3
-010
0.69A.
-016
11.28A.
101
AC. CALC
TAX MAP
412.82
269.27
-039
0.31A
-037
0.31A
269.27
-041
1.62A
19613
-043
-012
0.76A.
19612
19611
19610
270.52
(303)
-015
.51A.
200
95
95.5
360.12
-040
0.47A
RD.
214.46
49.43
307.58
107.10
100
73.19
-015
0.24A.
CH 467.09
APPROVED
MAP DEPT.
DATE 10-18-91
BY CAROLYN FRANCIS
PARCEL # 19610
19611, 12, 13