SEE 3-00-008-A

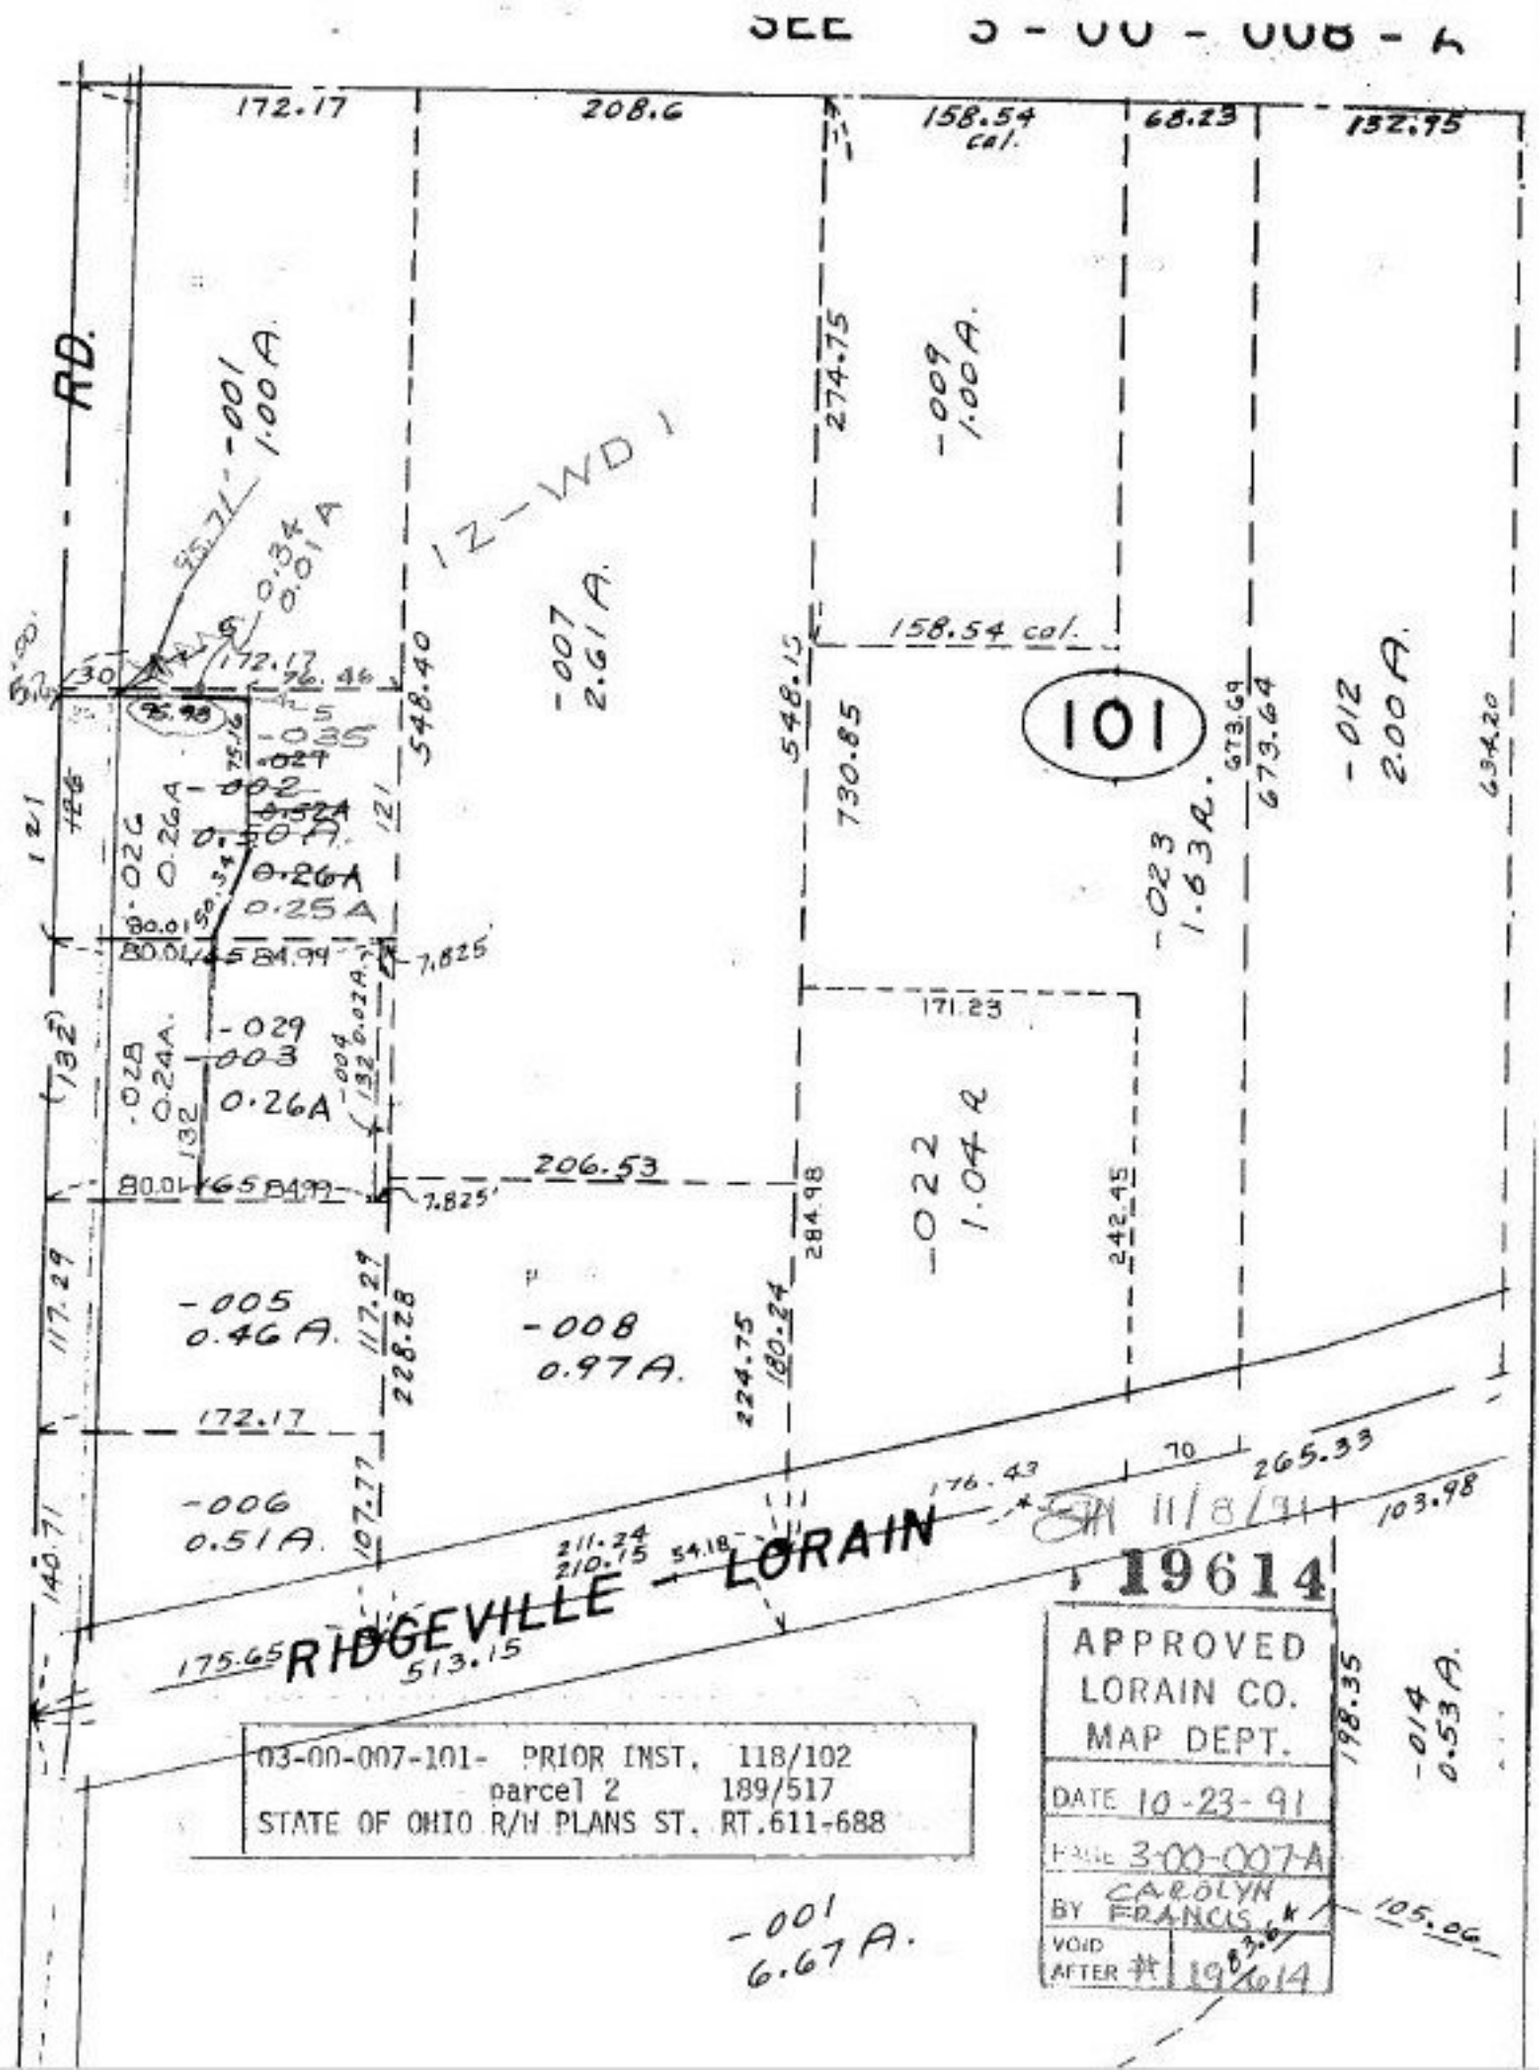

03-00-007-101- PRIOR INST. 118/102
parcel 2 189/517
STATE OF OHIO R/W PLANS ST. RT.611-688

19614

APPROVED
LORAIN CO.
MAP DEPT.
DATE 10-23-91
PAGE 3-00-007-A
BY CAROLYN FRANCIS
VOID AFTER # 19614