SEE 3-00-008-A

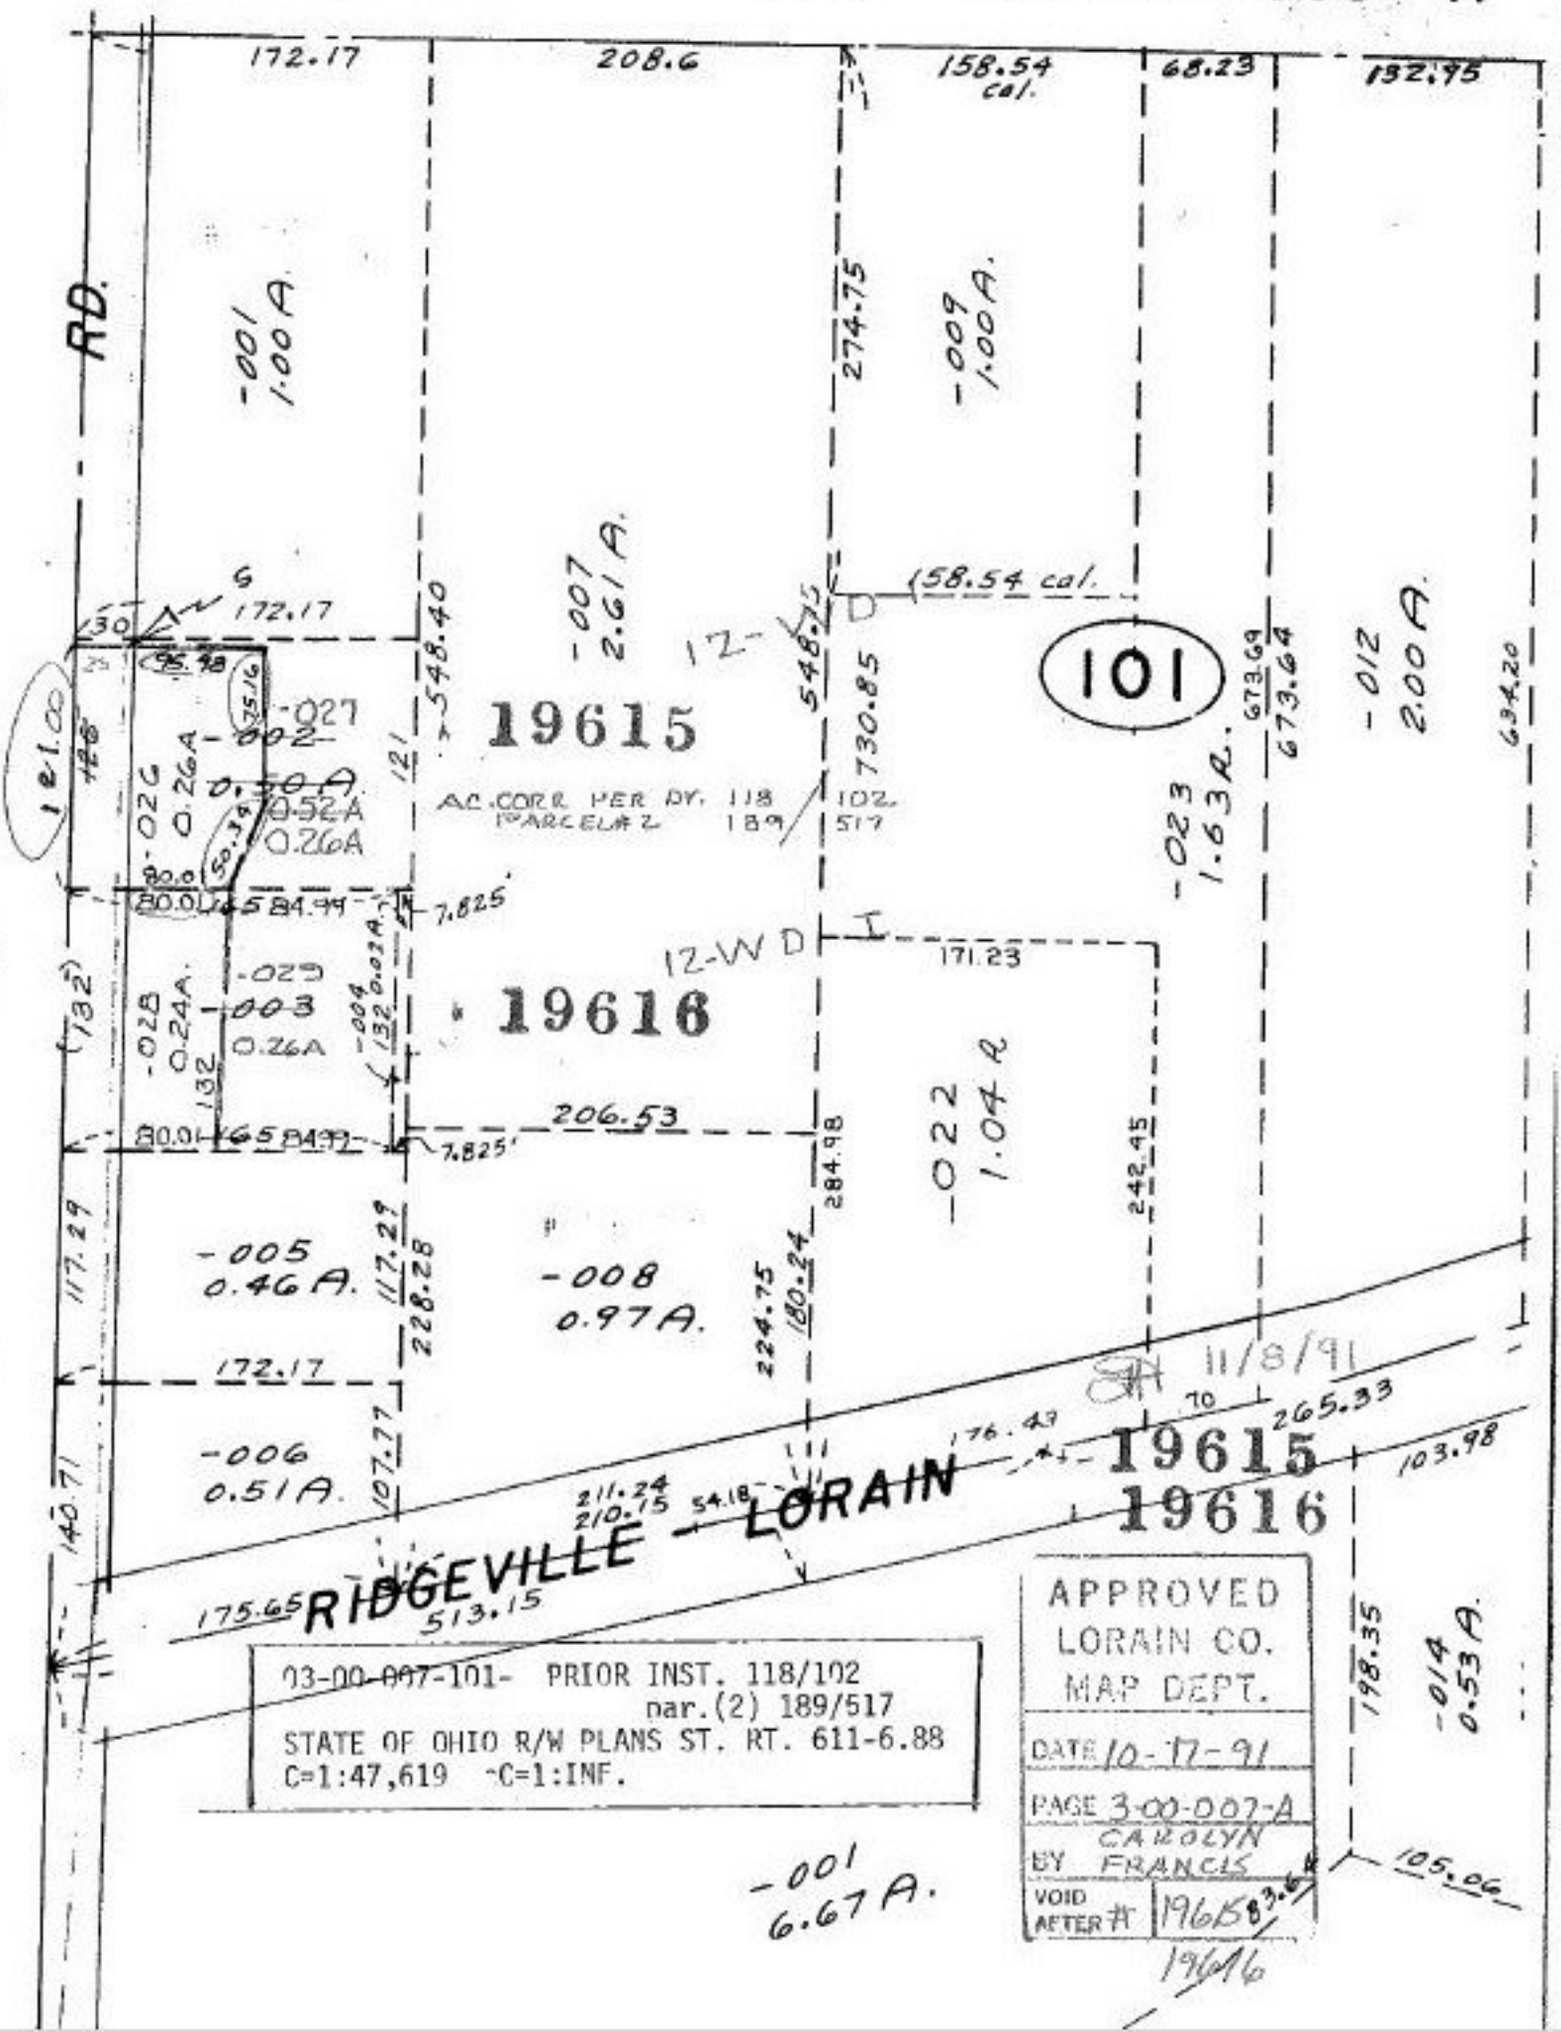

03-00-007-101- PRIOR INST. 118/102
par.(2) 189/517
STATE OF OHIO R/W PLANS ST. RT. 611-6.88
C=1:47,619 -C=1:INF.

APPROVED
LORAIN CO.
MAP DEPT.
DATE 10-17-91
PAGE 3-00-007-A
BY CAROLYN FRANCIS
VOID AFTER # 19615 83.67
19616