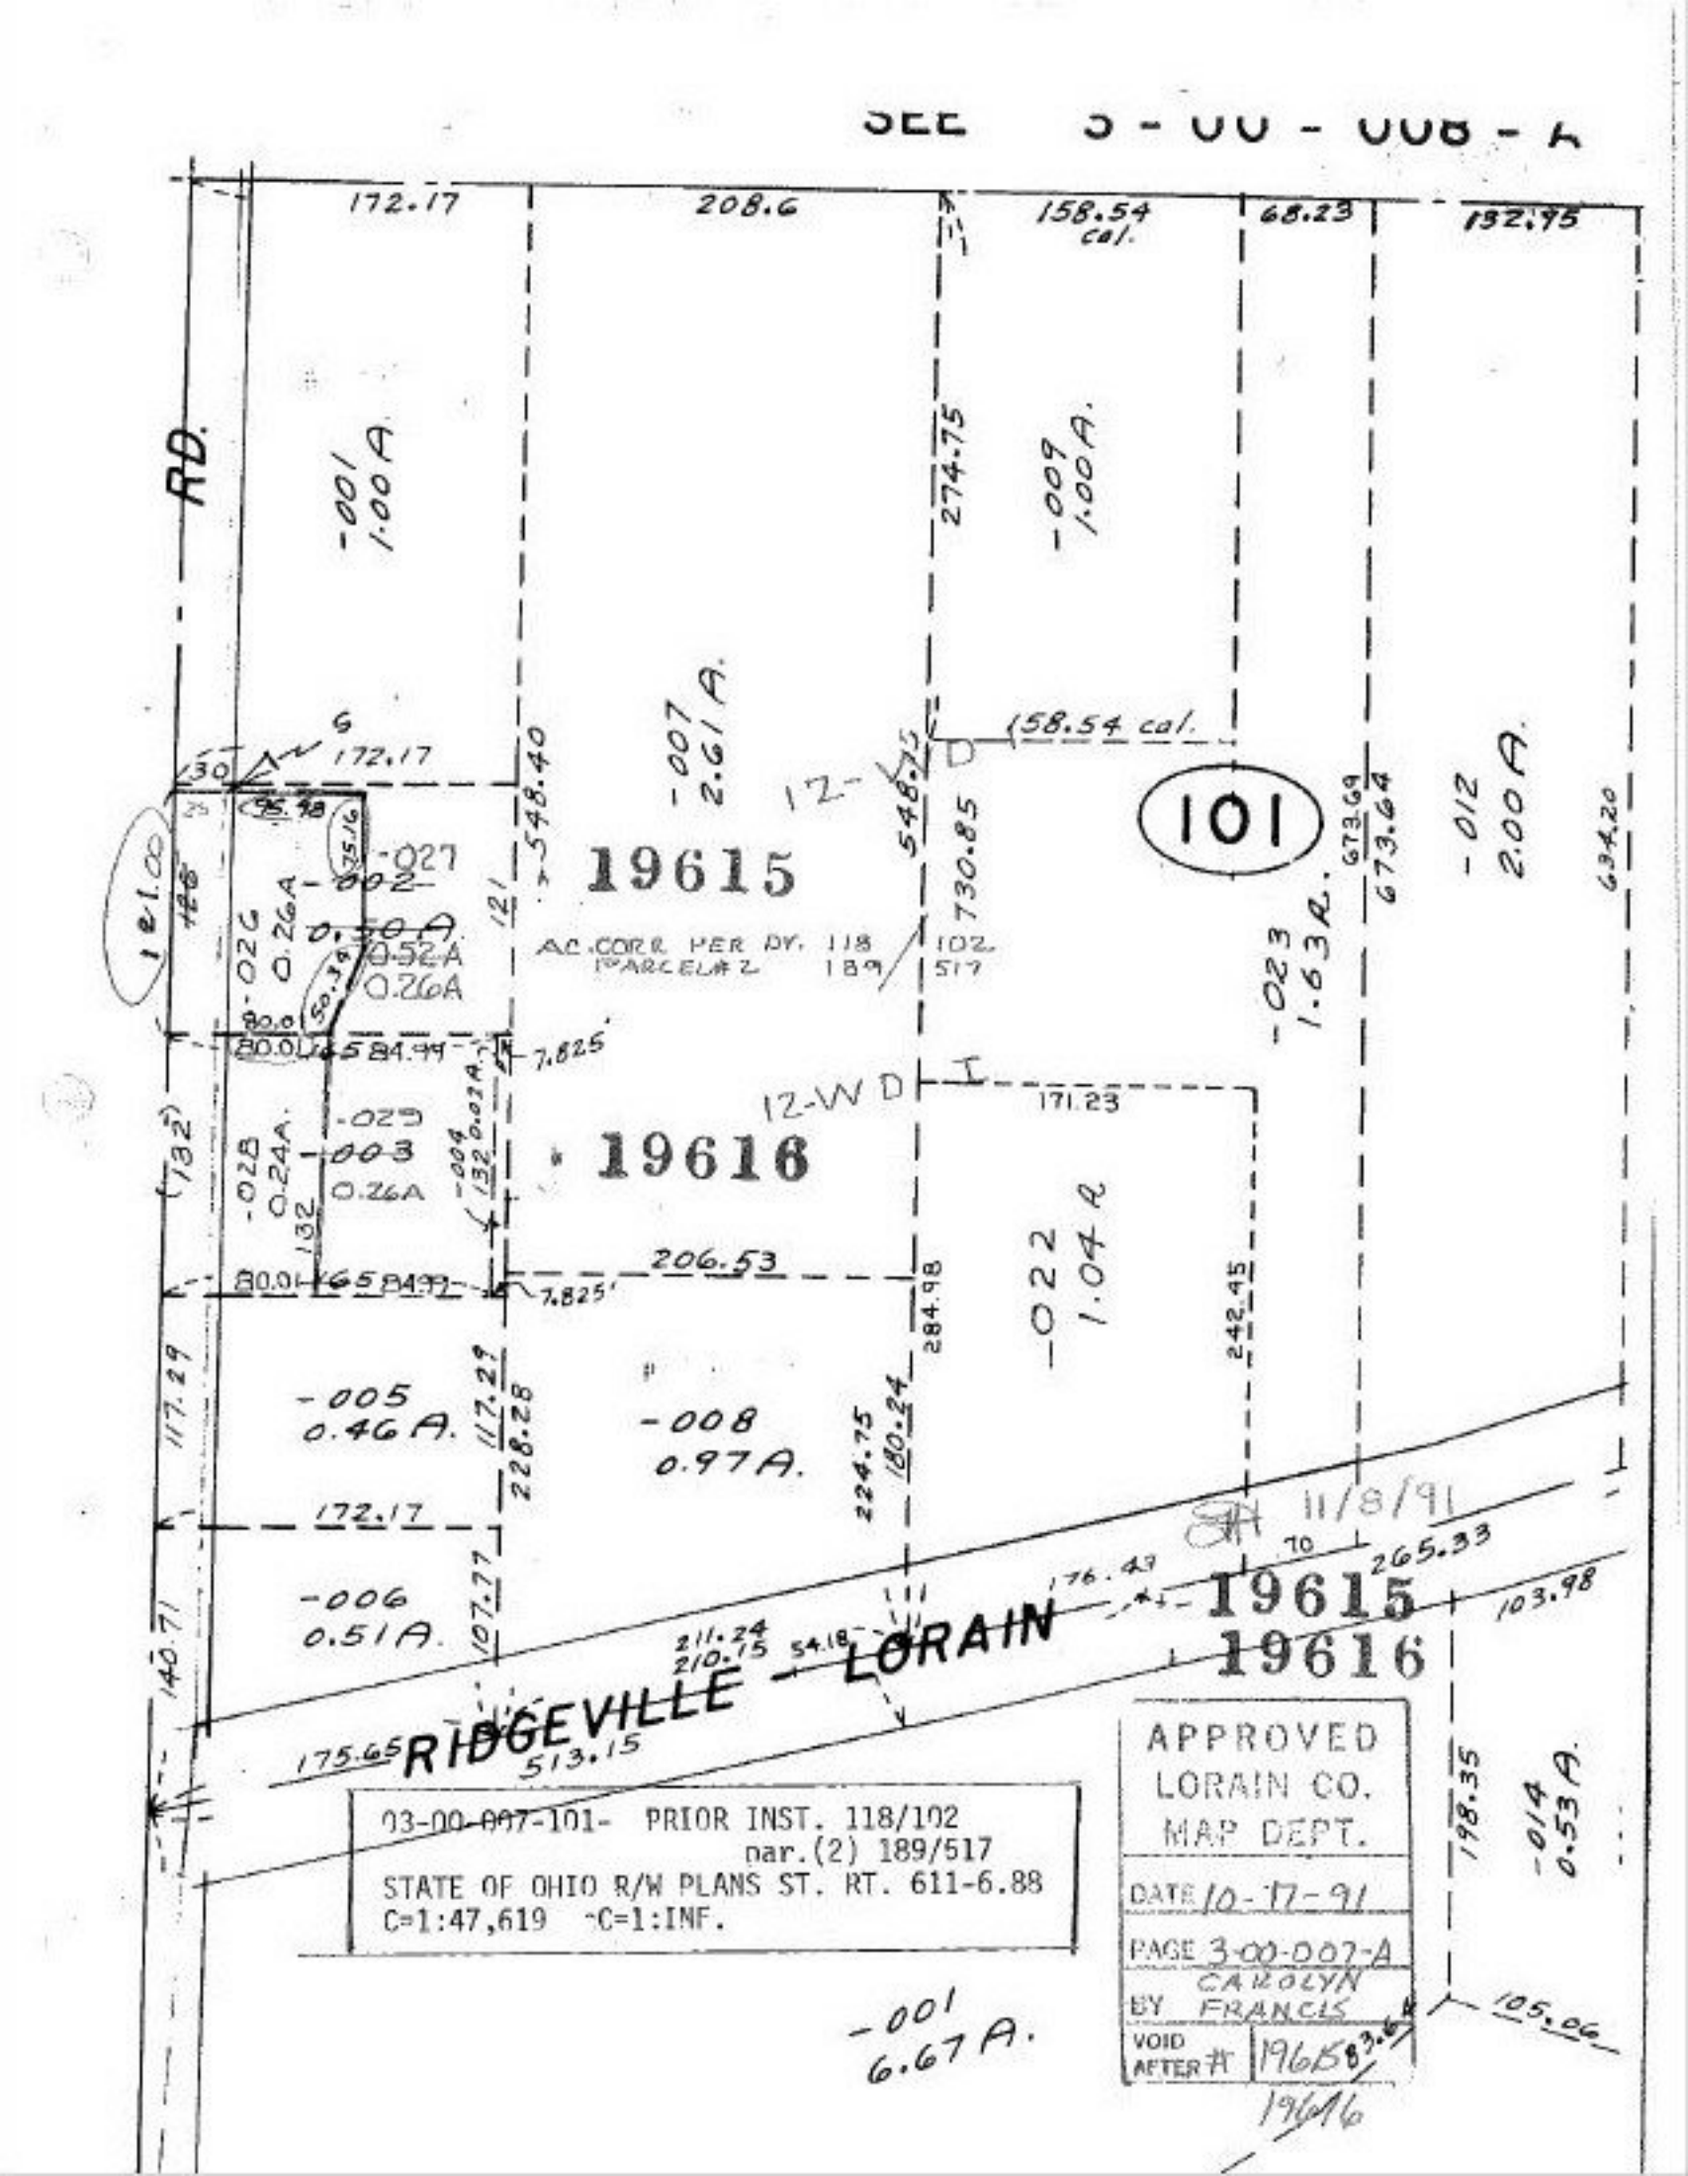
SEC 3 - 00 - 008 - A
172.17
208.6
158.54 col.
68.23
132.75
RD.
-001 1.00A.
-009 1.00A.
274.75
-007 2.61A.
548.40
548.75
730.85
158.54 col.
101
673.69
673.64
-012 2.00A.
634.20
-027
-002
0.50A.
0.52A
0.26A
-026 0.26A
AC. CORR PER DY. 118 102
PARCEL#2 189 517
19615
-023 1.63A.
12-WD
7.825
-028 0.24A.
-029
-003 0.26A
-004 0.027A.
19616
171.23
206.53
-022 1.04A
284.98
242.45
-005 0.46A.
117.29
228.28
-008 0.97A.
224.75
180.24
172.17
-006 0.51A.
107.77
140.71
211.24
210.15
54.18
513.15
175.65
RIDGEVILLE - LORAIN
11/8/91
70
265.33
176.43
103.98
19615
19616
198.35
-014 0.53A.
105.06
-001 6.67A.
03-00-007-101- PRIOR INST. 118/102
par.(2) 189/517
STATE OF OHIO R/W PLANS ST. RT. 611-6.88
C=1:47,619 ~C=1:INF.
APPROVED
LORAIN CO.
MAP DEPT.
DATE 10-17-91
PAGE 3-00-007-A
BY CAROLYN FRANCIS
VOID AFTER # 19615 83.67
19616