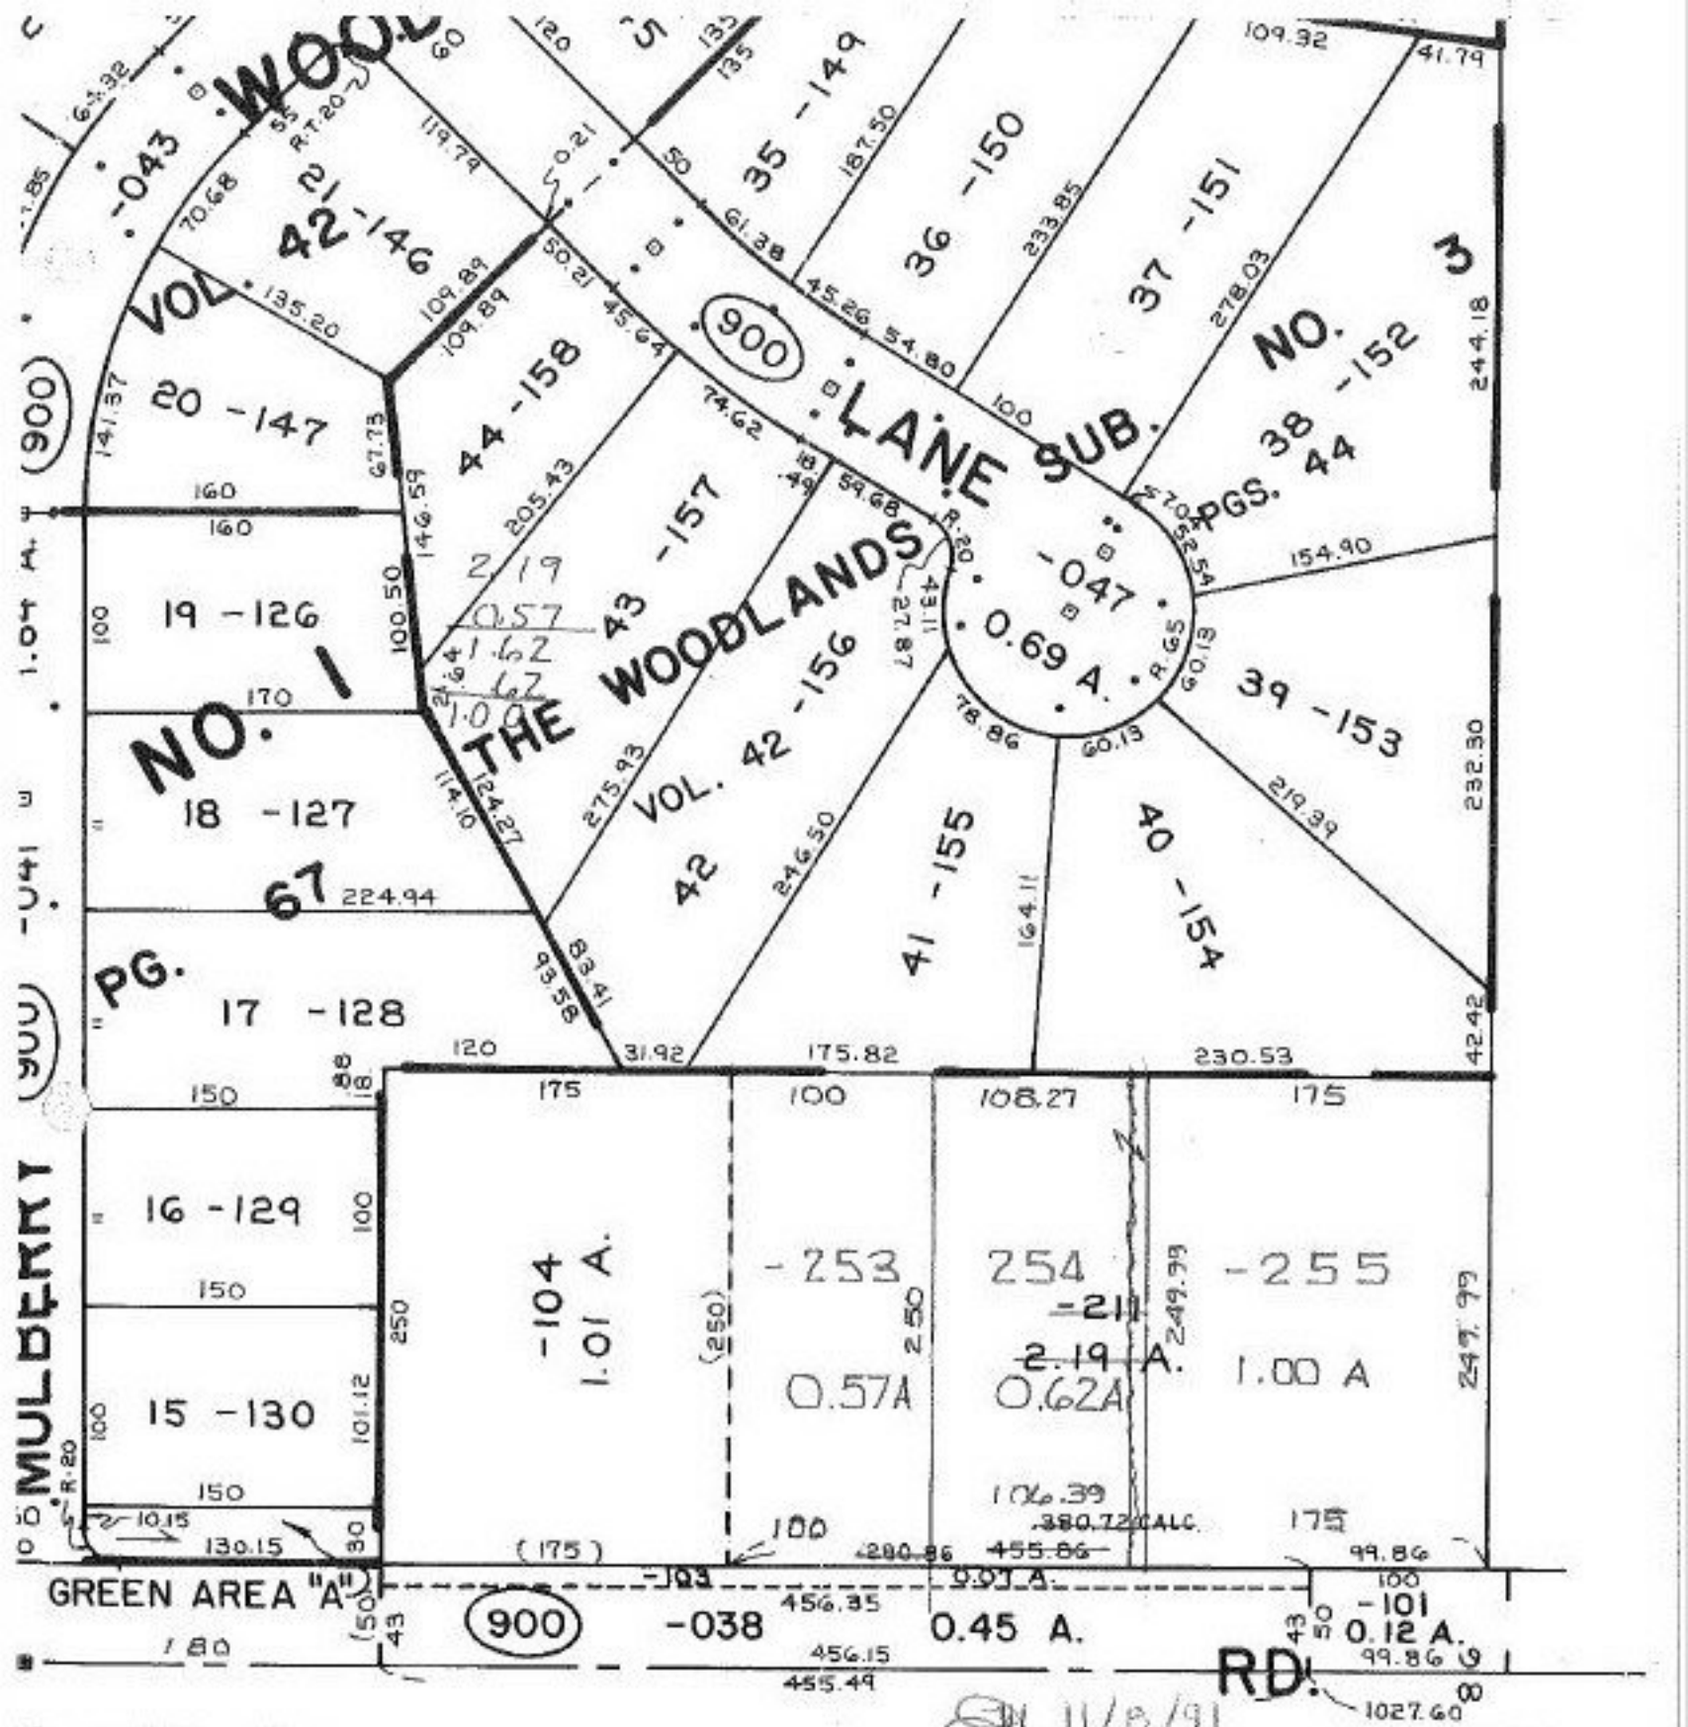

0-020-C

19618

~~[illegible] PRIOR INST.~~

04-00-019-144- PRIOR INST. 1409/782 1391/252
SURVEYED BY: KS ASSOC.
@ C=1: 1NF (2) 142,857 (3) 1NF

APPROVED
LORAIN CO.
MAP DEPT.

DATE 10-21-91
PAGE 4-00-019 K
BY CAROLYN FRANCIS
VOID # 19618