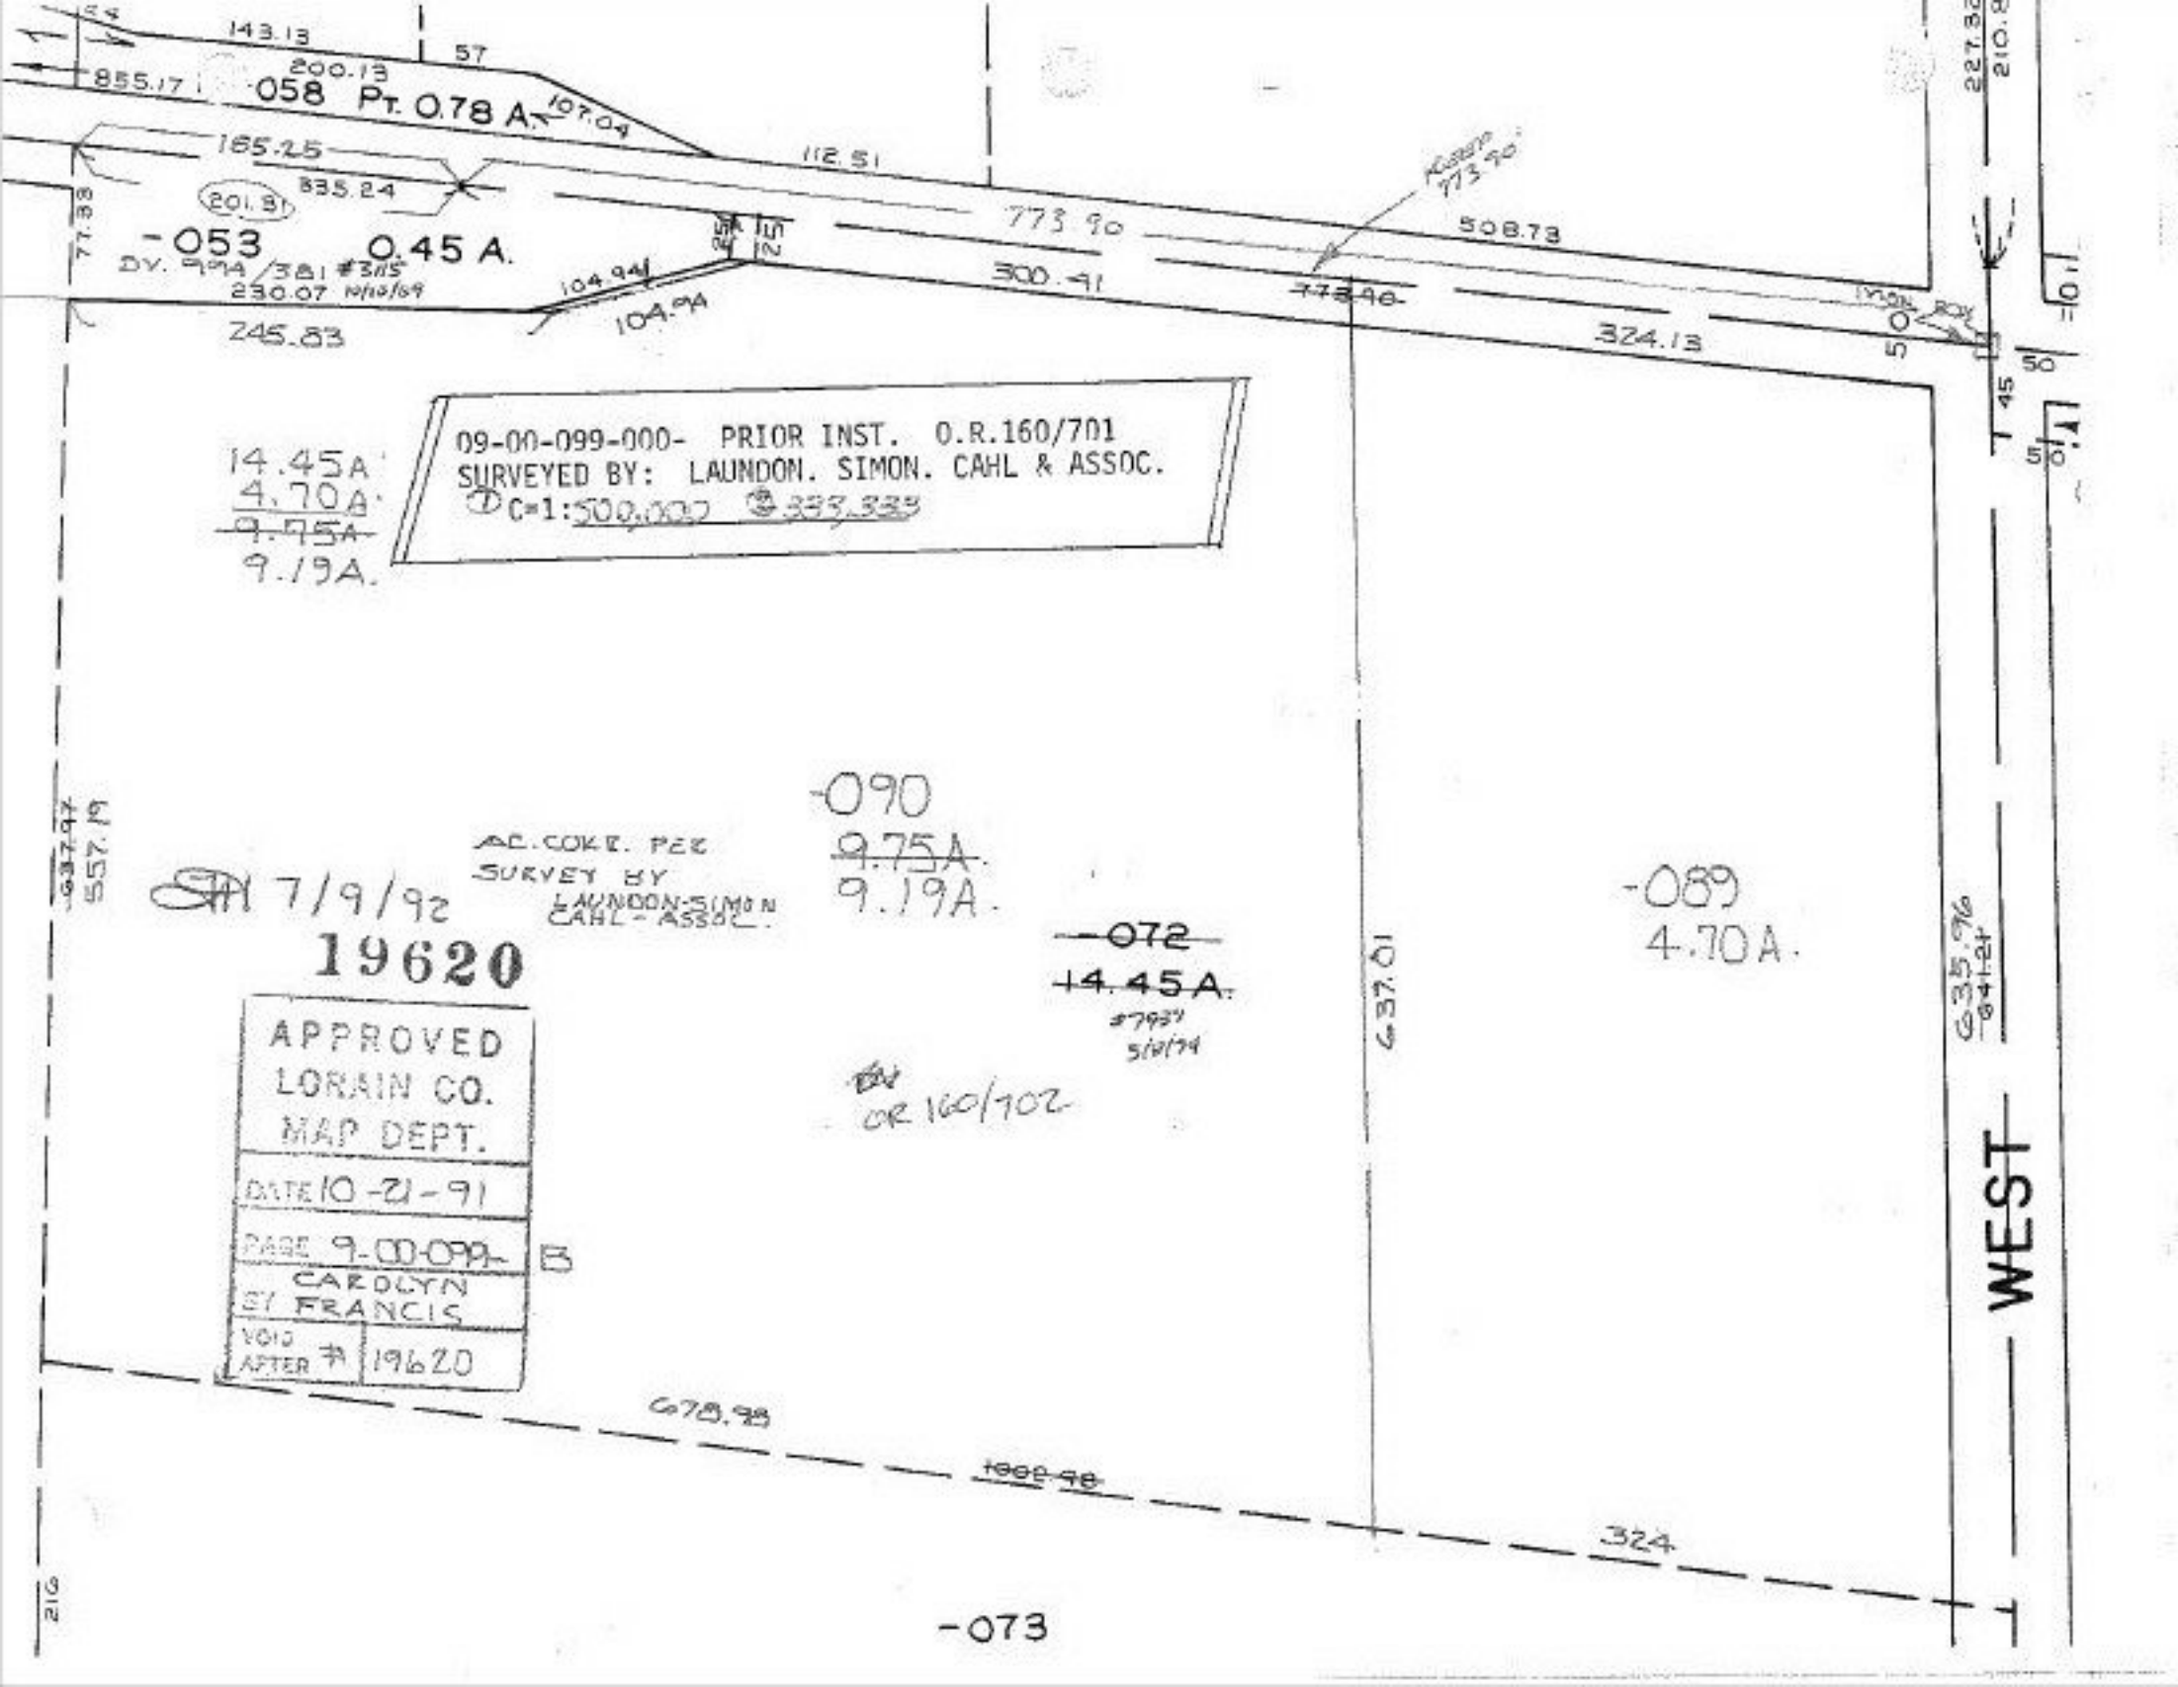

143.13
57
200.13
855.17
-058 Pt. 0.78 A.
107.04
165.25
112.51
335.24
201.81
-053 0.45 A.
DV. 994/381 #3115
230.07 10/10/69
77.38
104.94
104.94
245.83
773.90
300.41
508.73
324.13
09-00-099-000- PRIOR INST. O.R.160/701
SURVEYED BY: LAUNDON. SIMON. CAHL & ASSOC.
C=1:500,000 333,333
14.45A
4.70A
9.75A
9.19A.
-090
9.75A
9.19A.
AC. COKE. PER SURVEY BY LAUNDON-SIMON CAHL-ASSOC.
7/9/92
19620
APPROVED
LORAIN CO.
MAP DEPT.
DATE 10-21-91
PAGE 9-00-099- B
CAROLYN
BY FRANCIS
VOID AFTER # 19620
-072
14.45A.
#7937
5/8/94
OR 160/702
637.01
-089
4.70A.
635.96
WEST
678.98
1002.98
324
-073