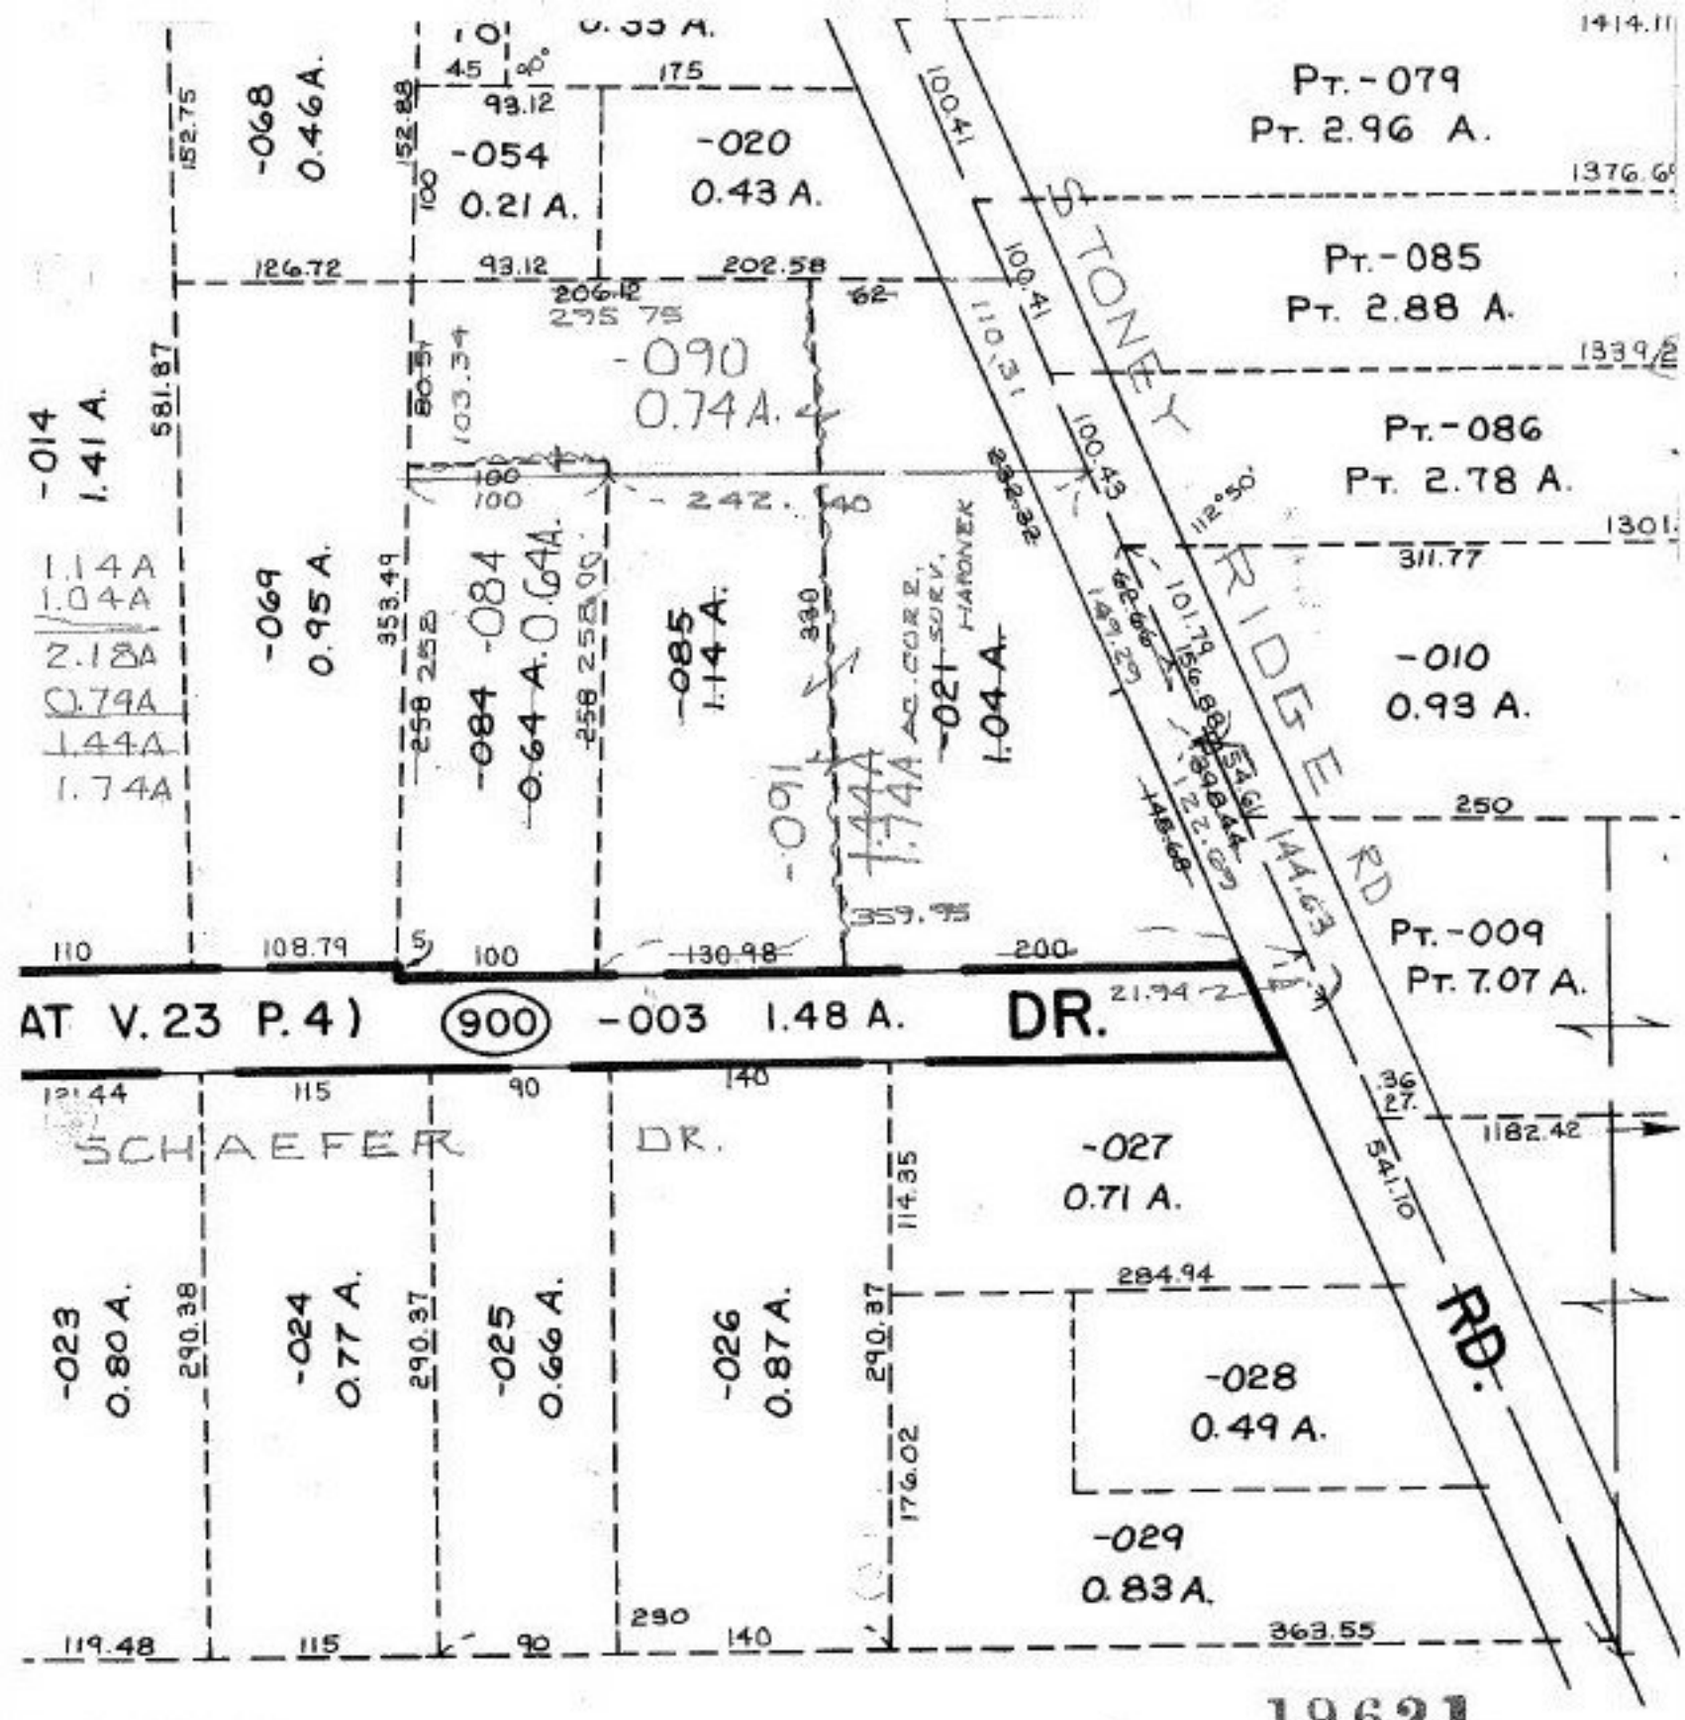

19621

0-028-C

07-00-028-101- PRIOR INST. 1283/176
SURVEYED BY: SAME A HAPONEK REG. SURVEYOR
C=1: 450,000-2-62,500

APPROVED
LORAIN CO.
MAP DEPT.
DATE 10-25-91
PAGE 7-00-028-A
BY CAROLYN FRANCIS
VOID AFTER # 19621