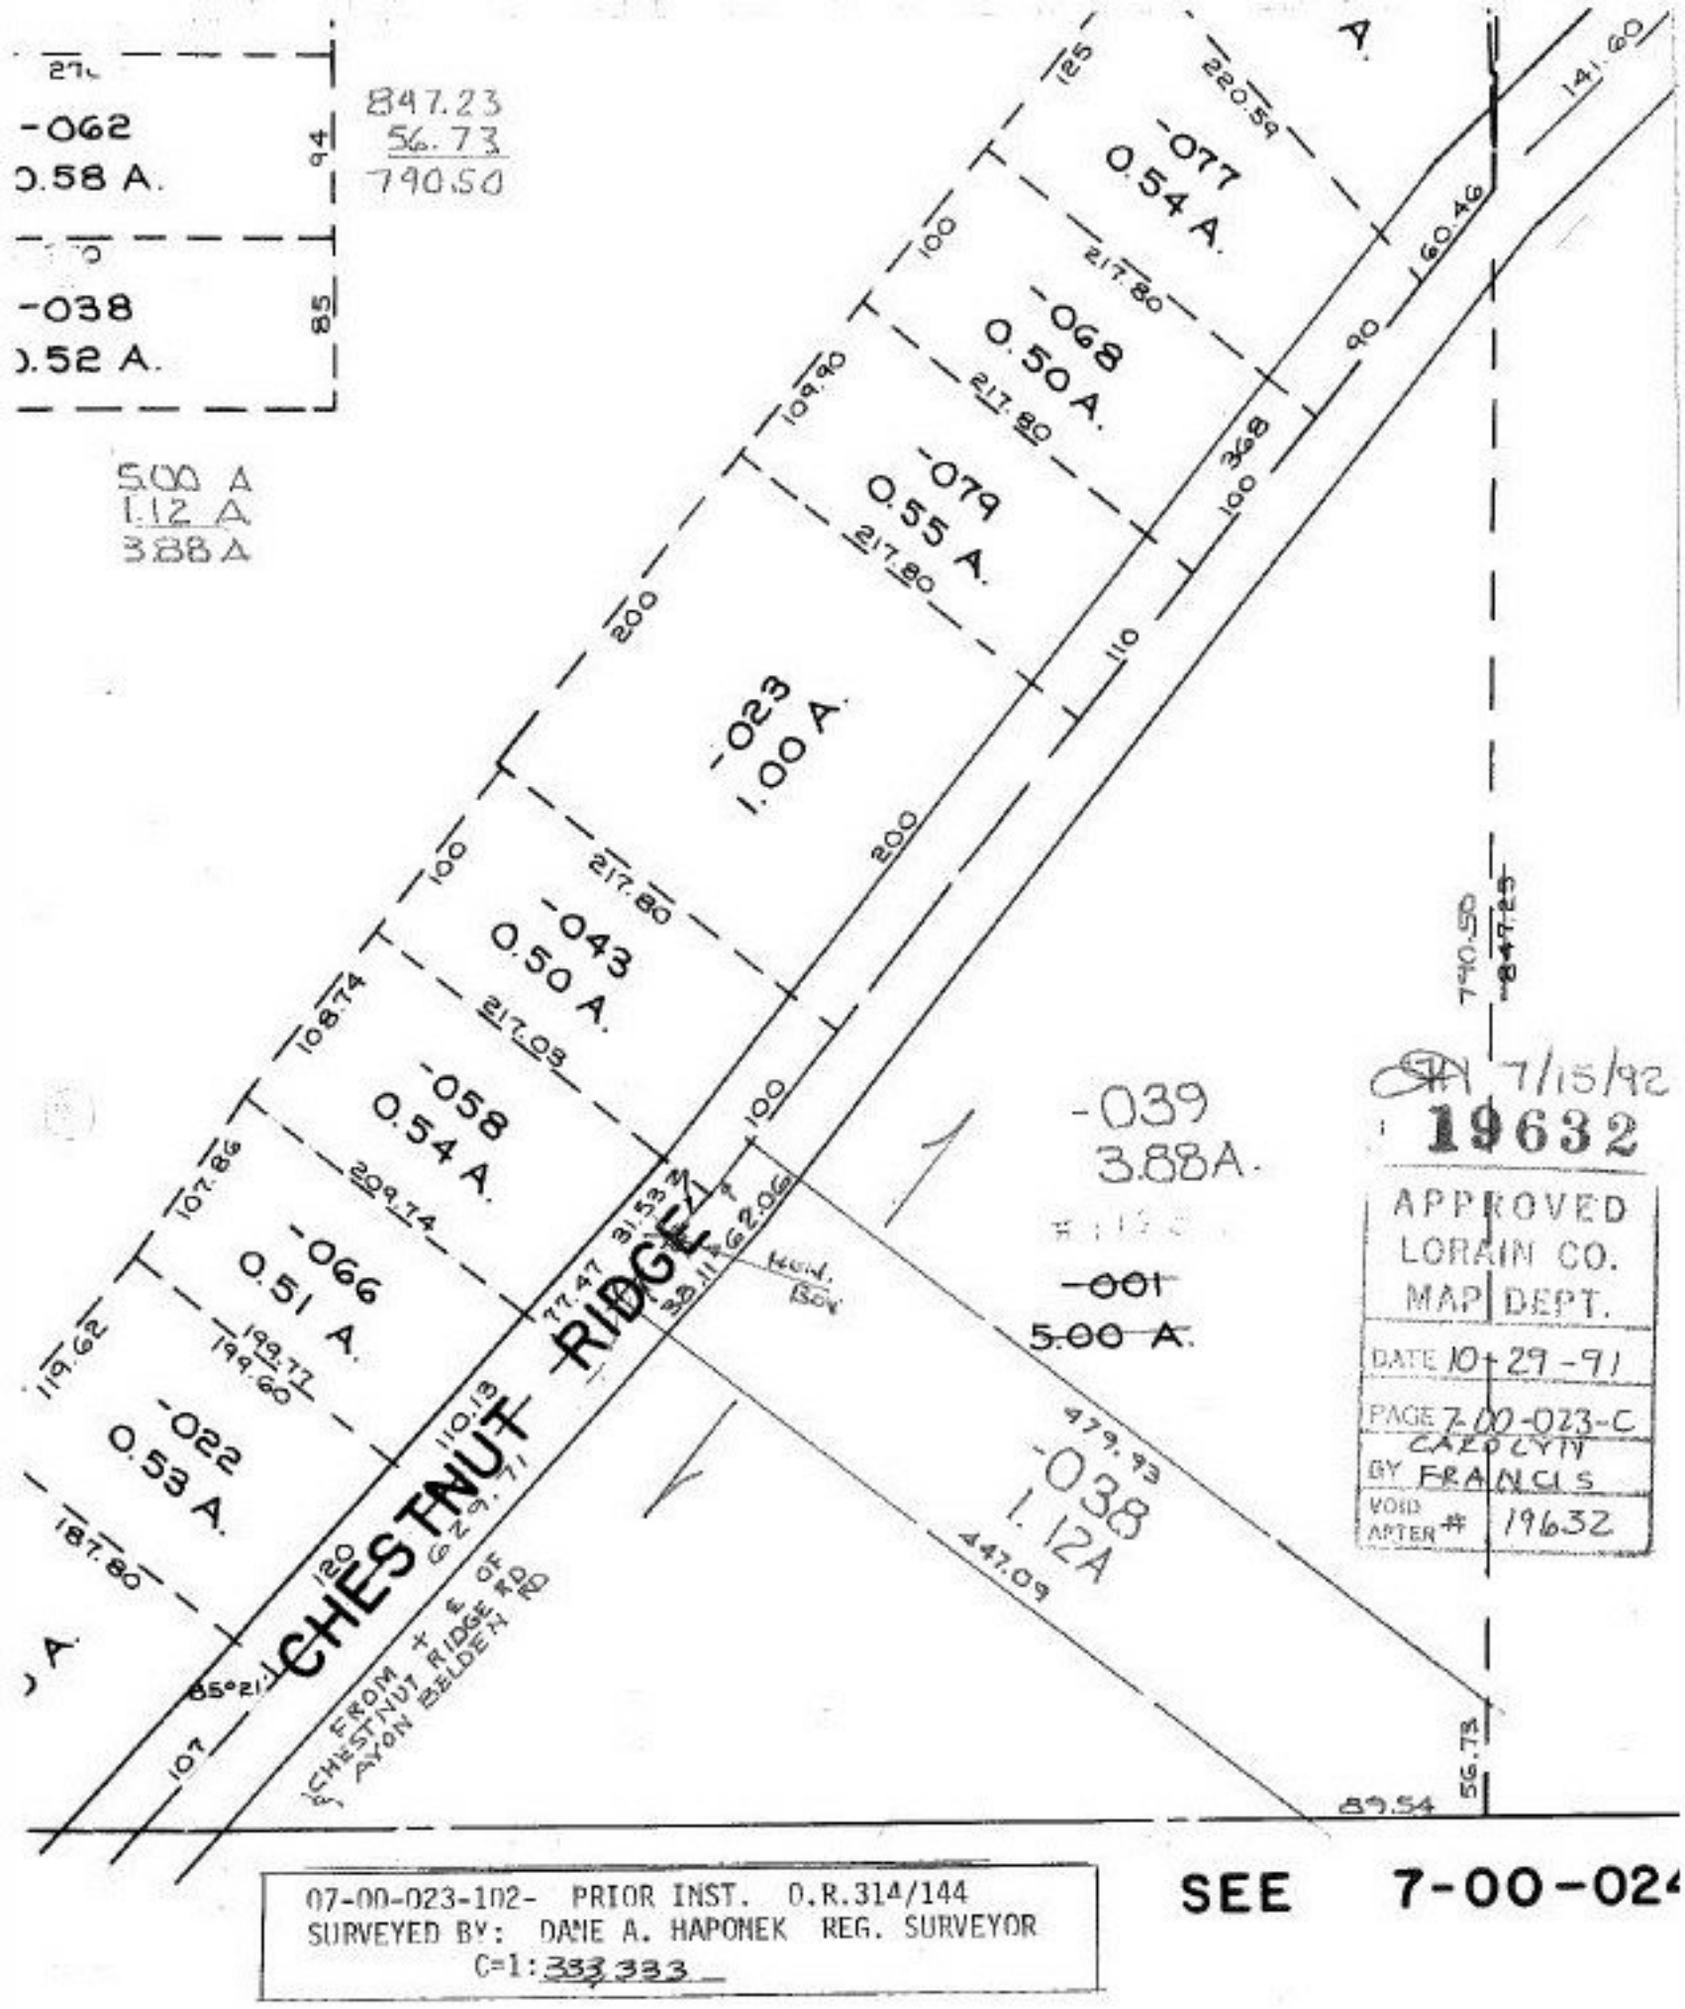

07-00-023-102- PRIOR INST. O.R.314/144
SURVEYED BY: DANE A. HAPONEK REG. SURVEYOR
C=1: 333 333

SEE 7-00-024