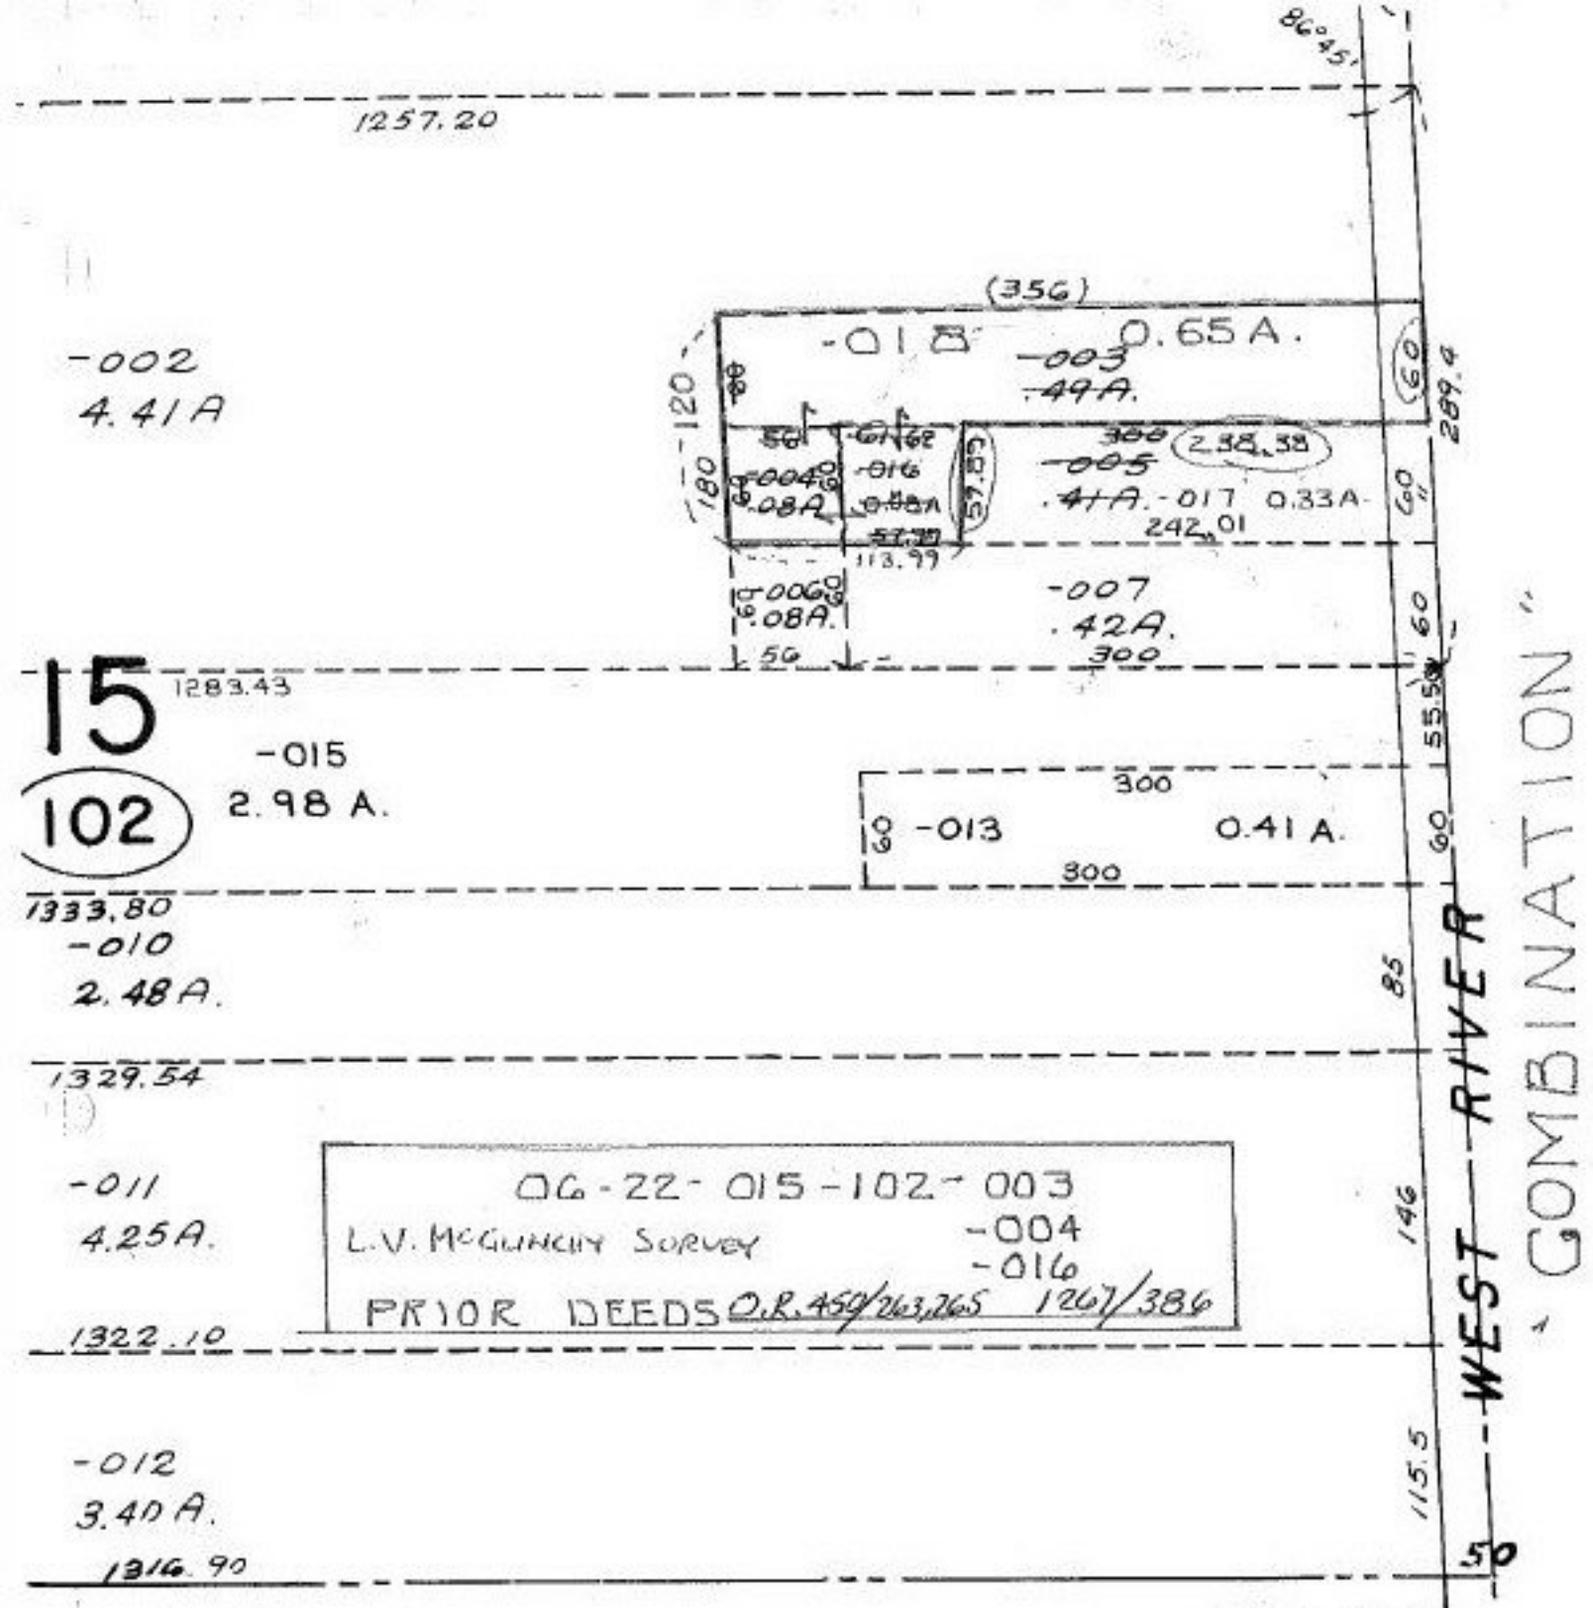

EE 6-28

SM 1/6/92

19633

APPROVED
LORAIN CO.
MAP DEPT.
DATE 10-29-91
PAGE 6-10
BY CAROLYN FRANCIS
VOID AFTER # 19633