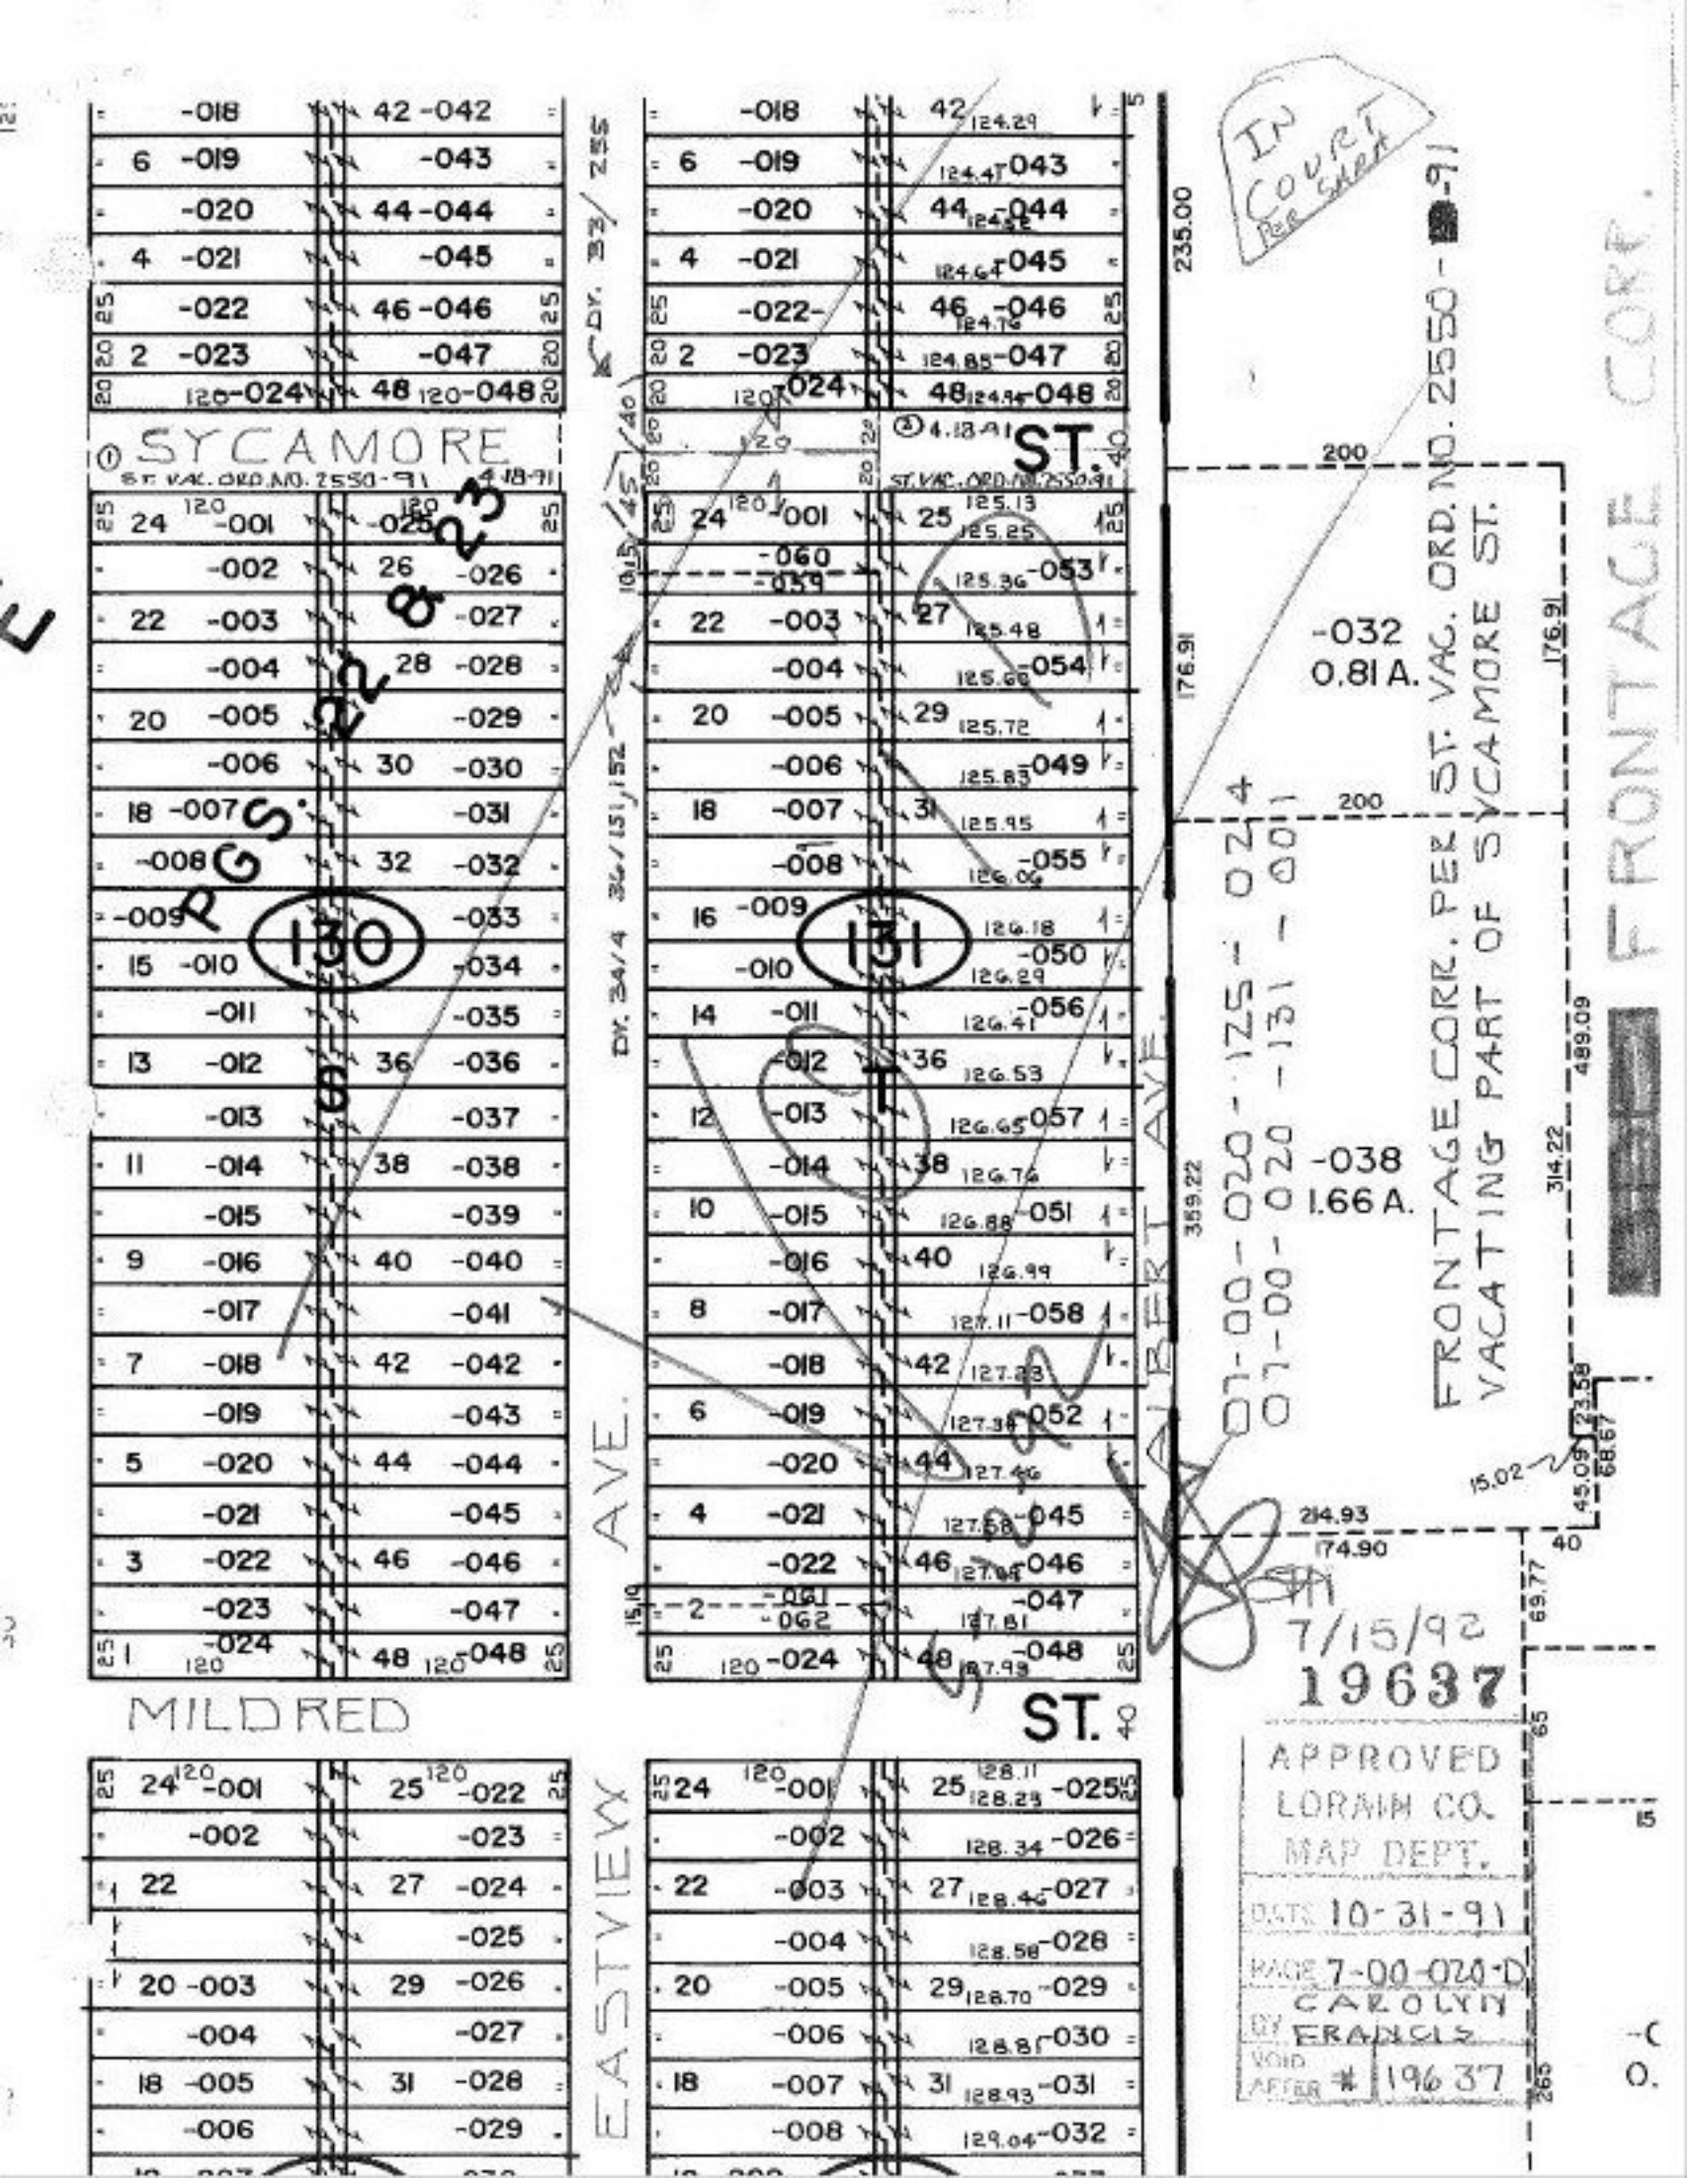

SYCAMORE
ST. VAC. ORD. NO. 2550-91
4-18-91
ST.
MILDRED
ST.
EASTVIEW AVE.
AIBERT AVE.
DY. 33/255
DY. 34/4 36/151, 152
130
131
PGS. 22 & 23
IN COURT PER SHEET
07-00-020-125-024
07-00-020-131-001
FRONTAGE CORR. PER ST. VAC. ORD. NO. 2550-91
VACATING PART OF SYCAMORE ST.
-032
0.81 A.
-038
1.66 A.
FRONTAGE CORR.
7/15/92
19637
APPROVED
LORAIN CO.
MAP DEPT.
DATE 10-31-91
PAGE 7-00-020-D
BY CAROLYN FRANCIS
VOID AFTER # 19637