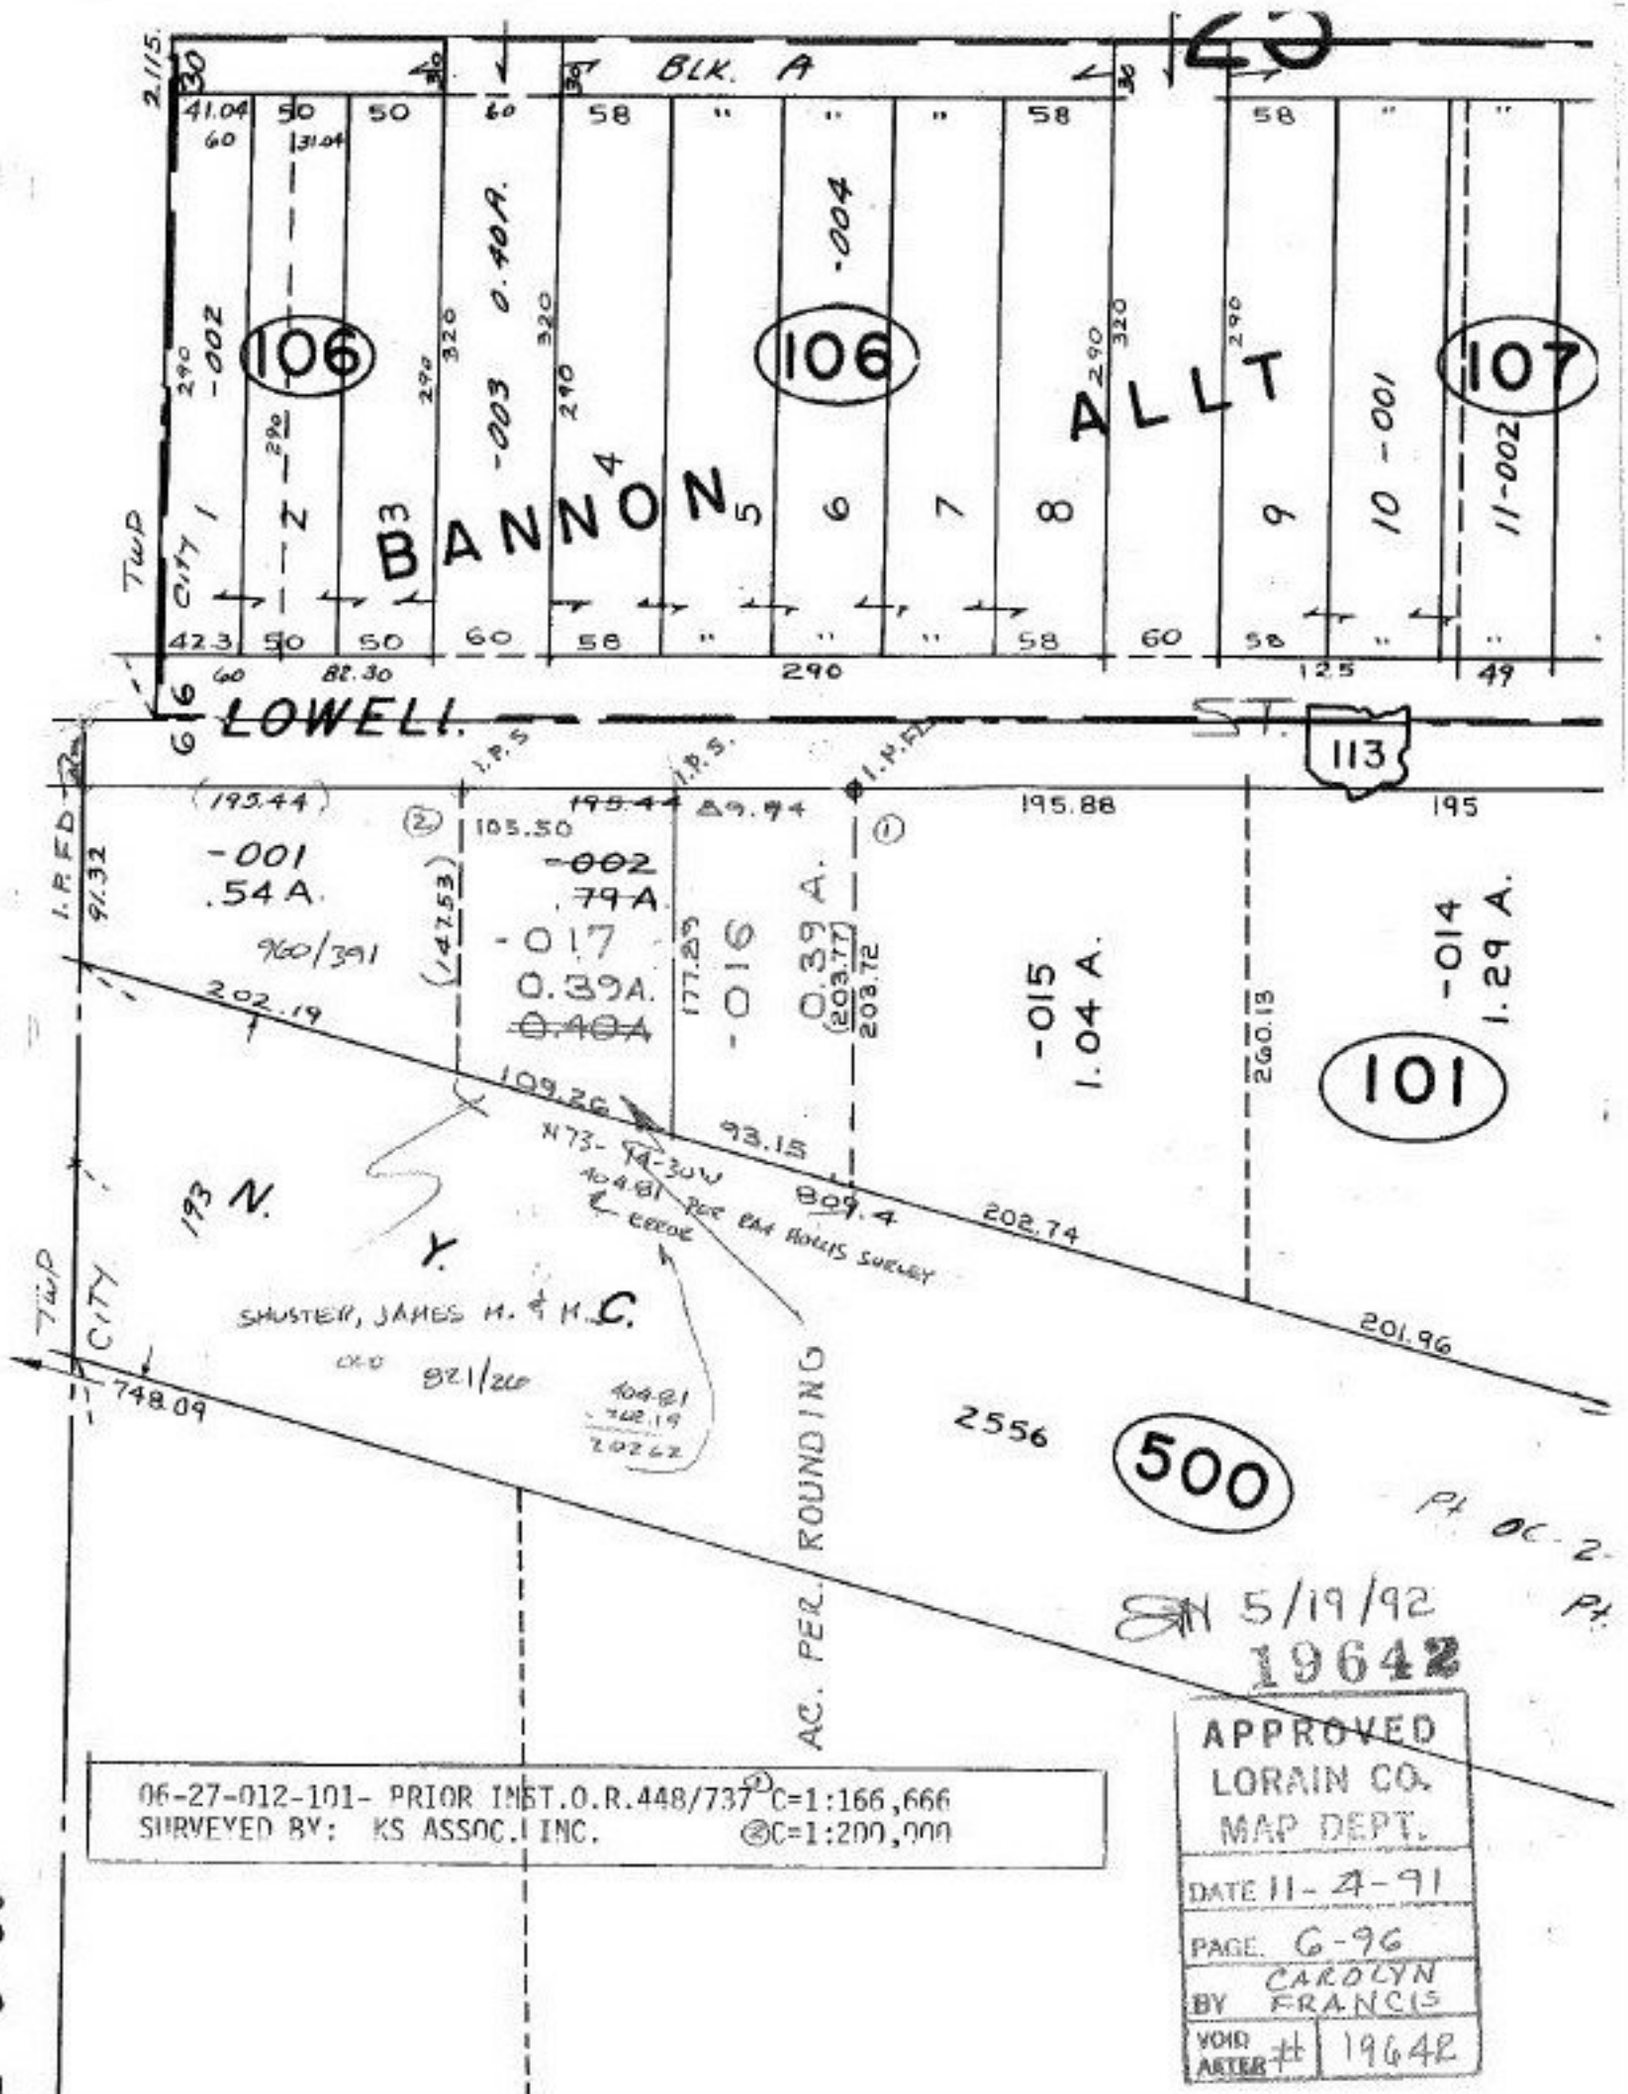
BLK. A
BANNON ALLT
LOWELL ST.
113
106
106
107
101
500
-001
.54 A.
-002
.79 A.
-017
0.39A.
-016
0.39 A.
-015
1.04 A.
-014
1.29 A.
-003
0.40A.
-004
-002
-001
TWP
CITY
I.P.S.
I.P.FD
N.Y.C.
SHUSTER, JAMES M. & M.
AC. PER. ROUNDING
2556
Pt OC-2
Pt
5/19/92
19642
APPROVED
LORAIN CO.
MAP DEPT.
DATE 11-4-91
PAGE 6-96
BY CAROLYN FRANCIS
VOID AFTER # 19642
06-27-012-101- PRIOR INST.O.R.448/737 ① C=1:166,666
SURVEYED BY: KS ASSOC. INC. ② C=1:200,000
E 6-95