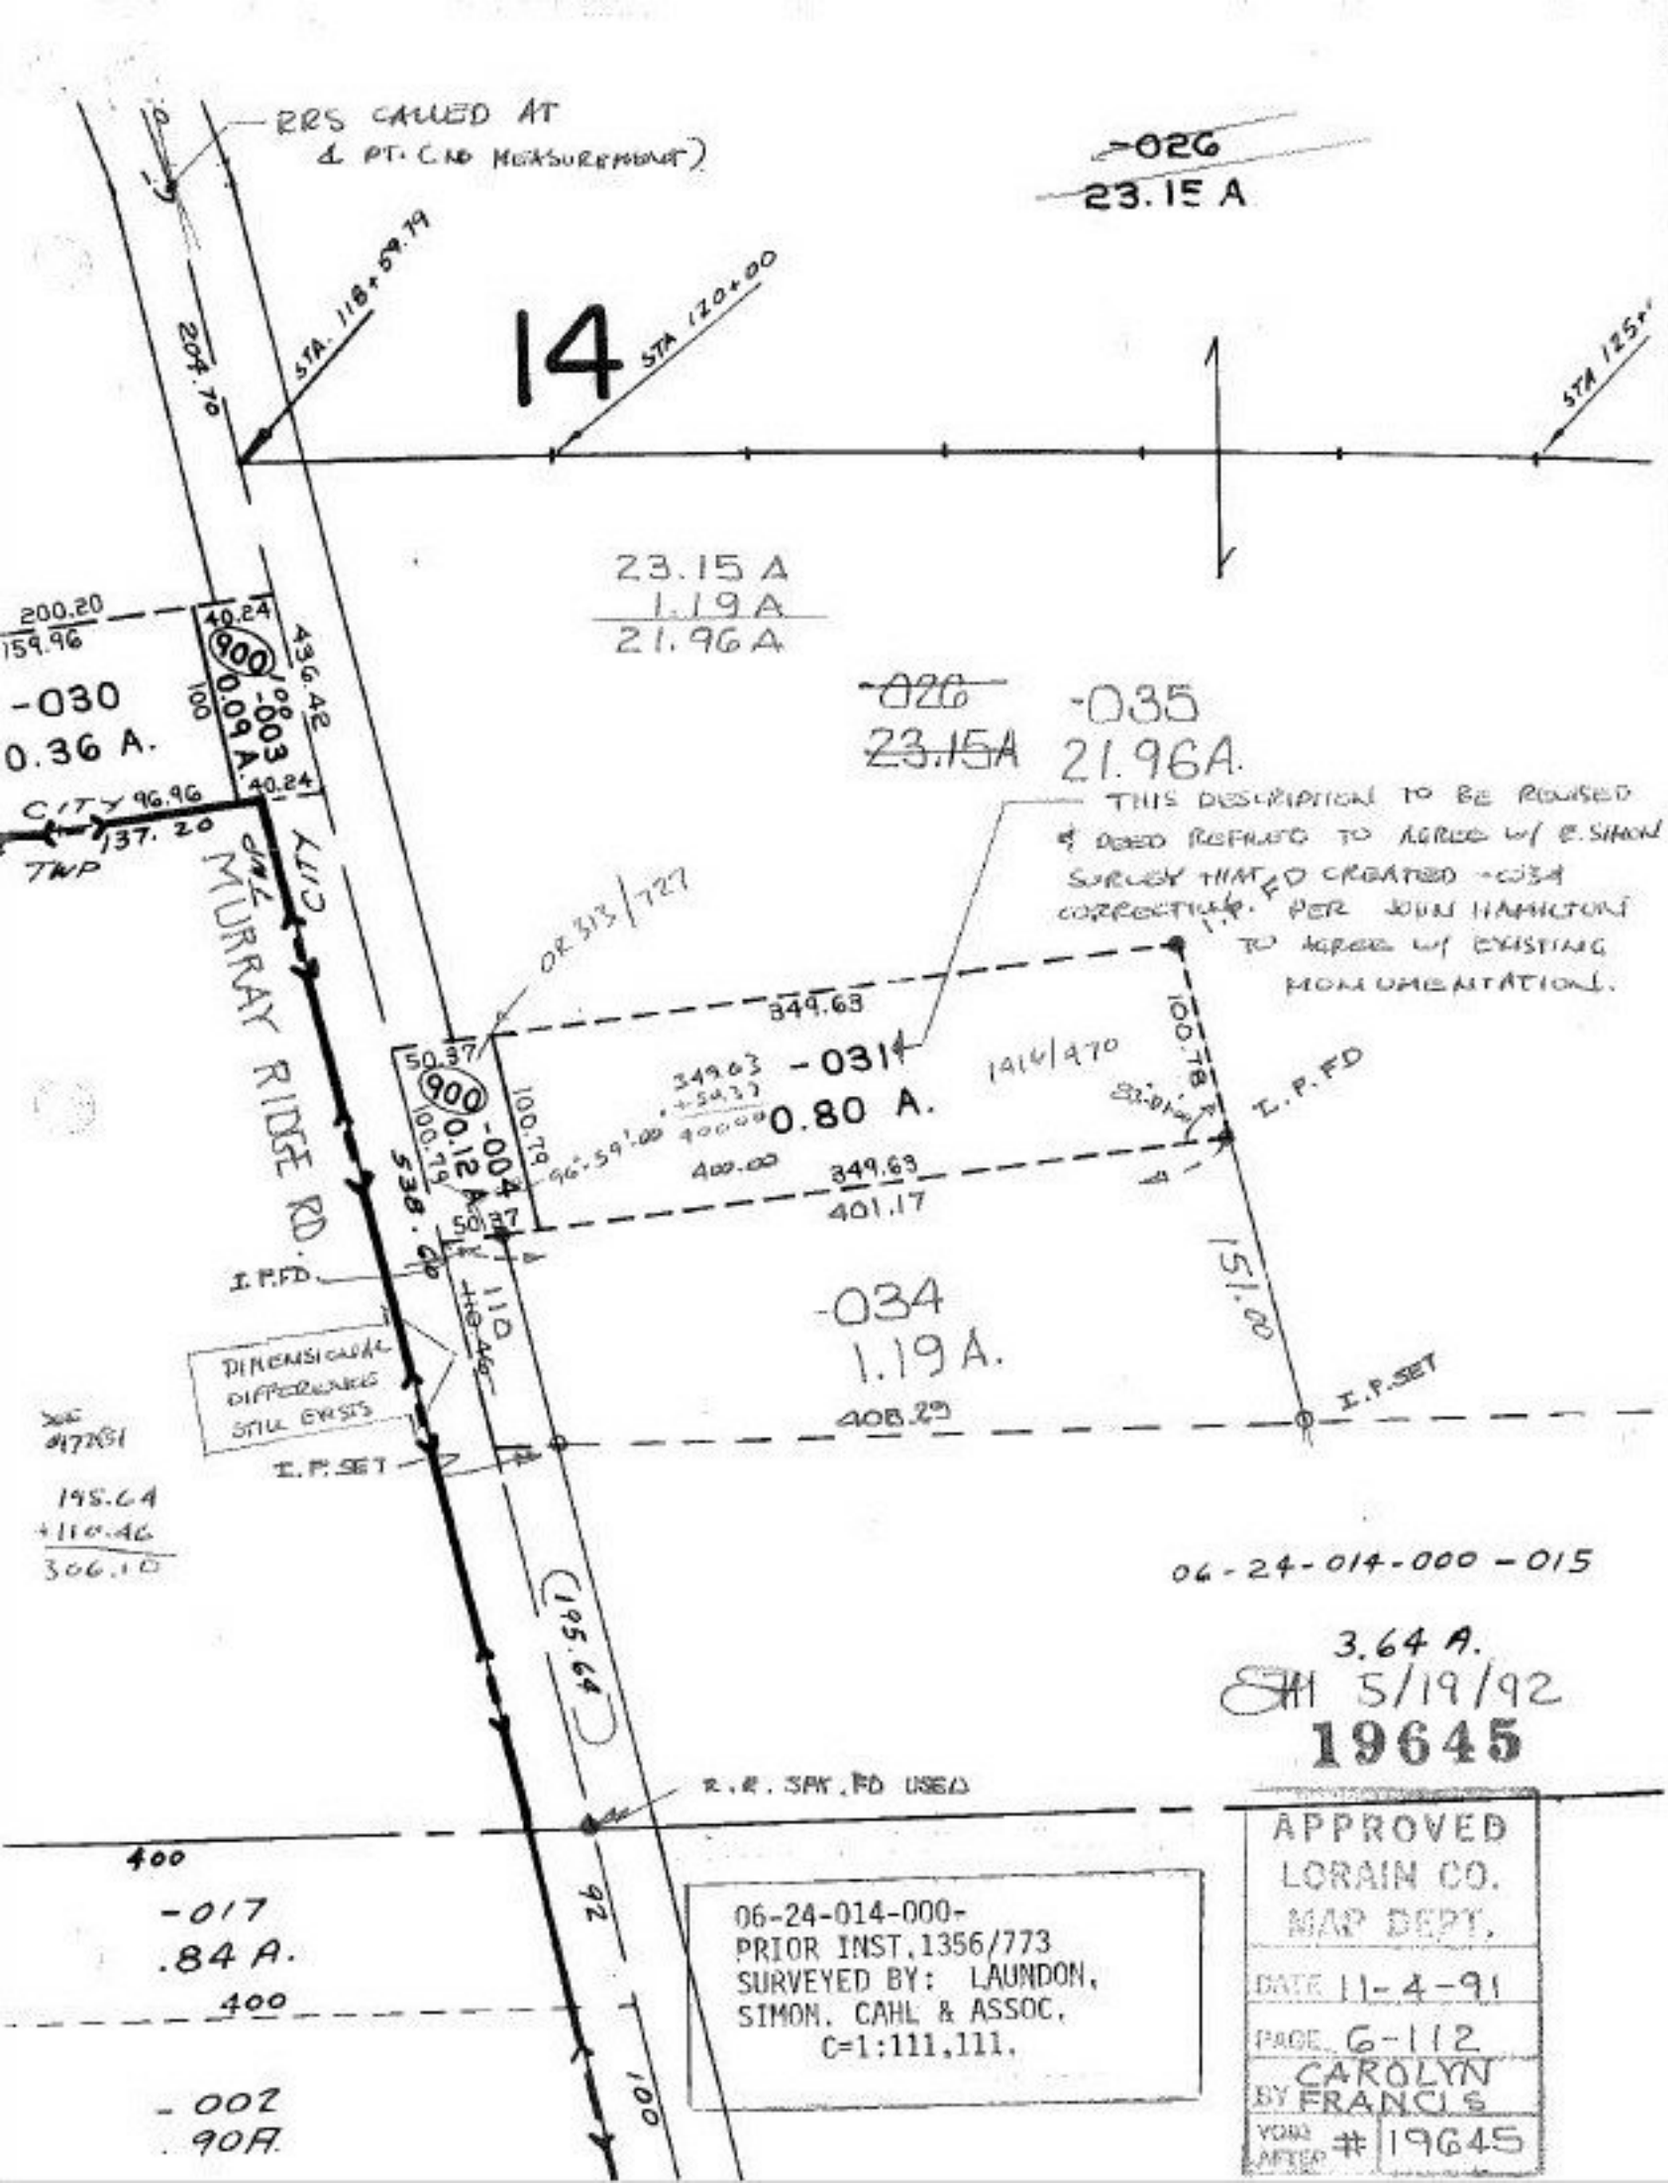
RRS CALLED AT
℄ PT. (NO MEASUREMENT)
-026
23.15 A
14
STA. 118+59.79
STA 120+00
STA 125+
204.70
23.15 A
1.19 A
21.96 A
200.20
159.96
40.24
900
-003
0.09 A.
436.42
-030
0.36 A.
CITY 96.96
137.20
TWP
40.24
CITY
MURRAY RIDGE RD.
-026
23.15A
-035
21.96A.
THIS DESCRIPTION TO BE REVISED & DEED REFILED TO AGREE W/ E. SIMON SURVEY THAT CREATED -034 CORRECTION. PER JOHN HAMILTON TO AGREE W/ EXISTING MONUMENTATION.
OR 313/727
349.63
50.37
900
-004
0.12 A.
100.79
100.79
538.60
-031
0.80 A.
1416/470
100.78
I.P. FD
400.00
349.63
401.17
50.37
I.P.FD.
-034
1.19 A.
151.00
DIMENSIONAL DIFFERENCE STILL EXISTS
I.P.SET
408.29
I.P.SET
195.64
+110.46
306.10
06-24-014-000-015
3.64 A.
5/19/92
19645
195.64
R.R. SPK. FD USED
400
-017
.84 A.
400
-002
.90A.
06-24-014-000-
PRIOR INST.1356/773
SURVEYED BY: LAUNDON,
SIMON, CAHL & ASSOC.
C=1:111,111.
APPROVED
LORAIN CO.
MAP DEPT.
DATE 11-4-91
PAGE 6-112
BY CAROLYN FRANCIS
VOID AFTER # 19645