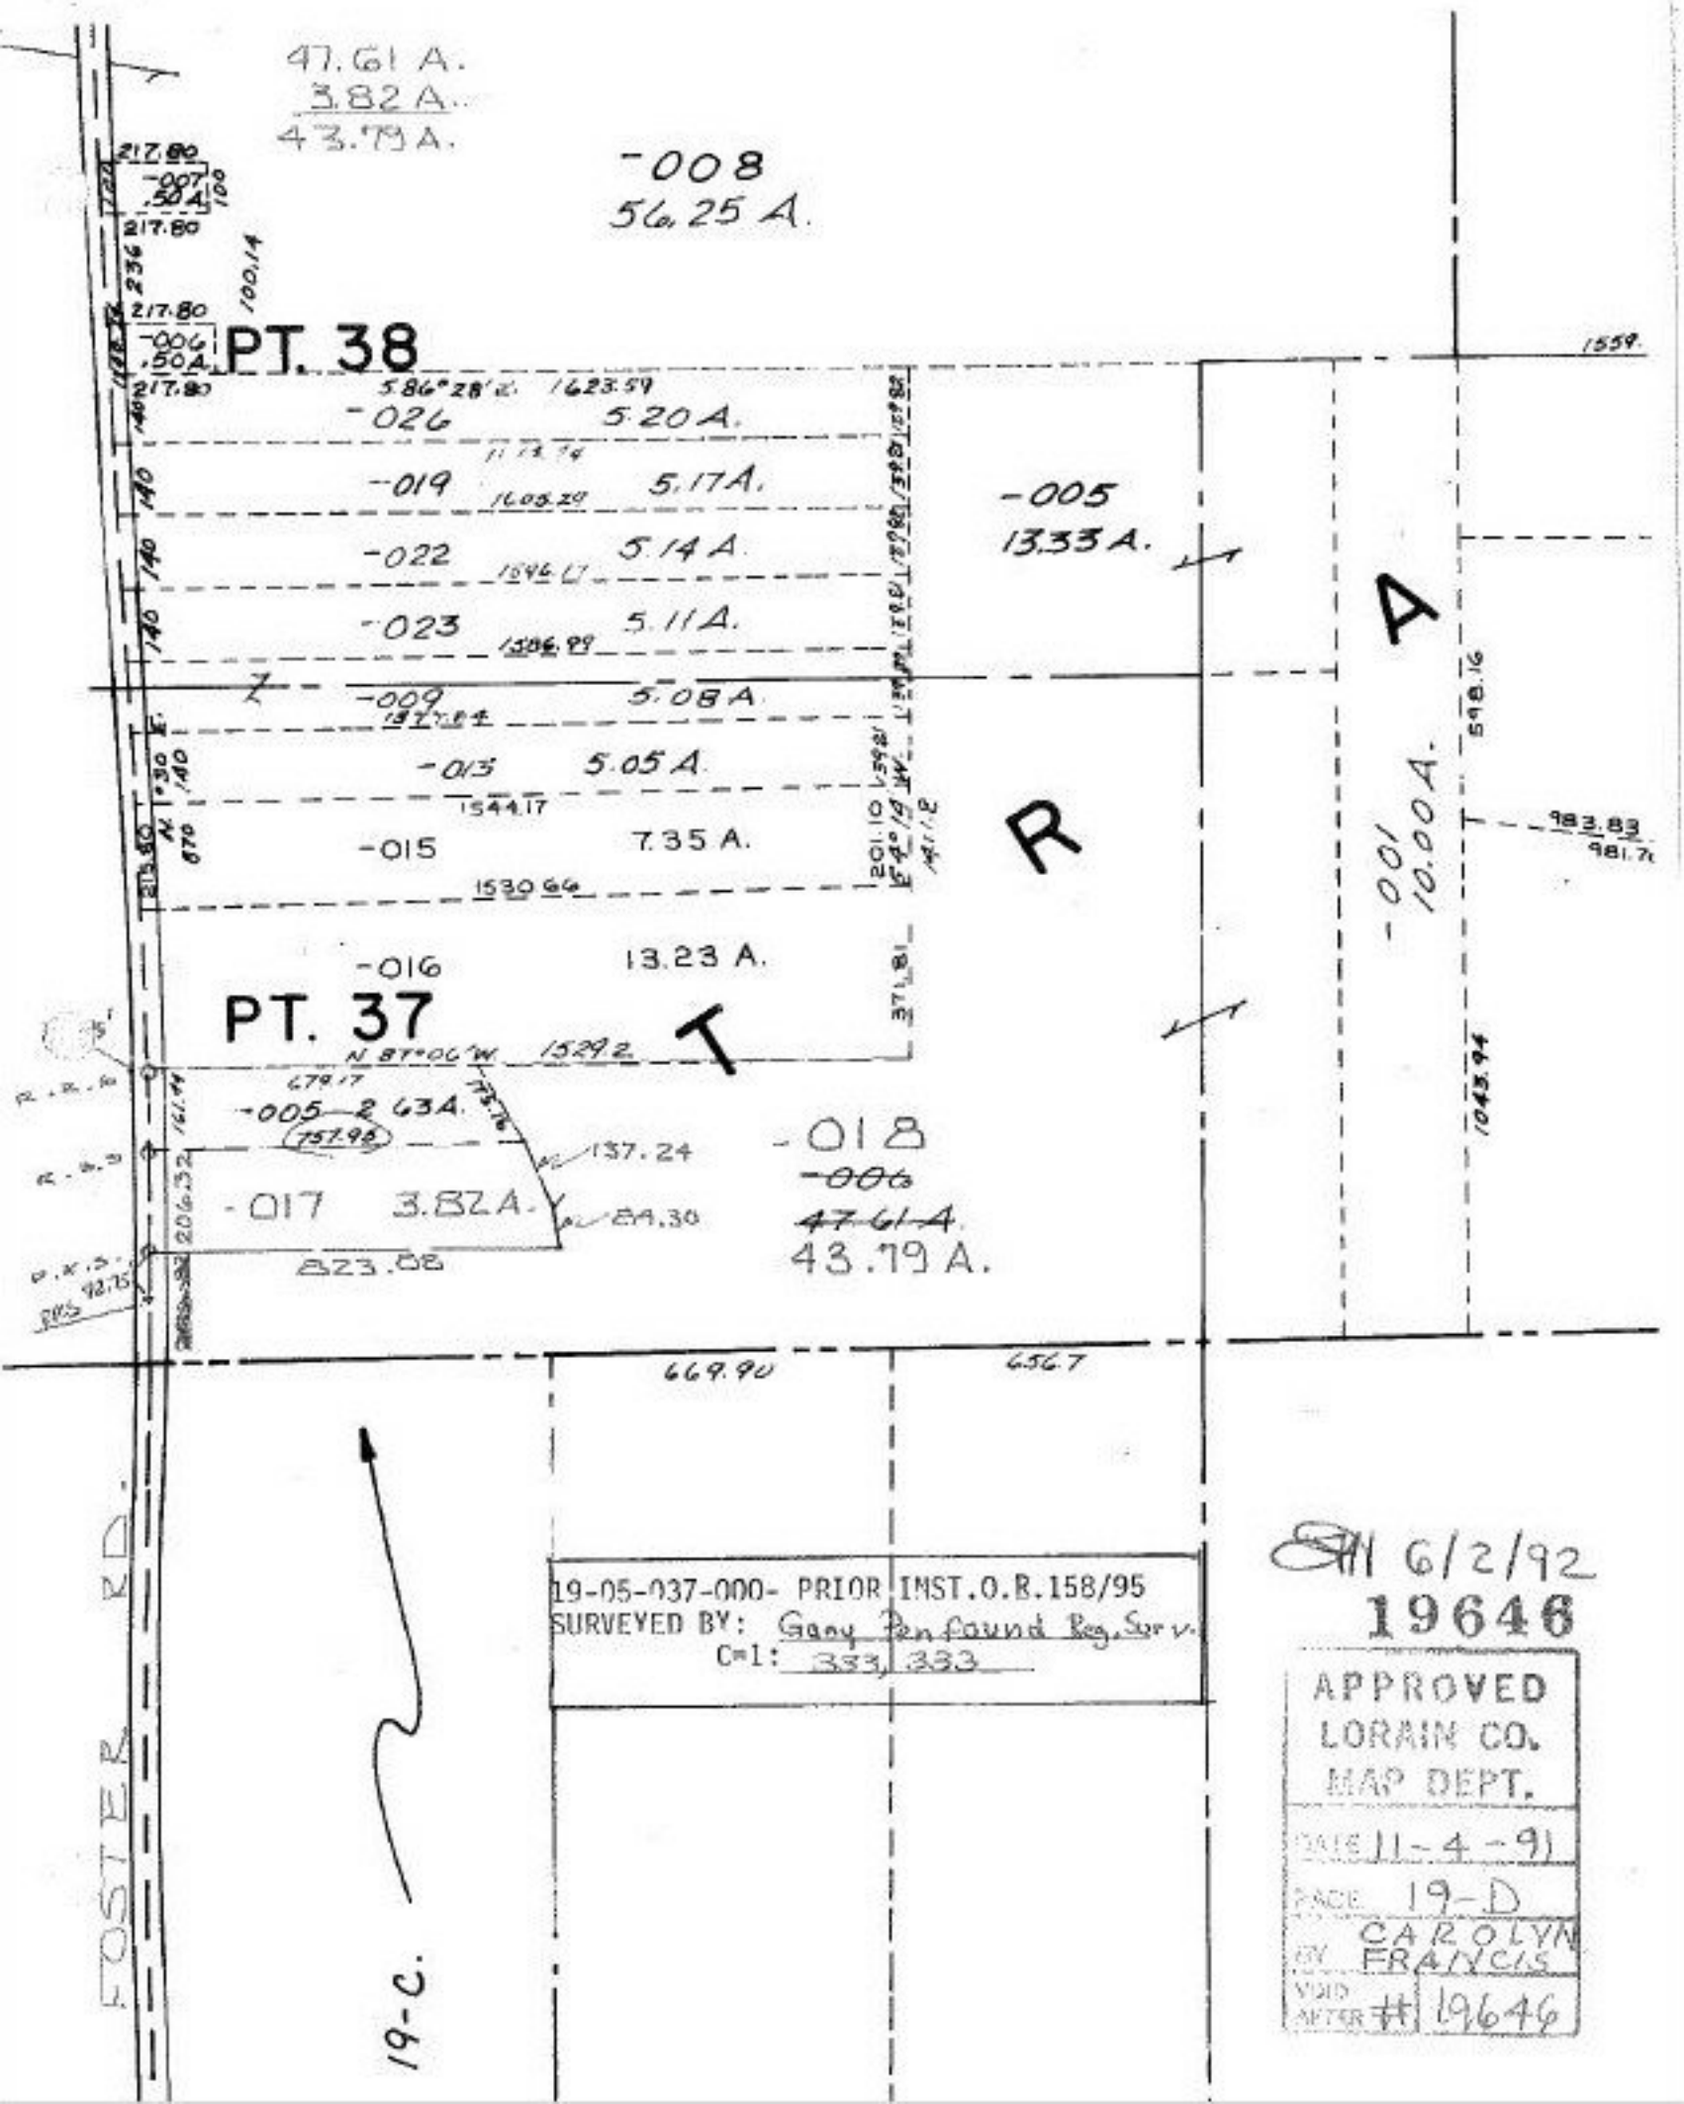
47.61 A.
3.82 A.
43.79 A.
-008
56.25 A.
PT. 38
-026 5.20 A.
-019 5.17 A.
-022 5.14 A.
-023 5.11 A.
-009 5.08 A.
-013 5.05 A.
-015 7.35 A.
-016 13.23 A.
PT. 37
-005 2.63 A.
-017 3.82 A.
-005 13.33 A.
-001 10.00 A.
-018
-006
47.61 A.
43.79 A.
FOSTER RD.
19-C.
19-05-037-000- PRIOR INST.O.R.158/95
SURVEYED BY: Gary Penfound Reg. Surv.
C=1: 333/333
6/2/92
19646
APPROVED
LORAIN CO.
MAP DEPT.
DATE 11-4-91
PAGE 19-D
BY CAROLYN FRANCIS
VOID AFTER # 19646