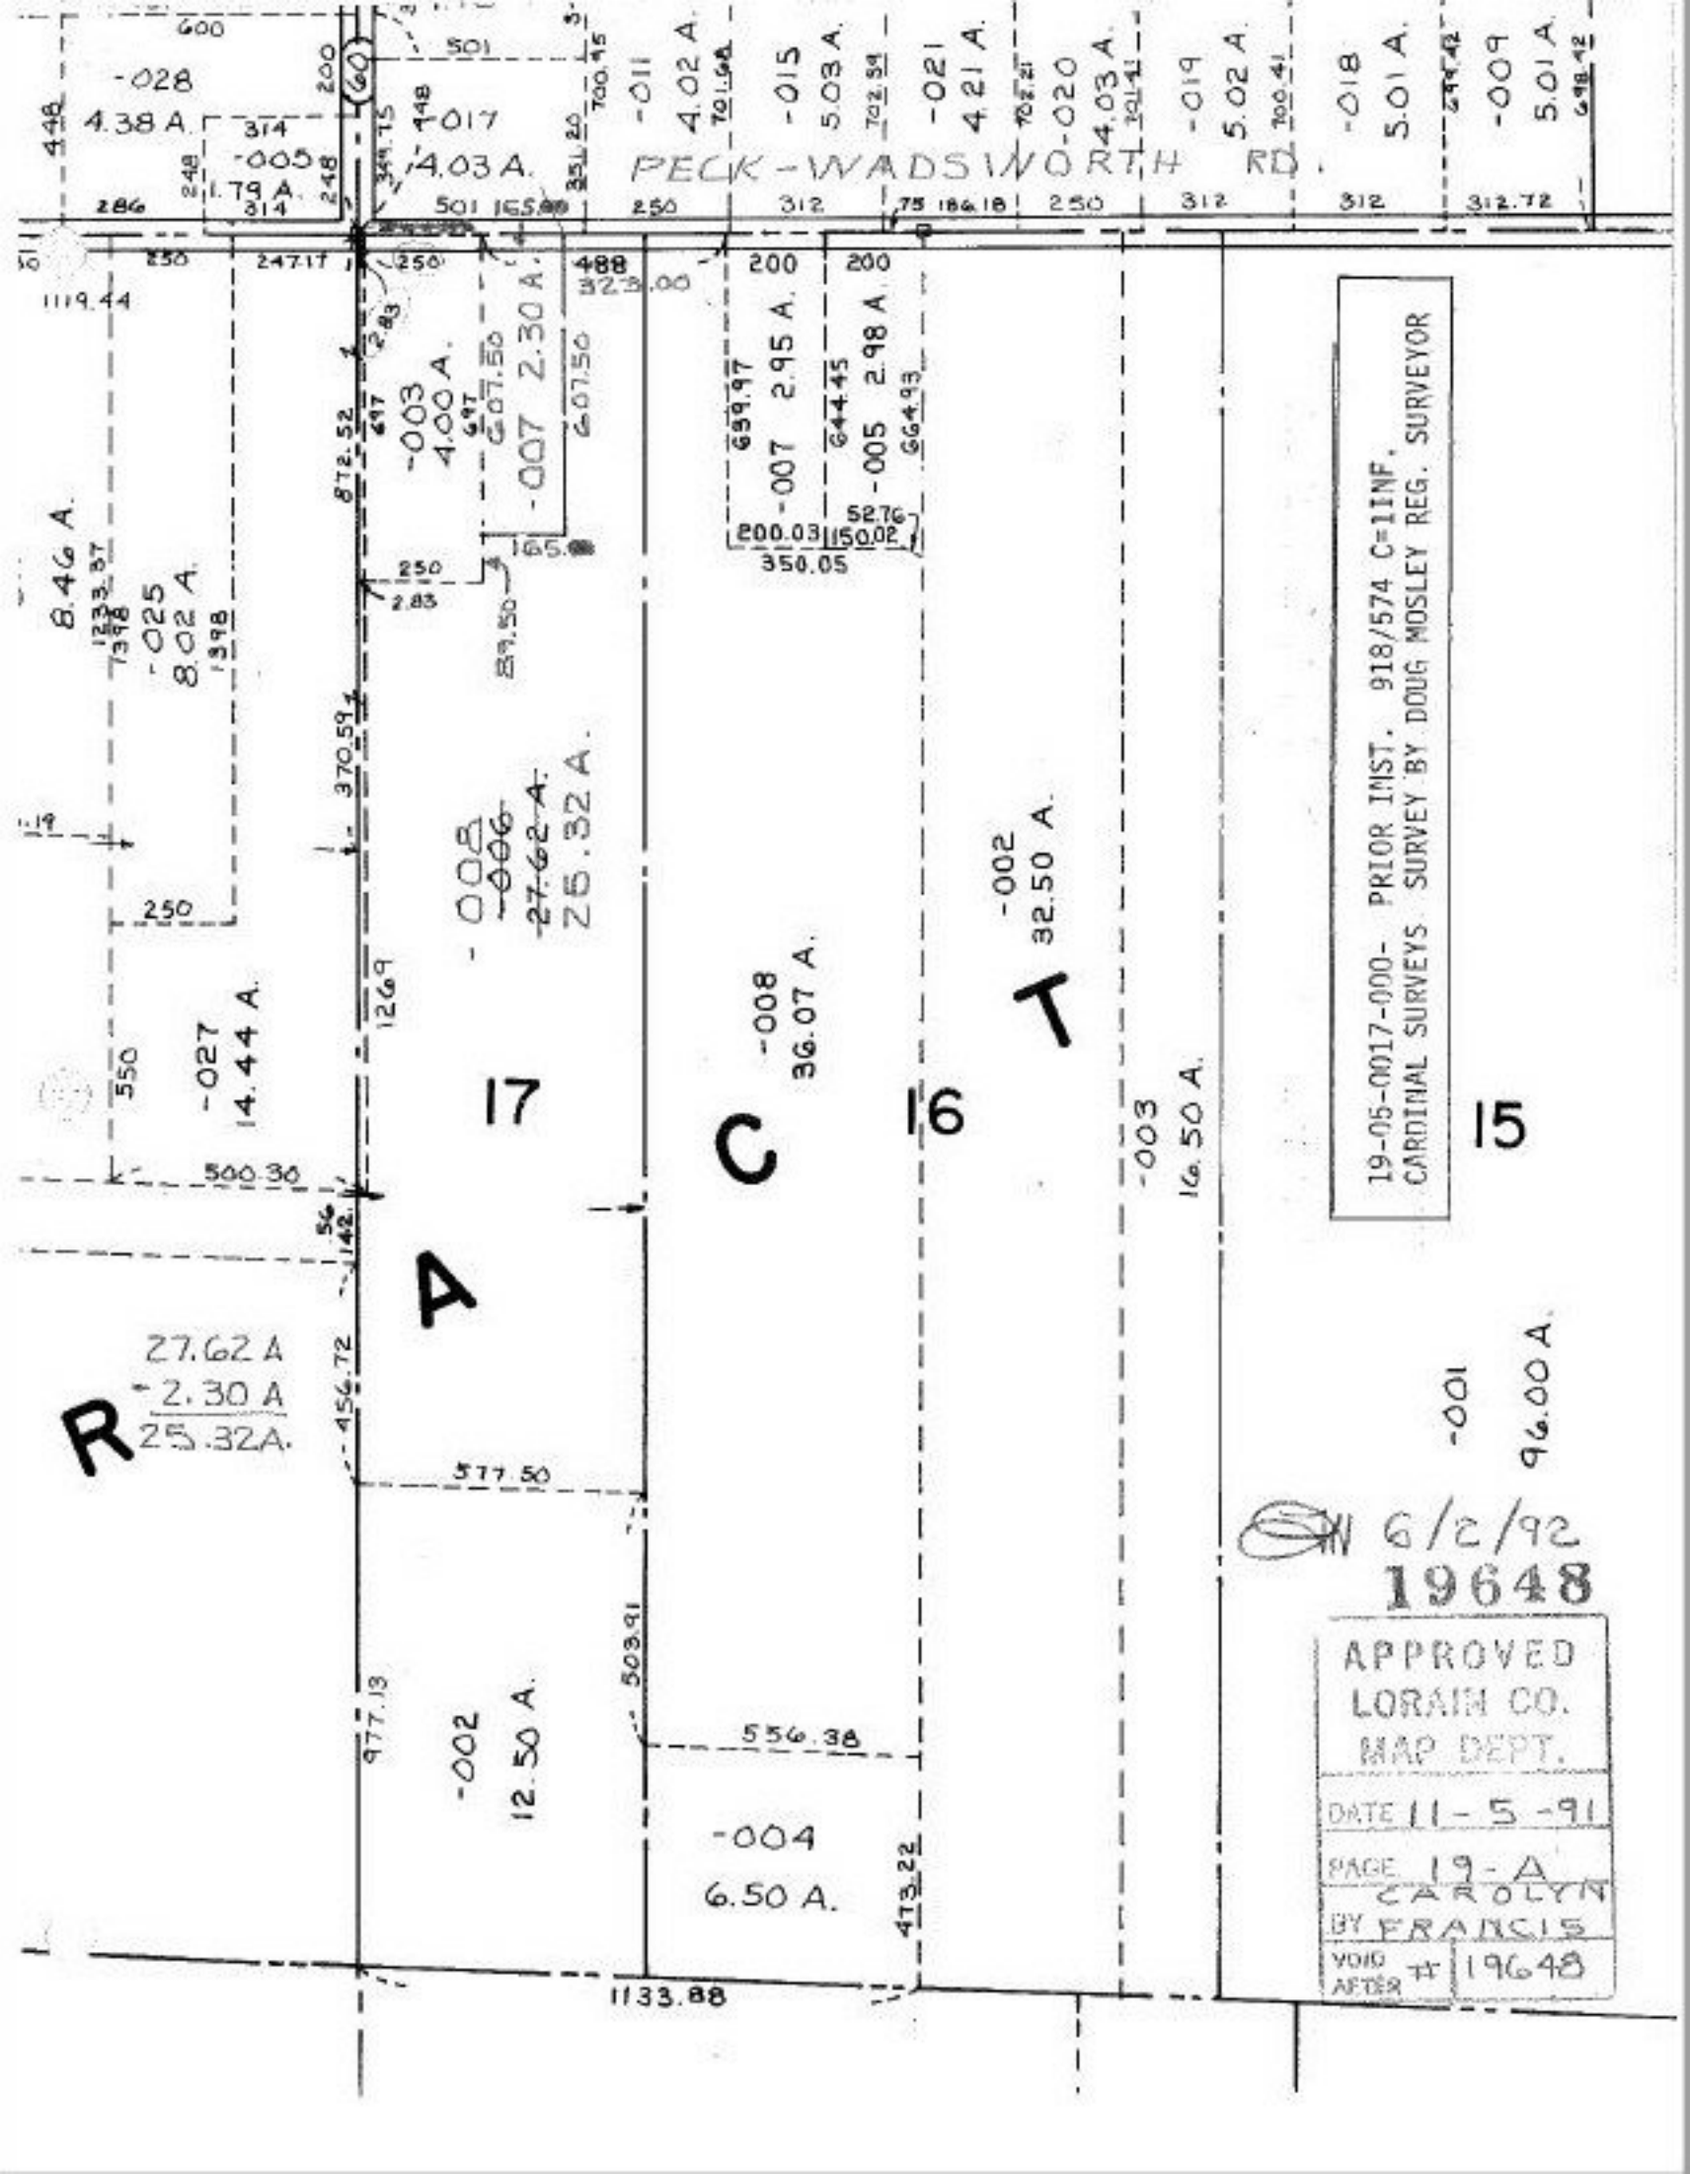
PECK-WADSWORTH RD.
-028 4.38 A.
-005 1.79 A.
-017 4.03 A.
-011 4.02 A.
-015 5.03 A.
-021 4.21 A.
-020 4.03 A.
-019 5.02 A.
-018 5.01 A.
-009 5.01 A.
-003 4.00 A.
-007 2.30 A.
-007 2.95 A.
-005 2.98 A.
-025 8.02 A.
-008 ~~-006~~ ~~27.62 A.~~ 25.32 A.
-002 32.50 A.
-008 36.07 A.
-027 14.44 A.
-003 16.50 A.
-001 96.00 A.
-002 12.50 A.
-004 6.50 A.
17
16
15
R A C T
27.62 A
-2.30 A
25.32A.
19-05-0017-000- PRIOR INST. 918/574 C=1INF.
CARDINAL SURVEYS SURVEY BY DOUG MOSLEY REG. SURVEYOR
6/2/92
19648
APPROVED
LORAIN CO.
MAP DEPT.
DATE 11-5-91
PAGE 19-A
BY CAROLYN FRANCIS
VOID AFTER # 19648