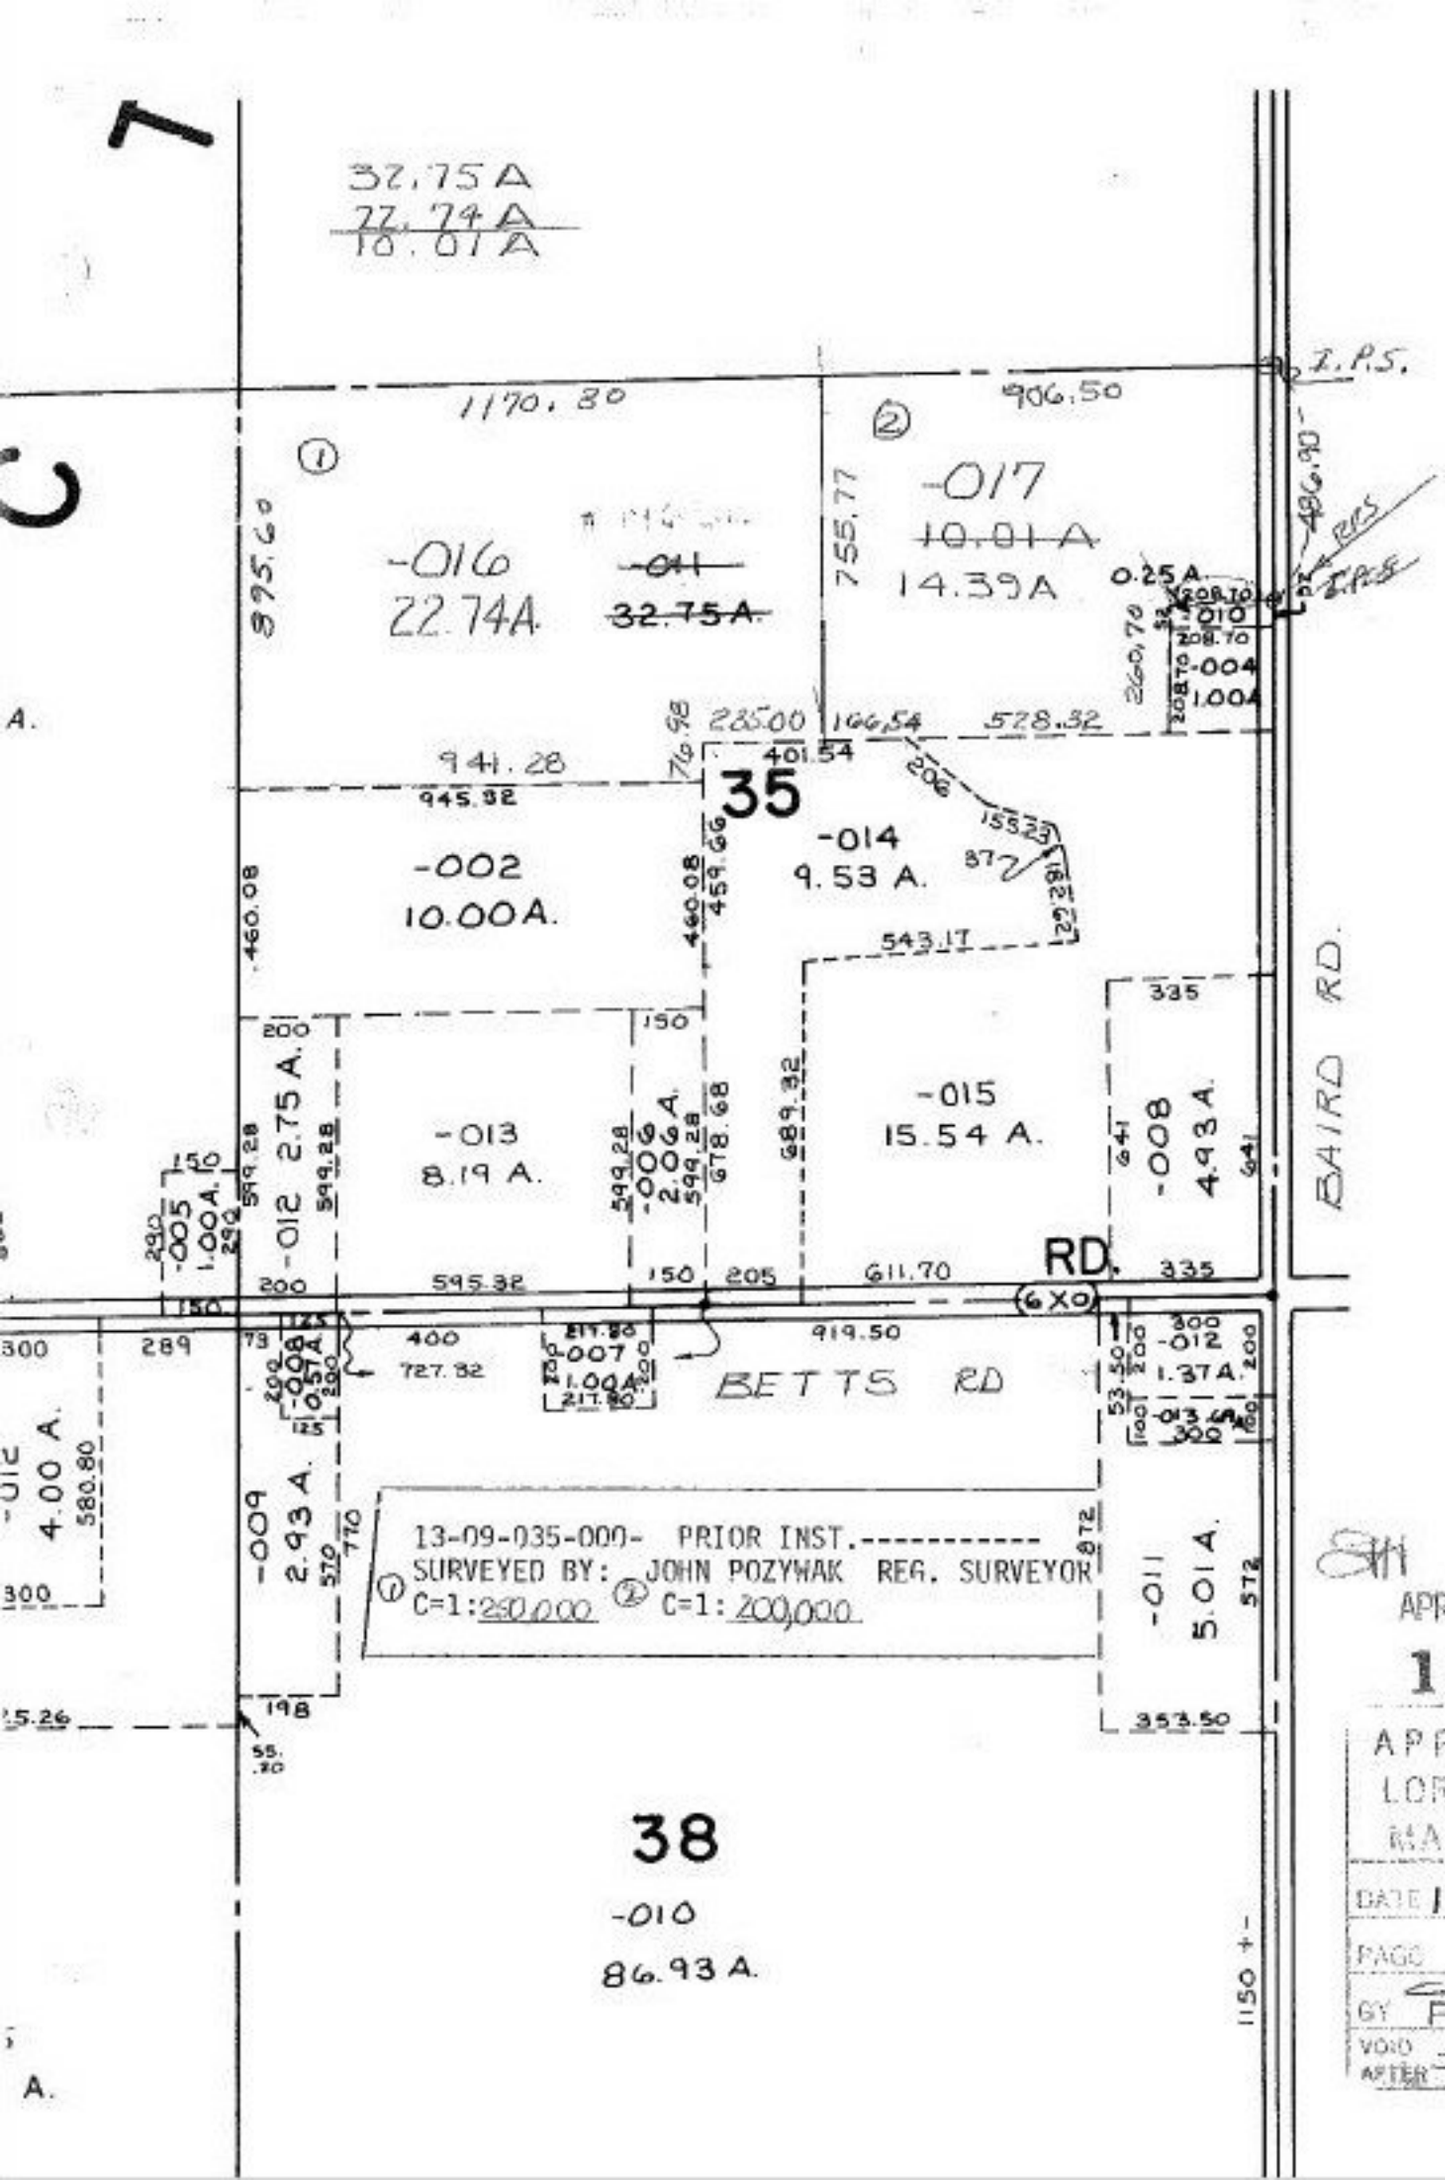

APR 14 1992

19652

APPROVED
LORAIN CO.
MAP DEPT.
DATE 12-6-91
PAGE 13-E
BY ROZYN FRANCIS
VOID AFTER # 19652