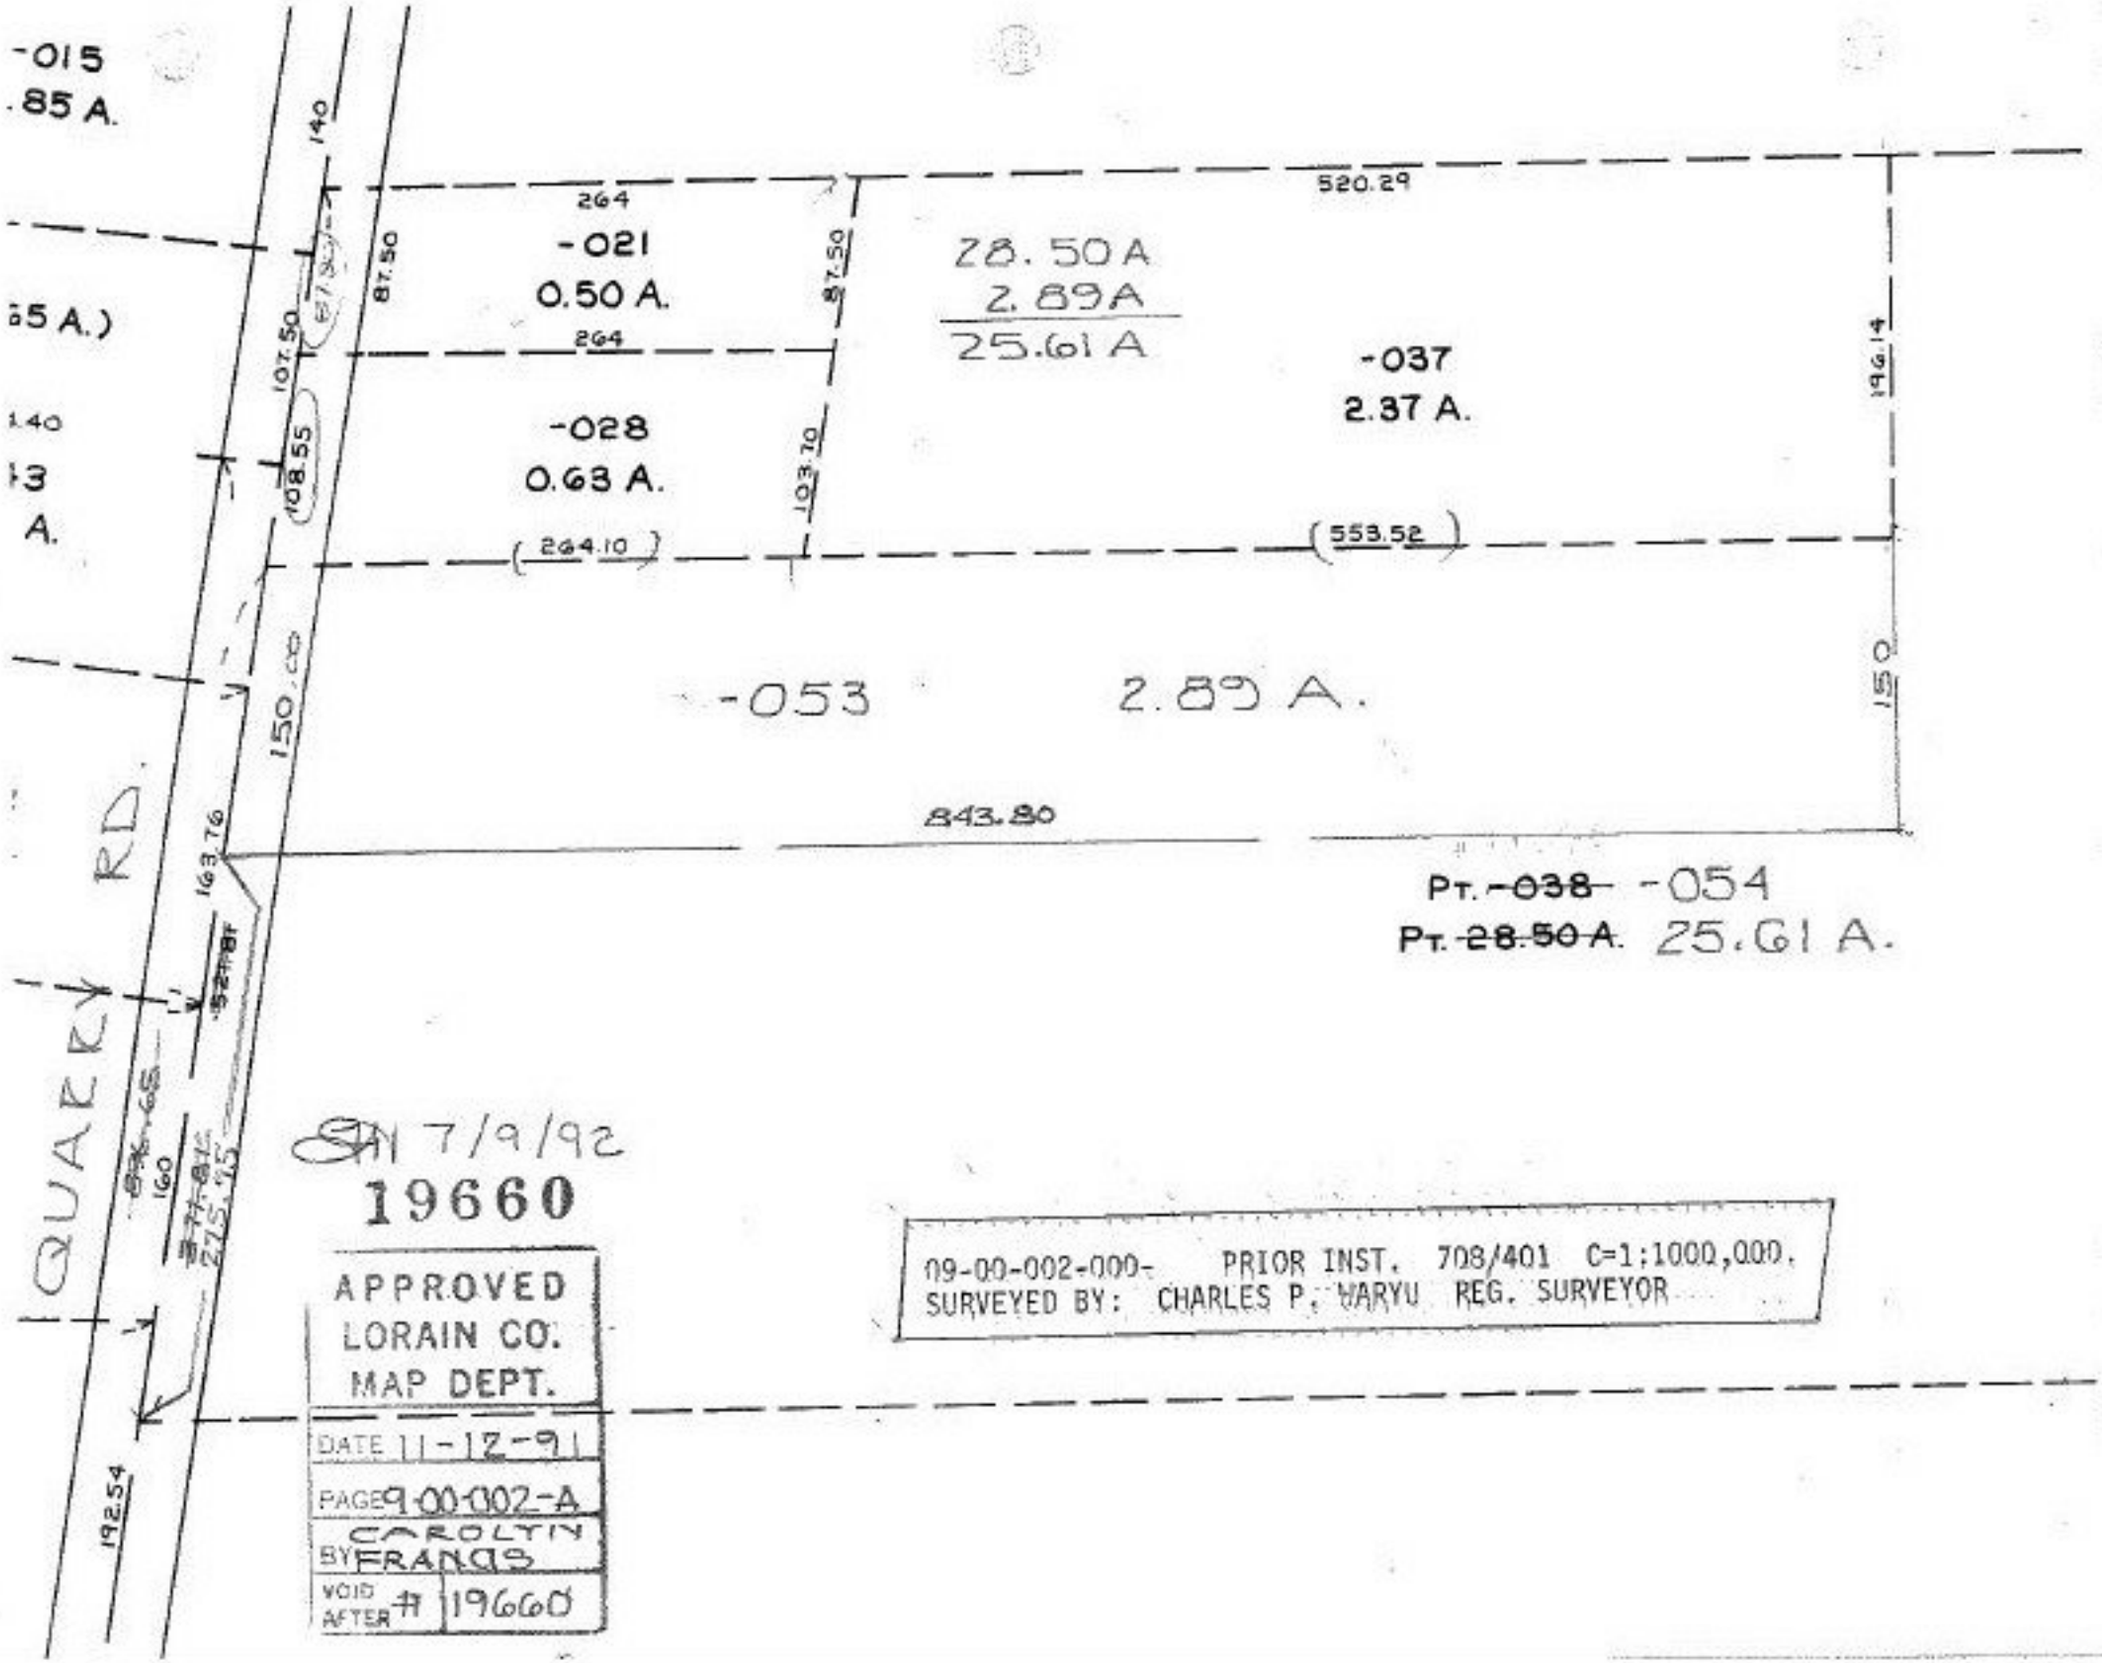
-015
.85 A.
140
264
-021
0.50 A.
87.50
87.50
28.50 A
2.89 A
25.61 A
520.29
264
-037
2.37 A.
196.14
107.50
108.55
-028
0.63 A.
103.70
(264.10)
(553.52)
150.00
-053
2.89 A.
150
843.80
163.76
Pt. ~~-038~~ -054
Pt. ~~28.50 A.~~ 25.61 A.
QUARRY RD.
160
275.95
192.54
7/9/92
19660
APPROVED
LORAIN CO.
MAP DEPT.
DATE 11-12-91
PAGE 9-00-002-A
BY CAROLYN FRANCIS
VOID AFTER # 19660
09-00-002-000- PRIOR INST. 708/401 C=1:1000,000.
SURVEYED BY: CHARLES P. WARYU REG. SURVEYOR