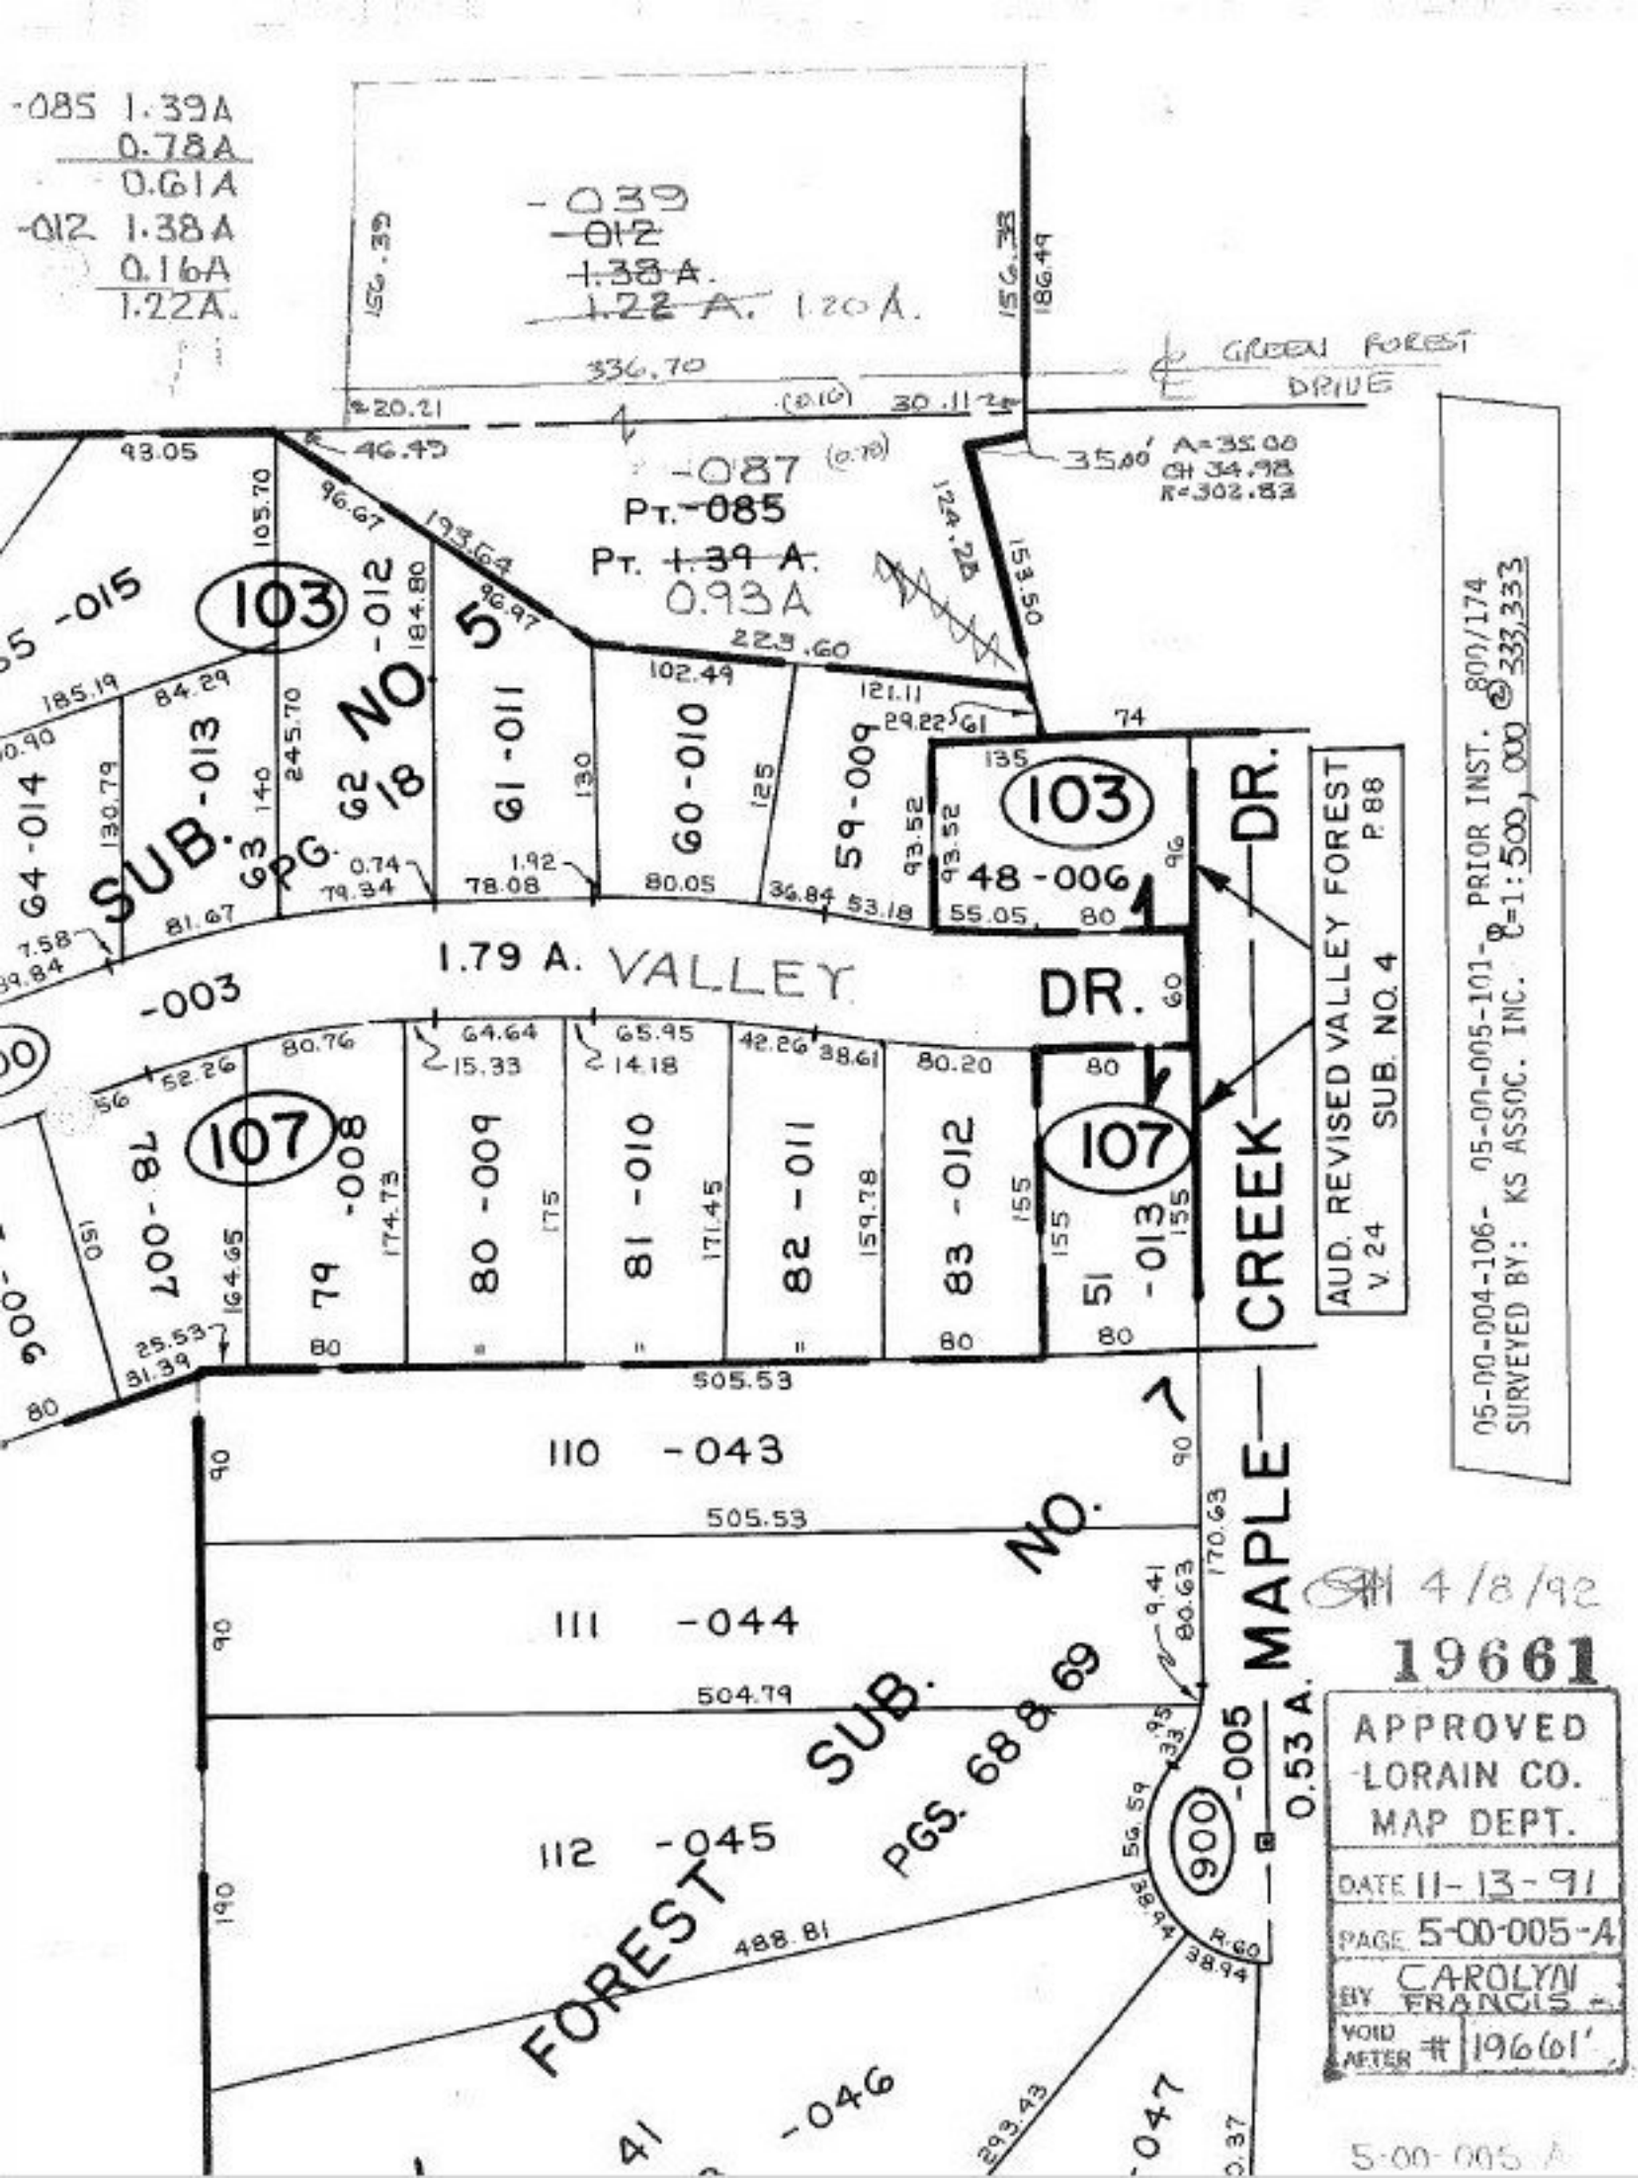
-085 1.39A
0.78A
0.61A
-012 1.38A
0.16A
1.22A.
-039
-012
1.38 A.
1.22 A. 1.20 A.
GREEN FOREST DRIVE
336.70
30.11
35.00' A=35.00
CH 34.98
R=302.83
-087 (0.78)
PT. -085
PT. 1.39 A.
0.93A
103
-012
SUB. NO. 5
PG. 62
18
63
-013
64-014
61-011
60-010
59-009
103
48-006
DR.
1.79 A. VALLEY DR.
-003
107
78-007
79-008
80-009
81-010
82-011
83-012
107
51-013
CREEK
AUD. REVISED VALLEY FOREST SUB. NO. 4
V. 24 P. 88
05-00-004-106- 05-00-005-101- PRIOR INST. 800/174
SURVEYED BY: KS ASSOC. INC. @1:500, 000 @ 333,333
110 -043
111 -044
112 -045
505.53
504.79
488.81
MAPLE
SUB.
PGS. 68 & 69
FOREST
900
-005
0.53 A.
-046
-047
4/8/92
19661
APPROVED
LORAIN CO.
MAP DEPT.
DATE 11-13-91
PAGE 5-00-005-A
BY CAROLYN FRANCIS
VOID AFTER # 19661'
5-00-005 A