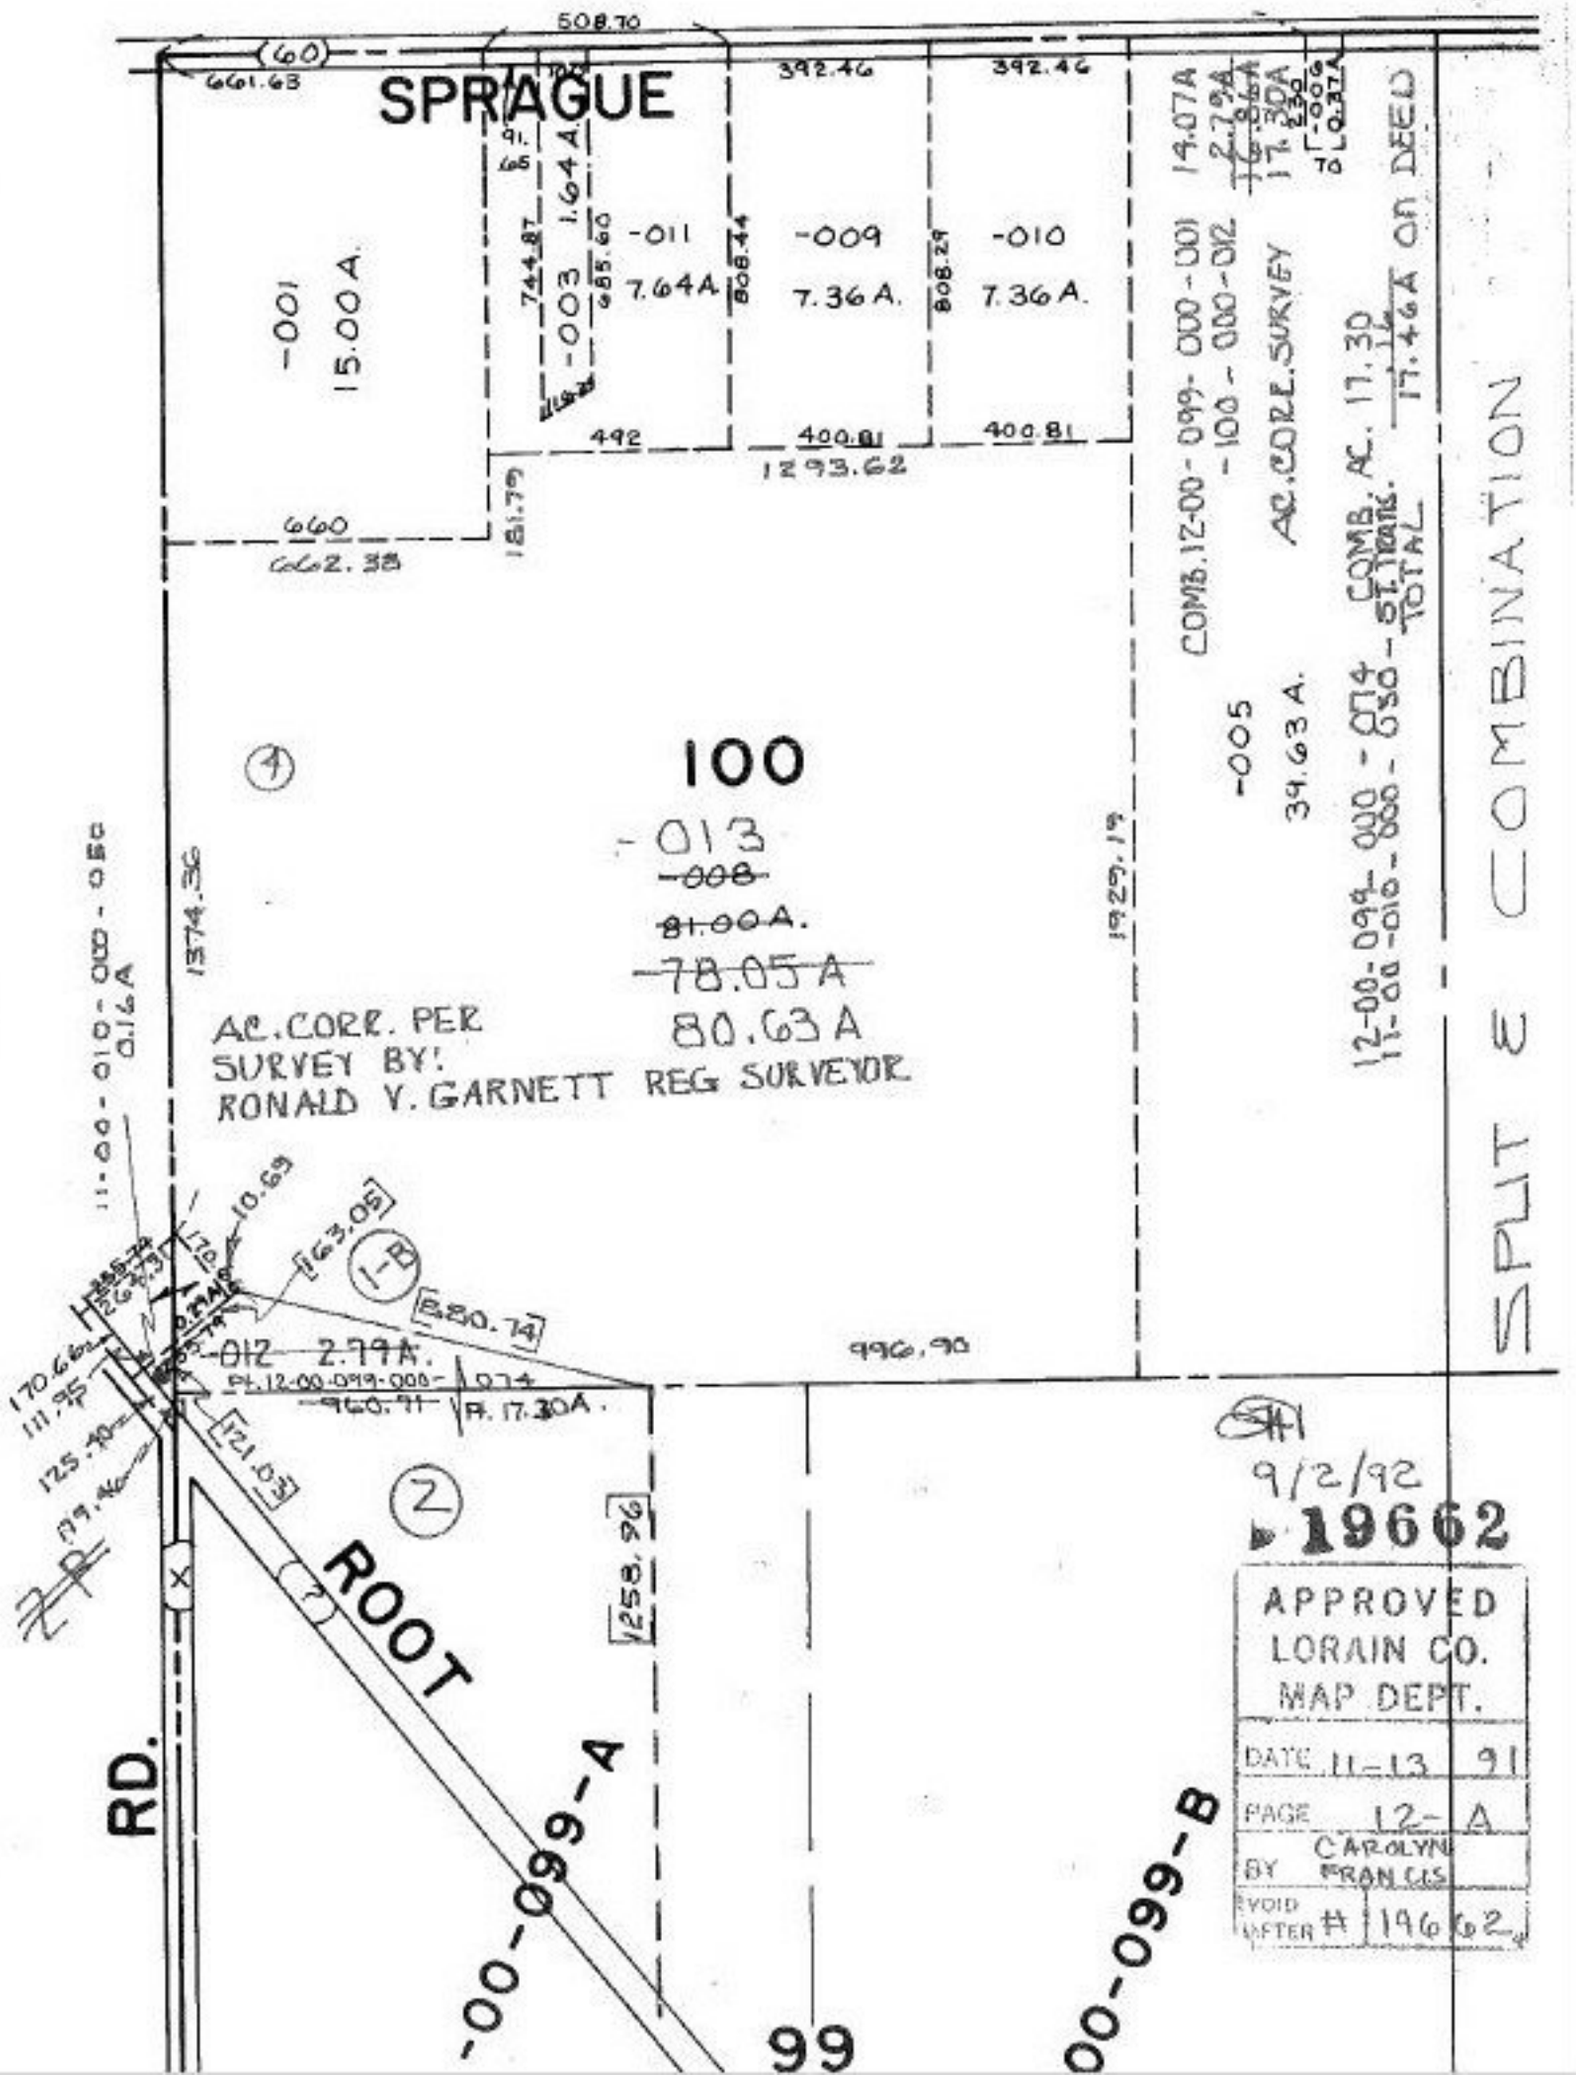
SPRAGUE
ROOT
RD.
SPLIT & COMBINATION
100
-013
~~-008~~
~~81.00A.~~
~~78.05A~~
80.63A
AC.CORR. PER
SURVEY BY:
RONALD V. GARNETT REG SURVEYOR
-001
15.00A.
-003
1.64A.
-011
7.64A.
-009
7.36A.
-010
7.36A.
-005
39.63A.
-012 2.79A.
-00-099-A
-00-099-B
99
9/2/92
19662
APPROVED
LORAIN CO.
MAP DEPT.
DATE 11-13 91
PAGE 12-A
BY CAROLYN FRANCIS
VOID AFTER # 19662