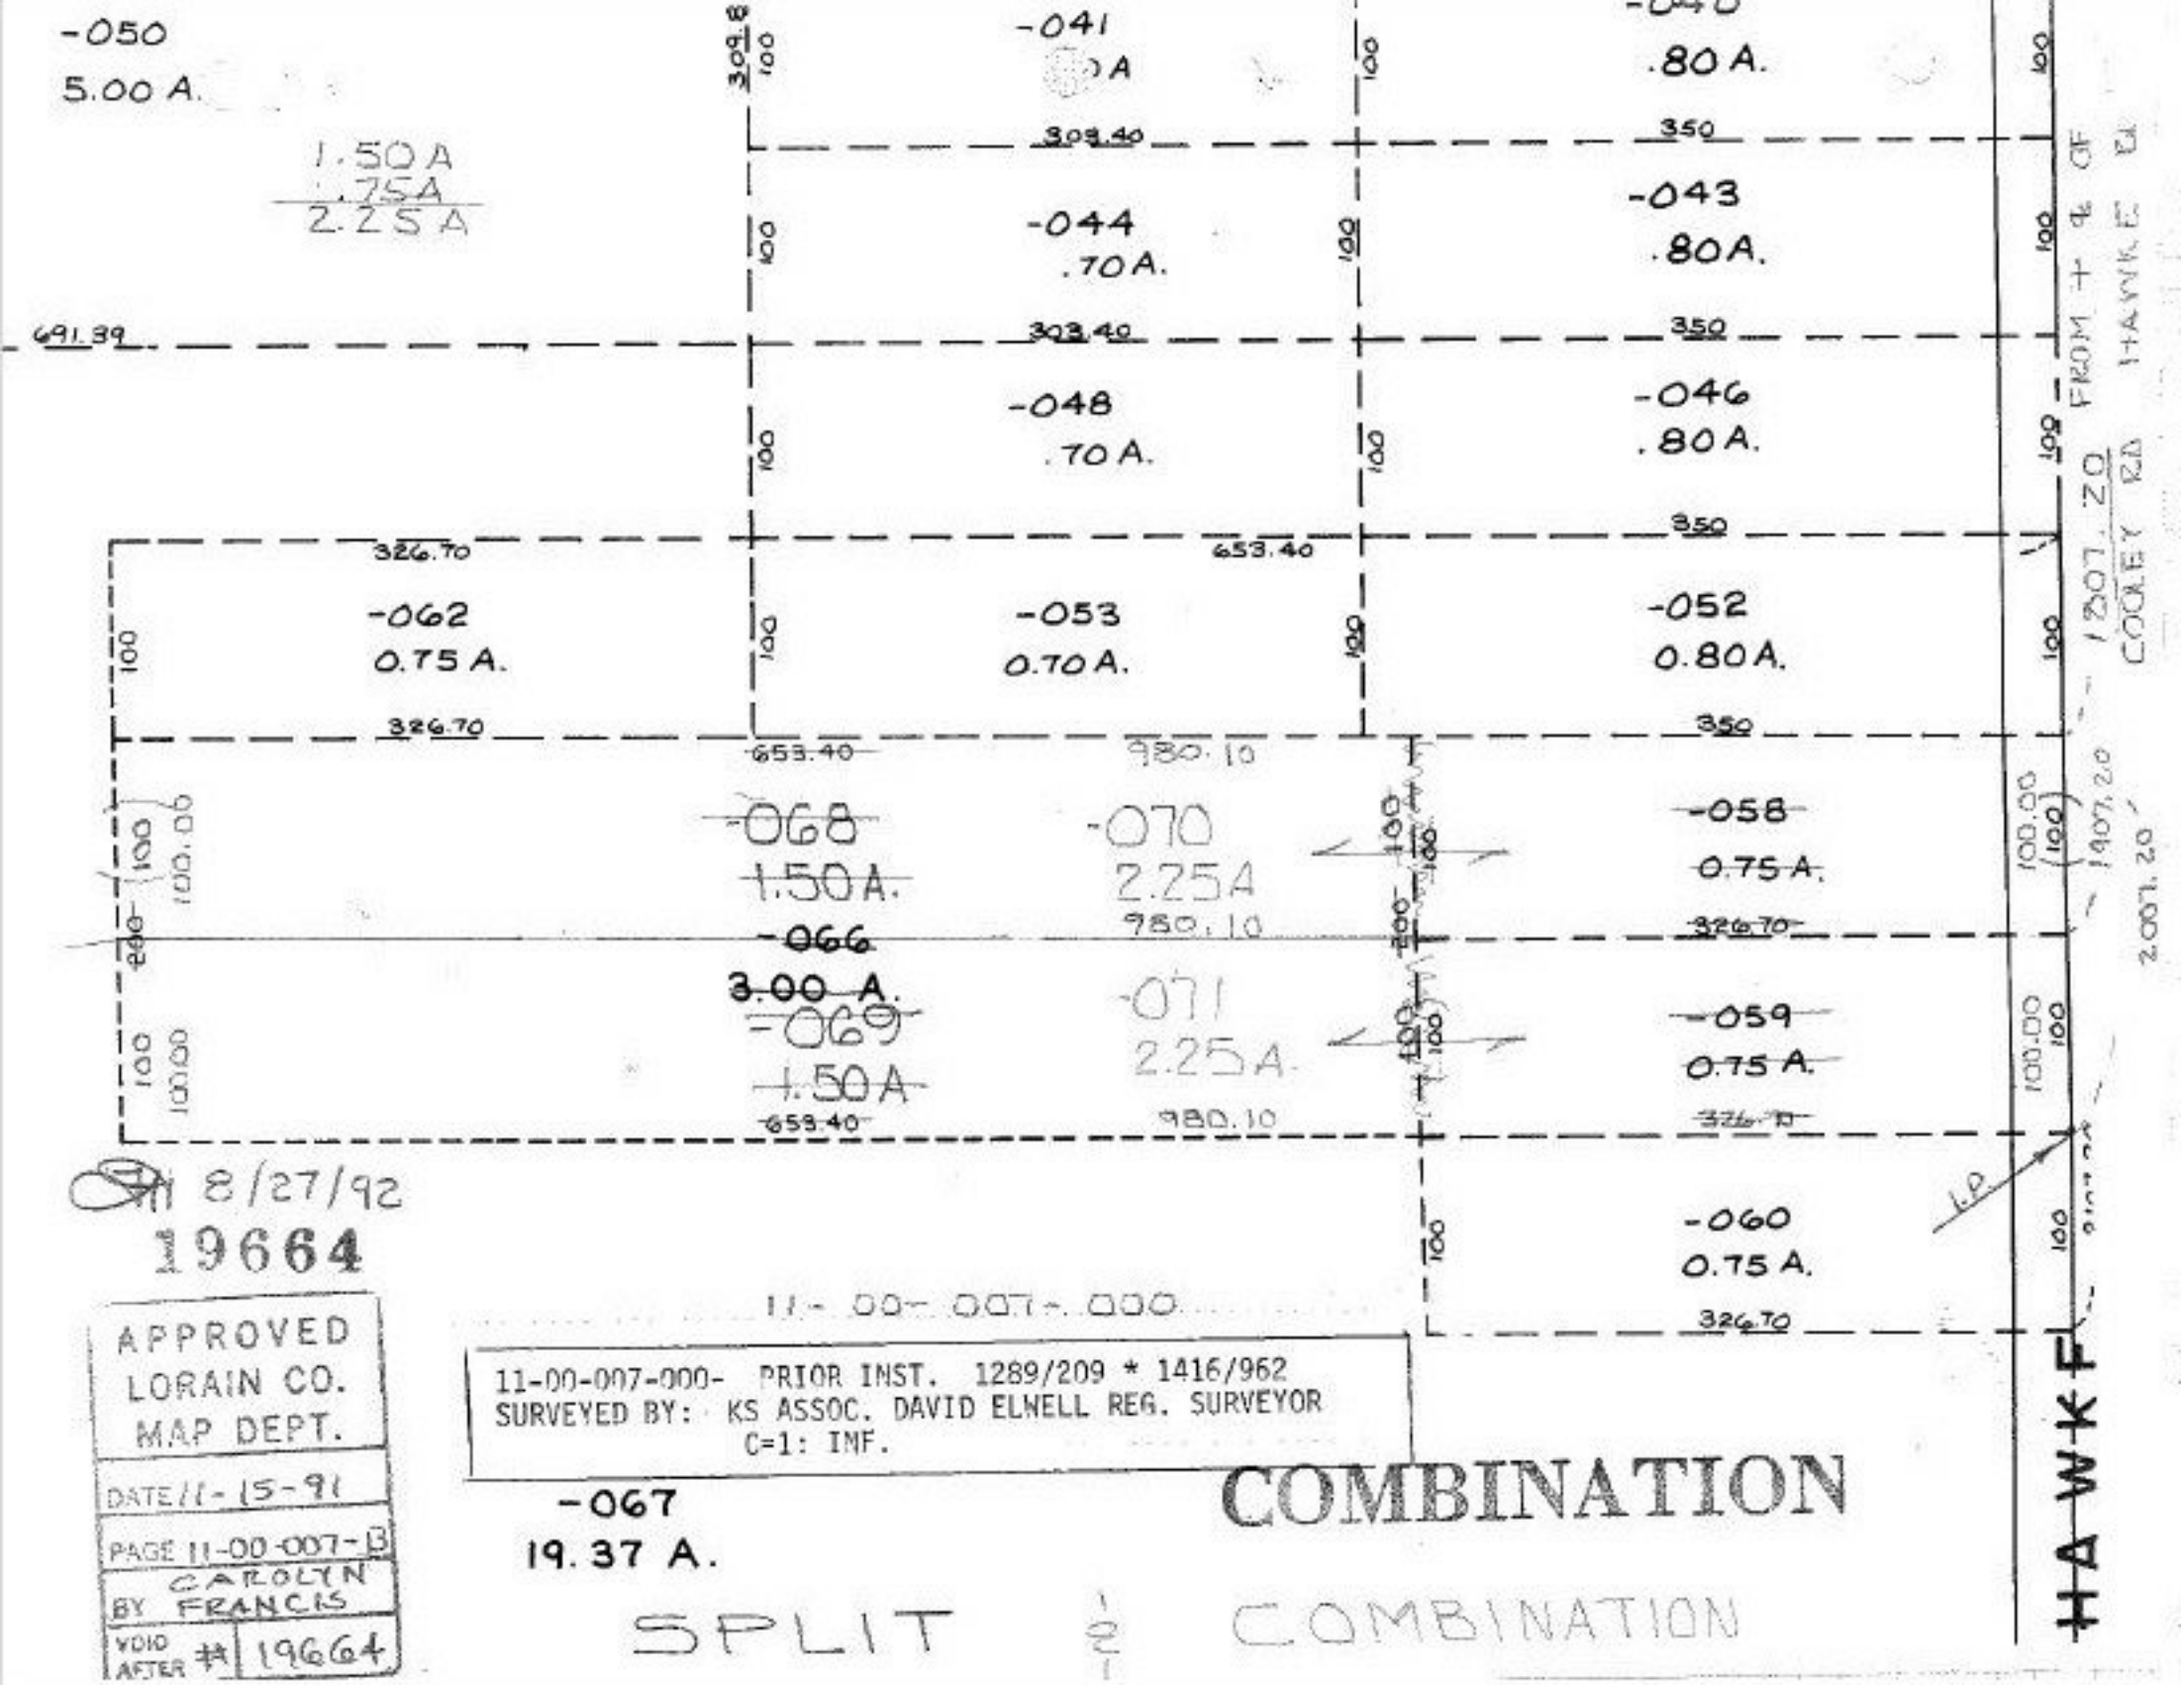
-050
5.00 A.
1.50A
.75A
2.25A
-041
.80 A.
-044
.70A.
-043
.80A.
-048
.70A.
-046
.80A.
-062
0.75 A.
-053
0.70A.
-052
0.80A.
-068
1.50A.
-066
3.00 A.
-069
1.50A
-070
2.25A
-071
2.25A.
-058
0.75A.
-059
0.75 A.
-060
0.75 A.
309.40
350
691.39
326.70
653.40
980.10
100.00
HAWKINS
FROM 4 + 1807.20
1907.20
2207.20
8/27/92
19664
APPROVED
LORAIN CO.
MAP DEPT.
DATE 11-15-91
PAGE 11-00-007-B
BY CAROLYN FRANCIS
VOID AFTER # 19664
11-00-007-000
11-00-007-000- PRIOR INST. 1289/209 * 1416/962
SURVEYED BY: KS ASSOC. DAVID ELNELL REG. SURVEYOR
C=1: IMF.
-067
19.37 A.
COMBINATION
SPLIT
1/2
COMBINATION
HAWKINS