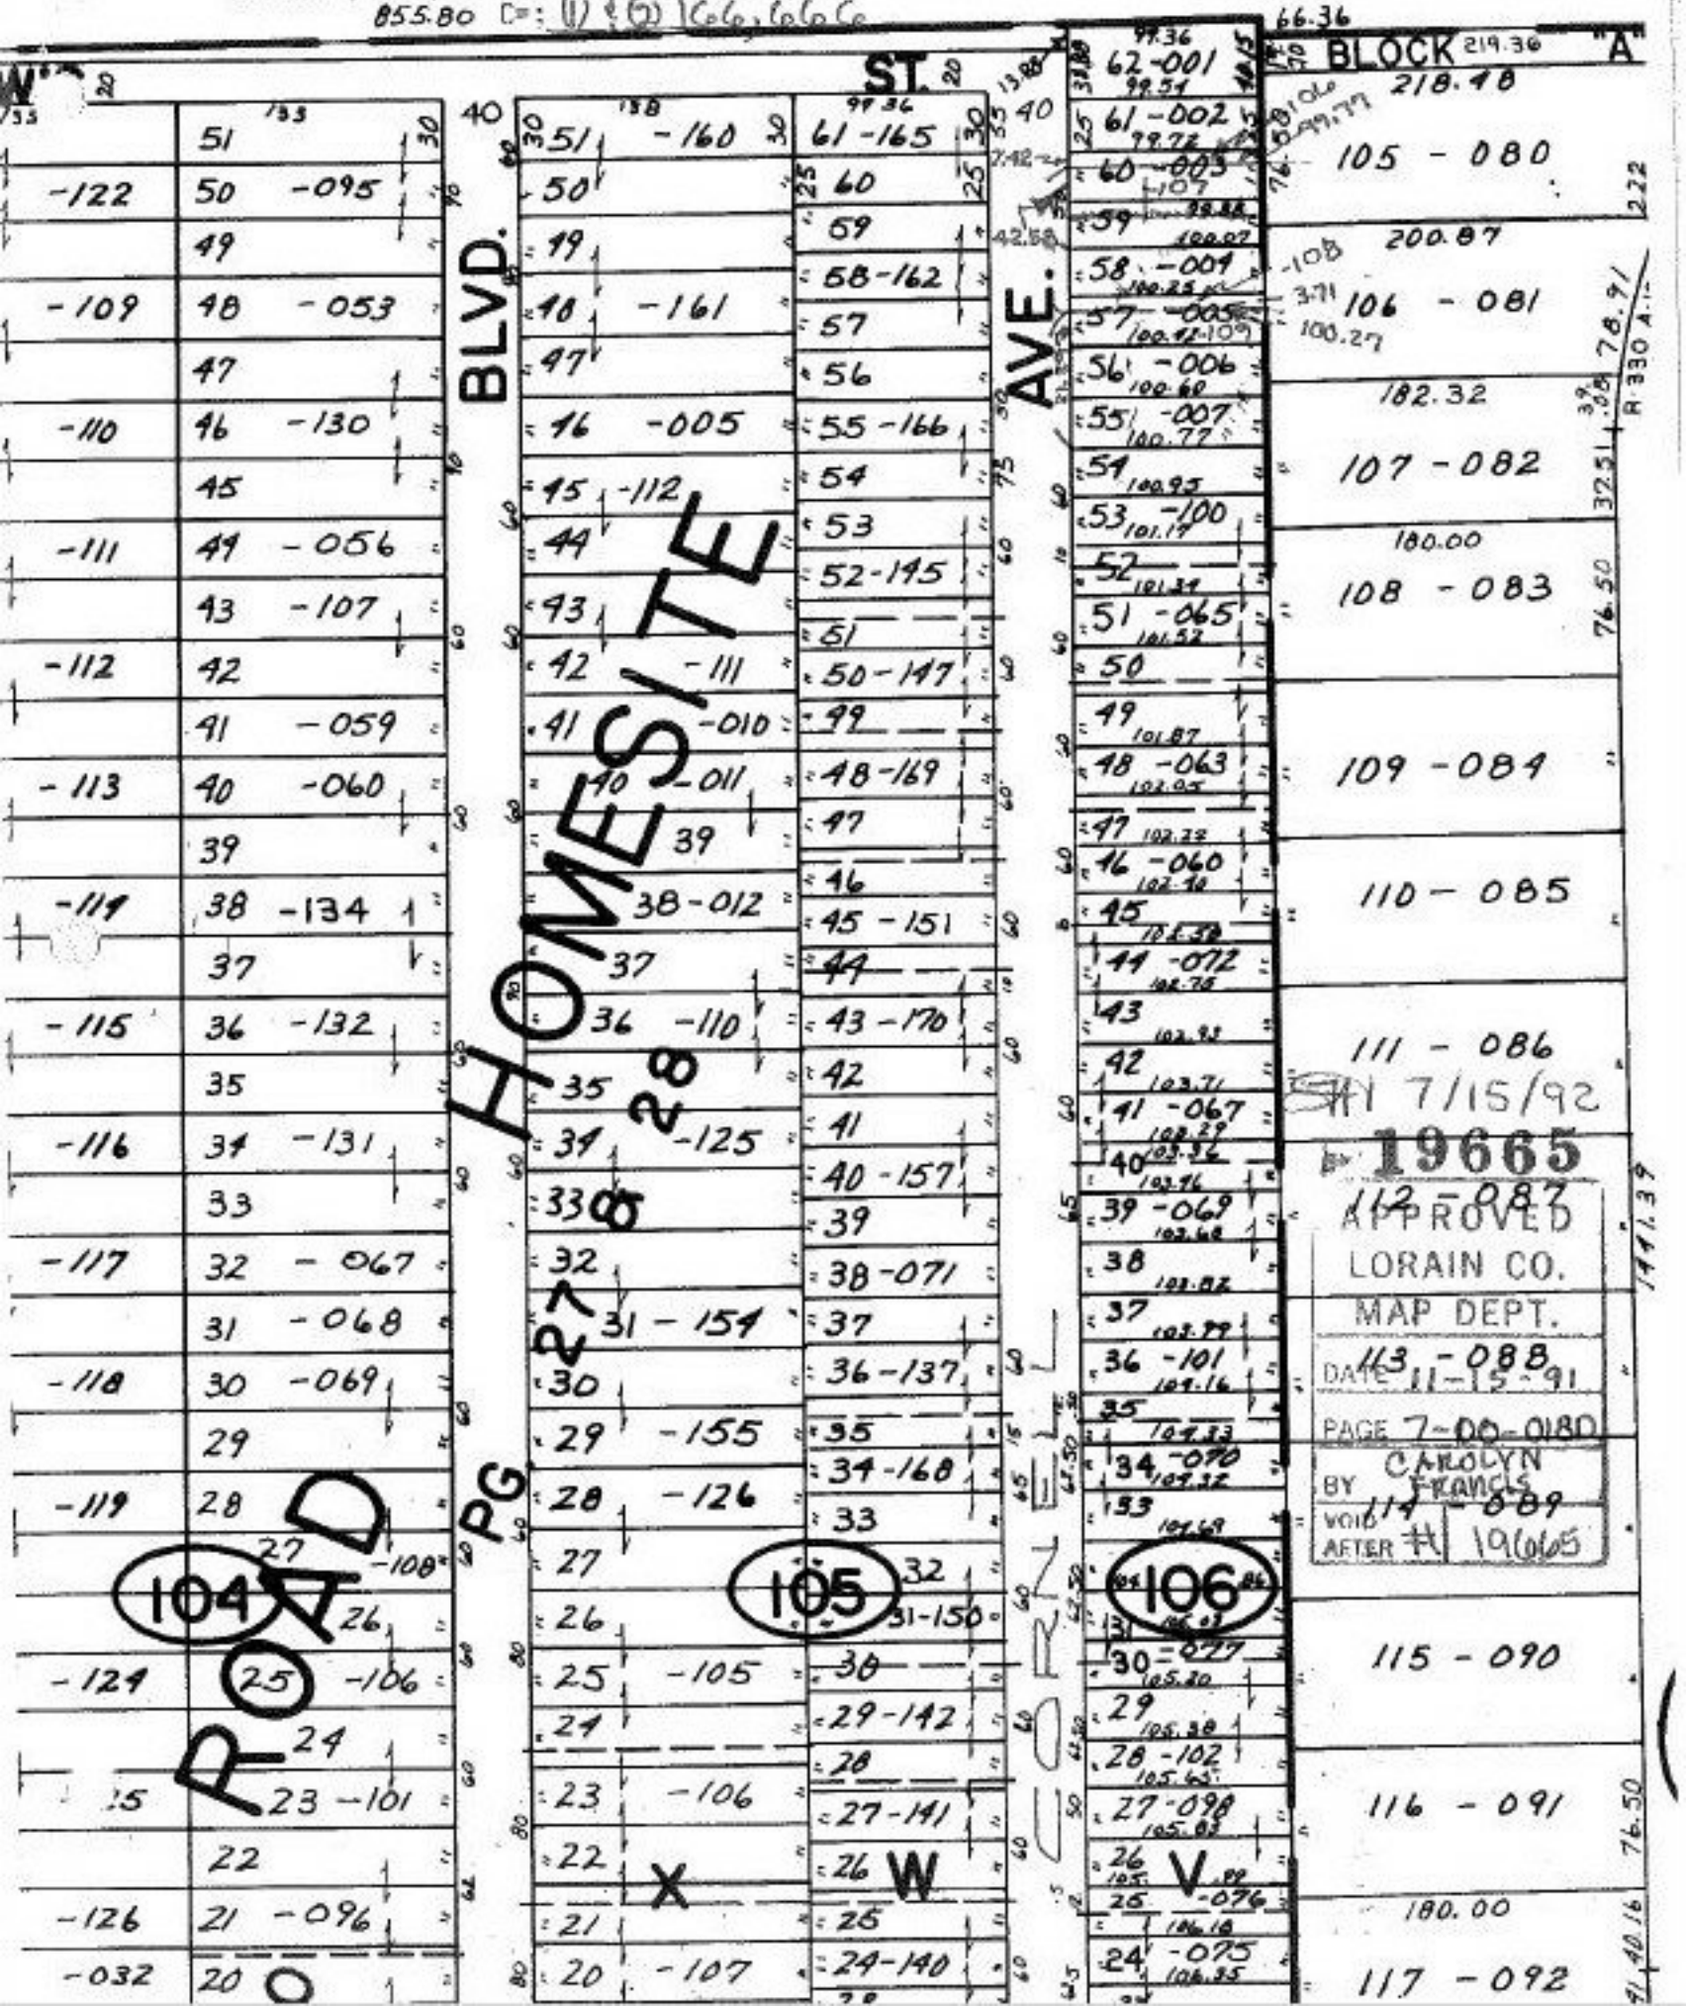07-00-018-106- PRIOR INST.
SURVEYED BY: KS ASSOC, DAVID E. ELMELL REG. SURVEYOR
855.80 D=: (1) & (2) 106, 106 Co