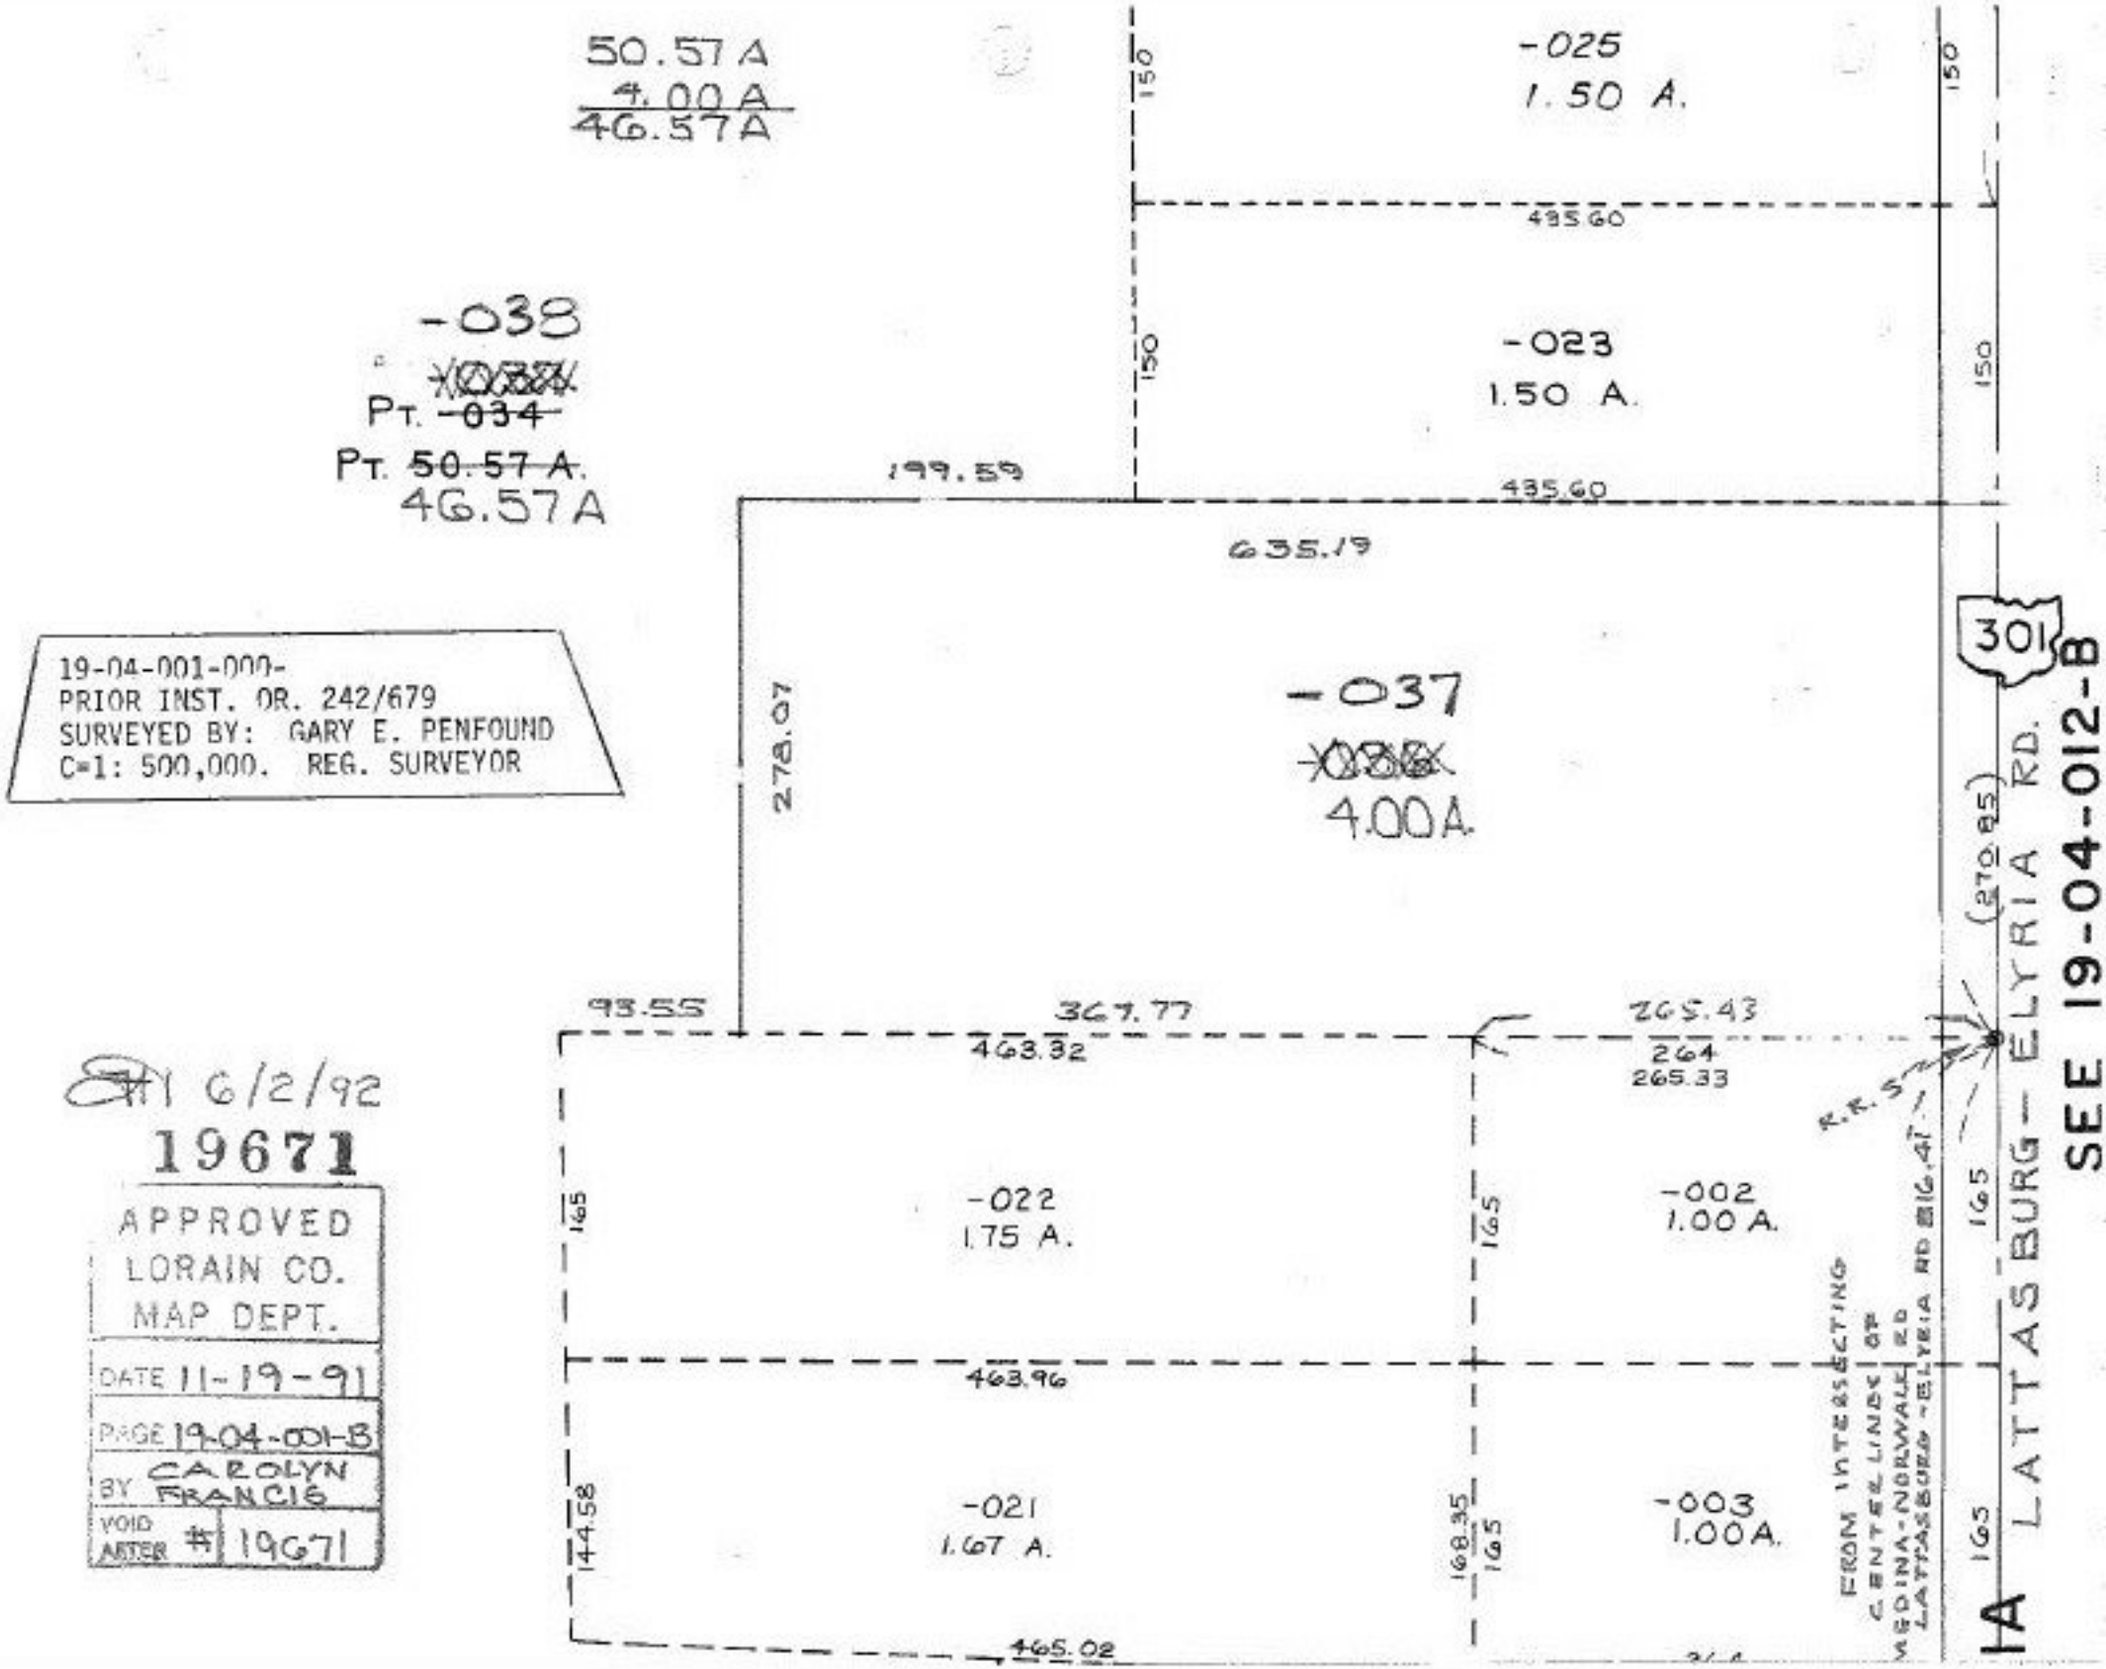
50.57 A
4.00 A
46.57 A
-025
1.50 A.
150
495.60
-038
Pt. ~~-034~~
Pt. ~~50.57 A.~~
46.57 A
-023
1.50 A.
199.59
635.19
19-04-001-000-
PRIOR INST. OR. 242/679
SURVEYED BY: GARY E. PENFOUND
C=1: 500,000. REG. SURVEYOR
278.07
-037
~~-038~~
4.00 A.
93.55
367.77
463.32
265.43
264
265.33
(270.95)
-022
1.75 A.
165
-002
1.00 A.
463.96
-021
1.67 A.
144.58
168.35
-003
1.00 A.
165.02
FROM INTERSECTING CENTER LINES OF MEDINA-NORWALK RD & LATTASBURG-ELYRIA RD 816.47'
LATTASBURG - ELYRIA RD.
SEE 19-04-012-B
6/2/92
19671
APPROVED
LORAIN CO.
MAP DEPT.
DATE 11-19-91
PAGE 19-04-001-B
BY CAROLYN FRANCIS
VOID AFTER # 19671