D 31.23 A
0.46A
80.77A

~~-042~~ -050
~~31.23 A.~~ 30.77 A.

7/9/92
**19673**

APPROVED
LORAIN CO.
MAP DEPT.
DATE 11-22-91
PAGE 9-00-004-A
BY CAROLYN FRANCIS
VOID ABSTRACT # 19673

09-00-004-101- PRIOR INST. 31/926
SURVEYED BY: GARY E. PENFOUND
C=1: INF. REG. SURVEYOR

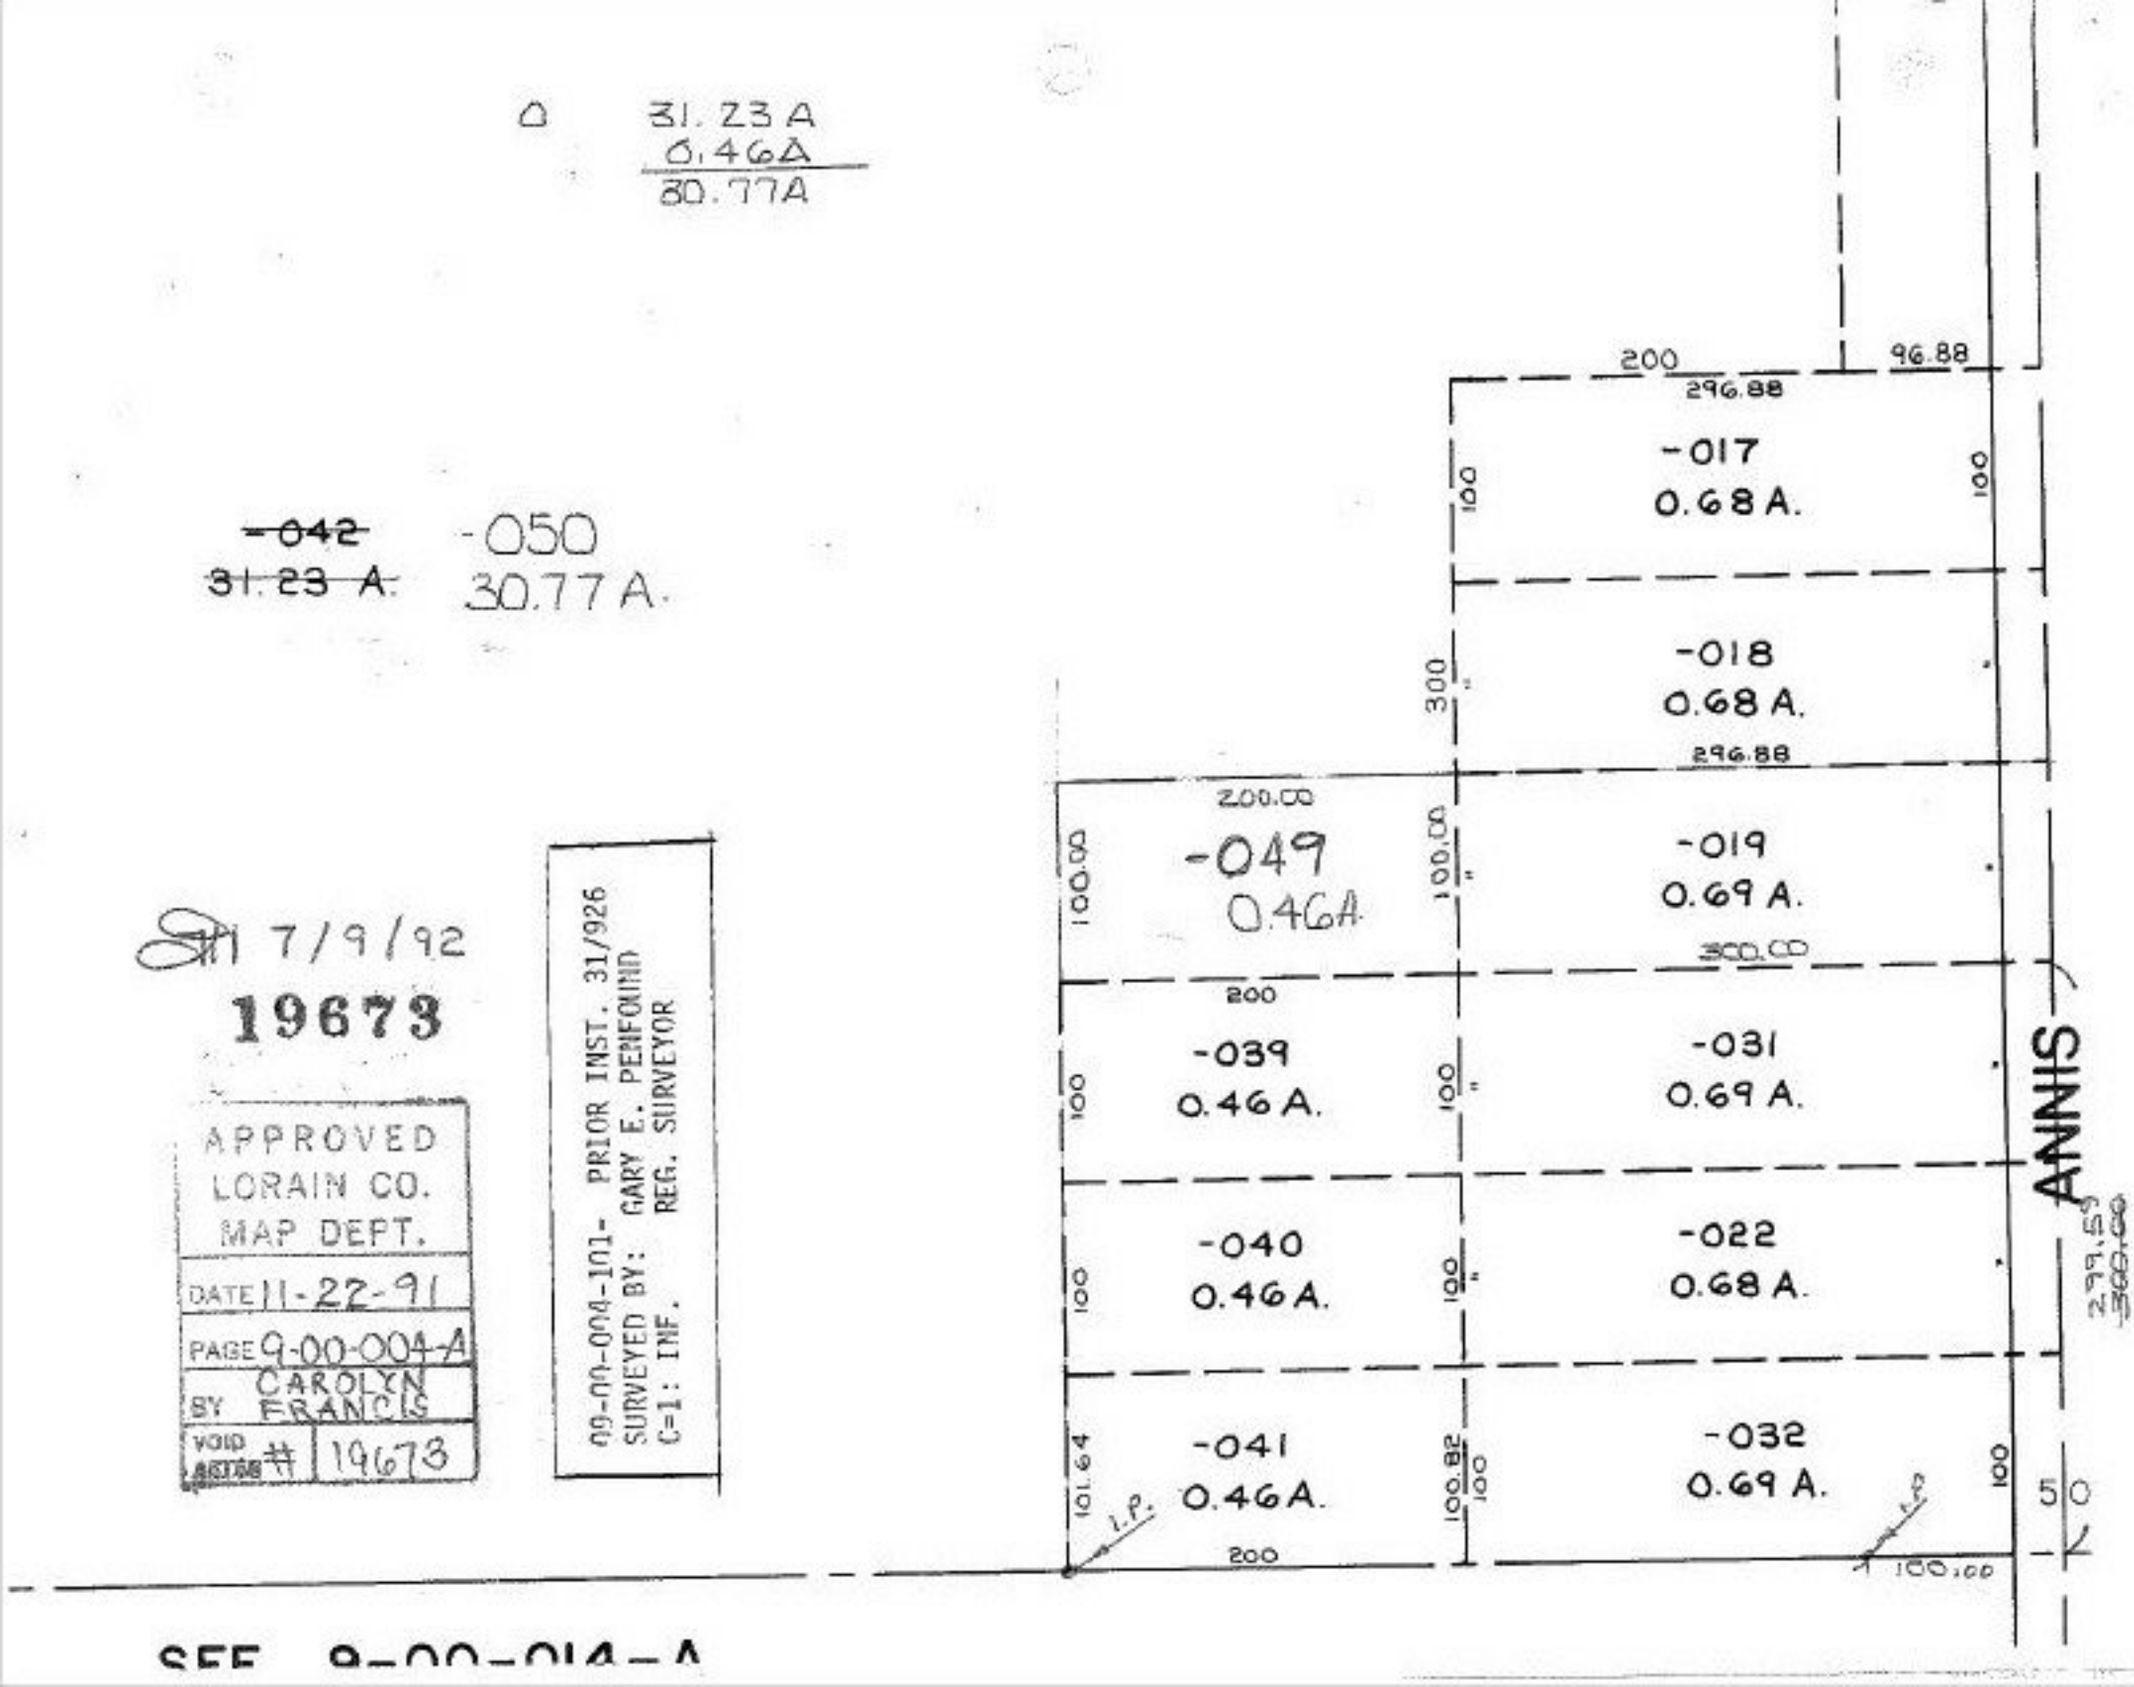


SEE 9-00-014-A