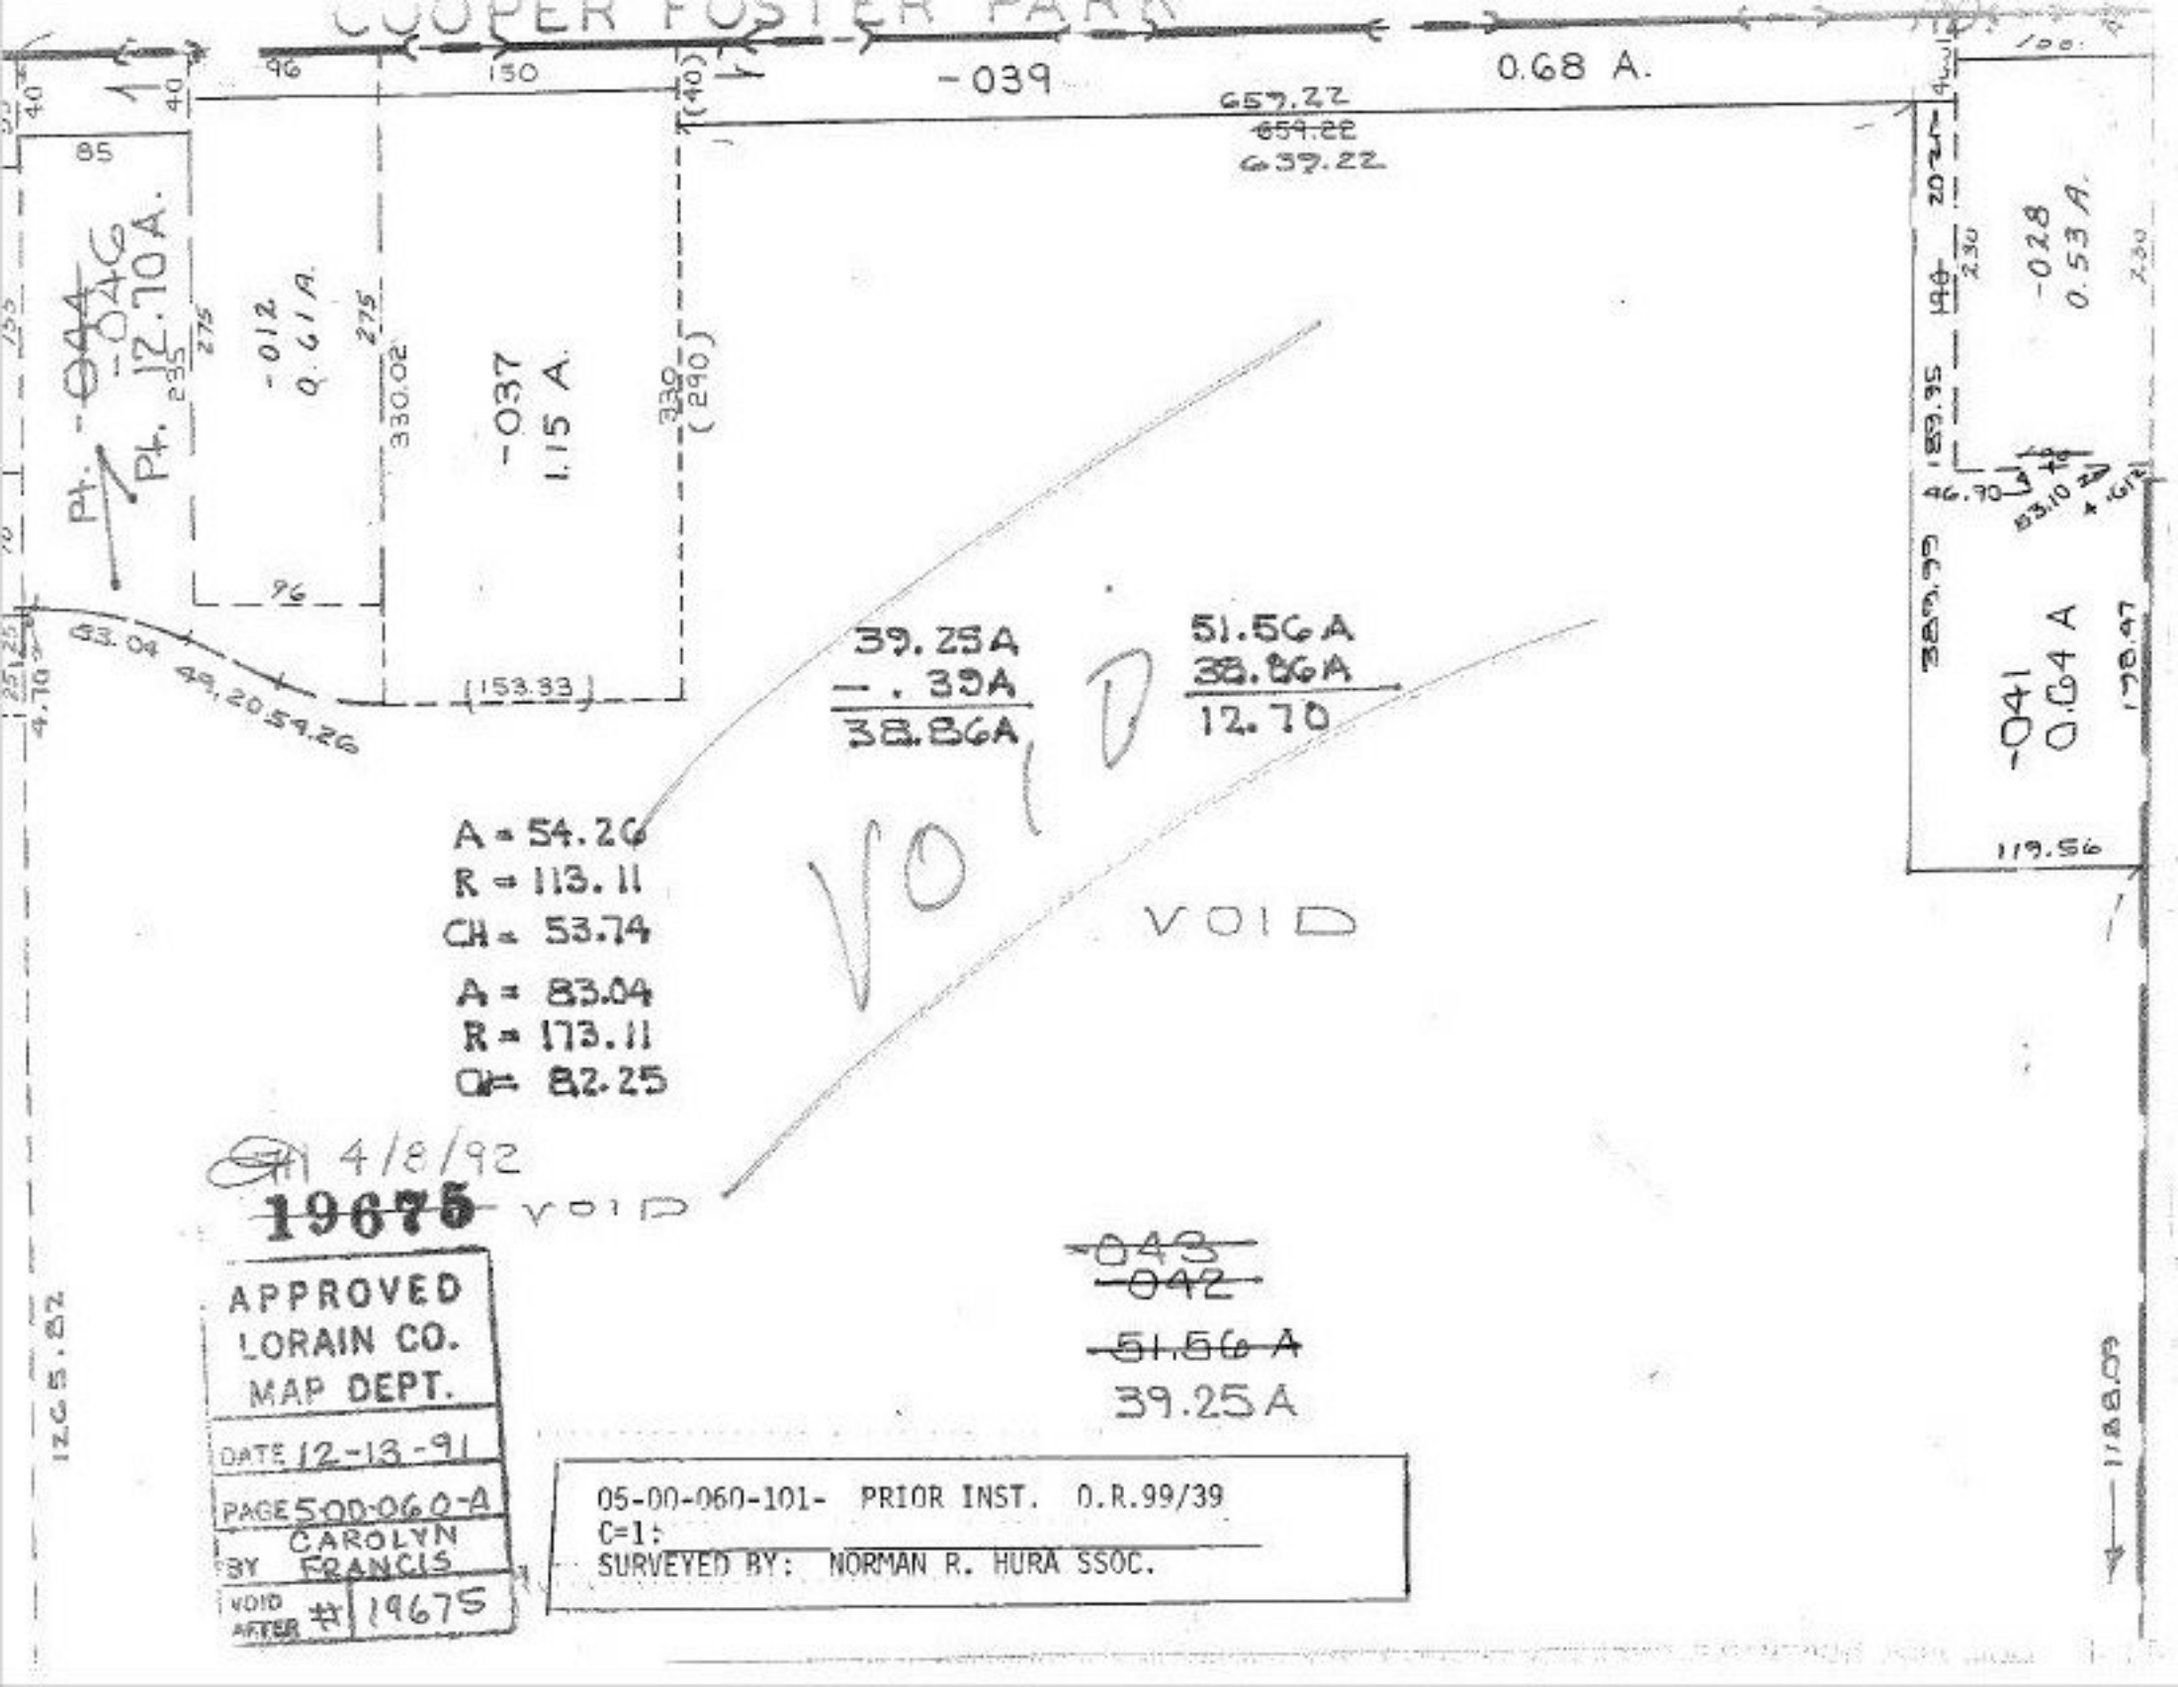
COOPER FOSTER PARK
-039
0.68 A.
657.22
654.22
639.22
-046
Pt. 12.70 A.
-012
0.61 A.
-037
1.15 A.
-028
0.53 A.
-041
0.64 A
39.25A
- .39A
38.86A
51.56A
38.86A
12.70
A = 54.26
R = 113.11
CH = 53.74
A = 83.04
R = 173.11
CH = 82.25
VOID
VOID
4/8/92
19675 VOID
-043
-042
51.56 A
39.25A
APPROVED
LORAIN CO.
MAP DEPT.
DATE 12-13-91
PAGE 500-060-A
BY CAROLYN FRANCIS
VOID AFTER # 19675
05-00-060-101- PRIOR INST. O.R.99/39
C=1:
SURVEYED BY: NORMAN R. HURA SSOC.