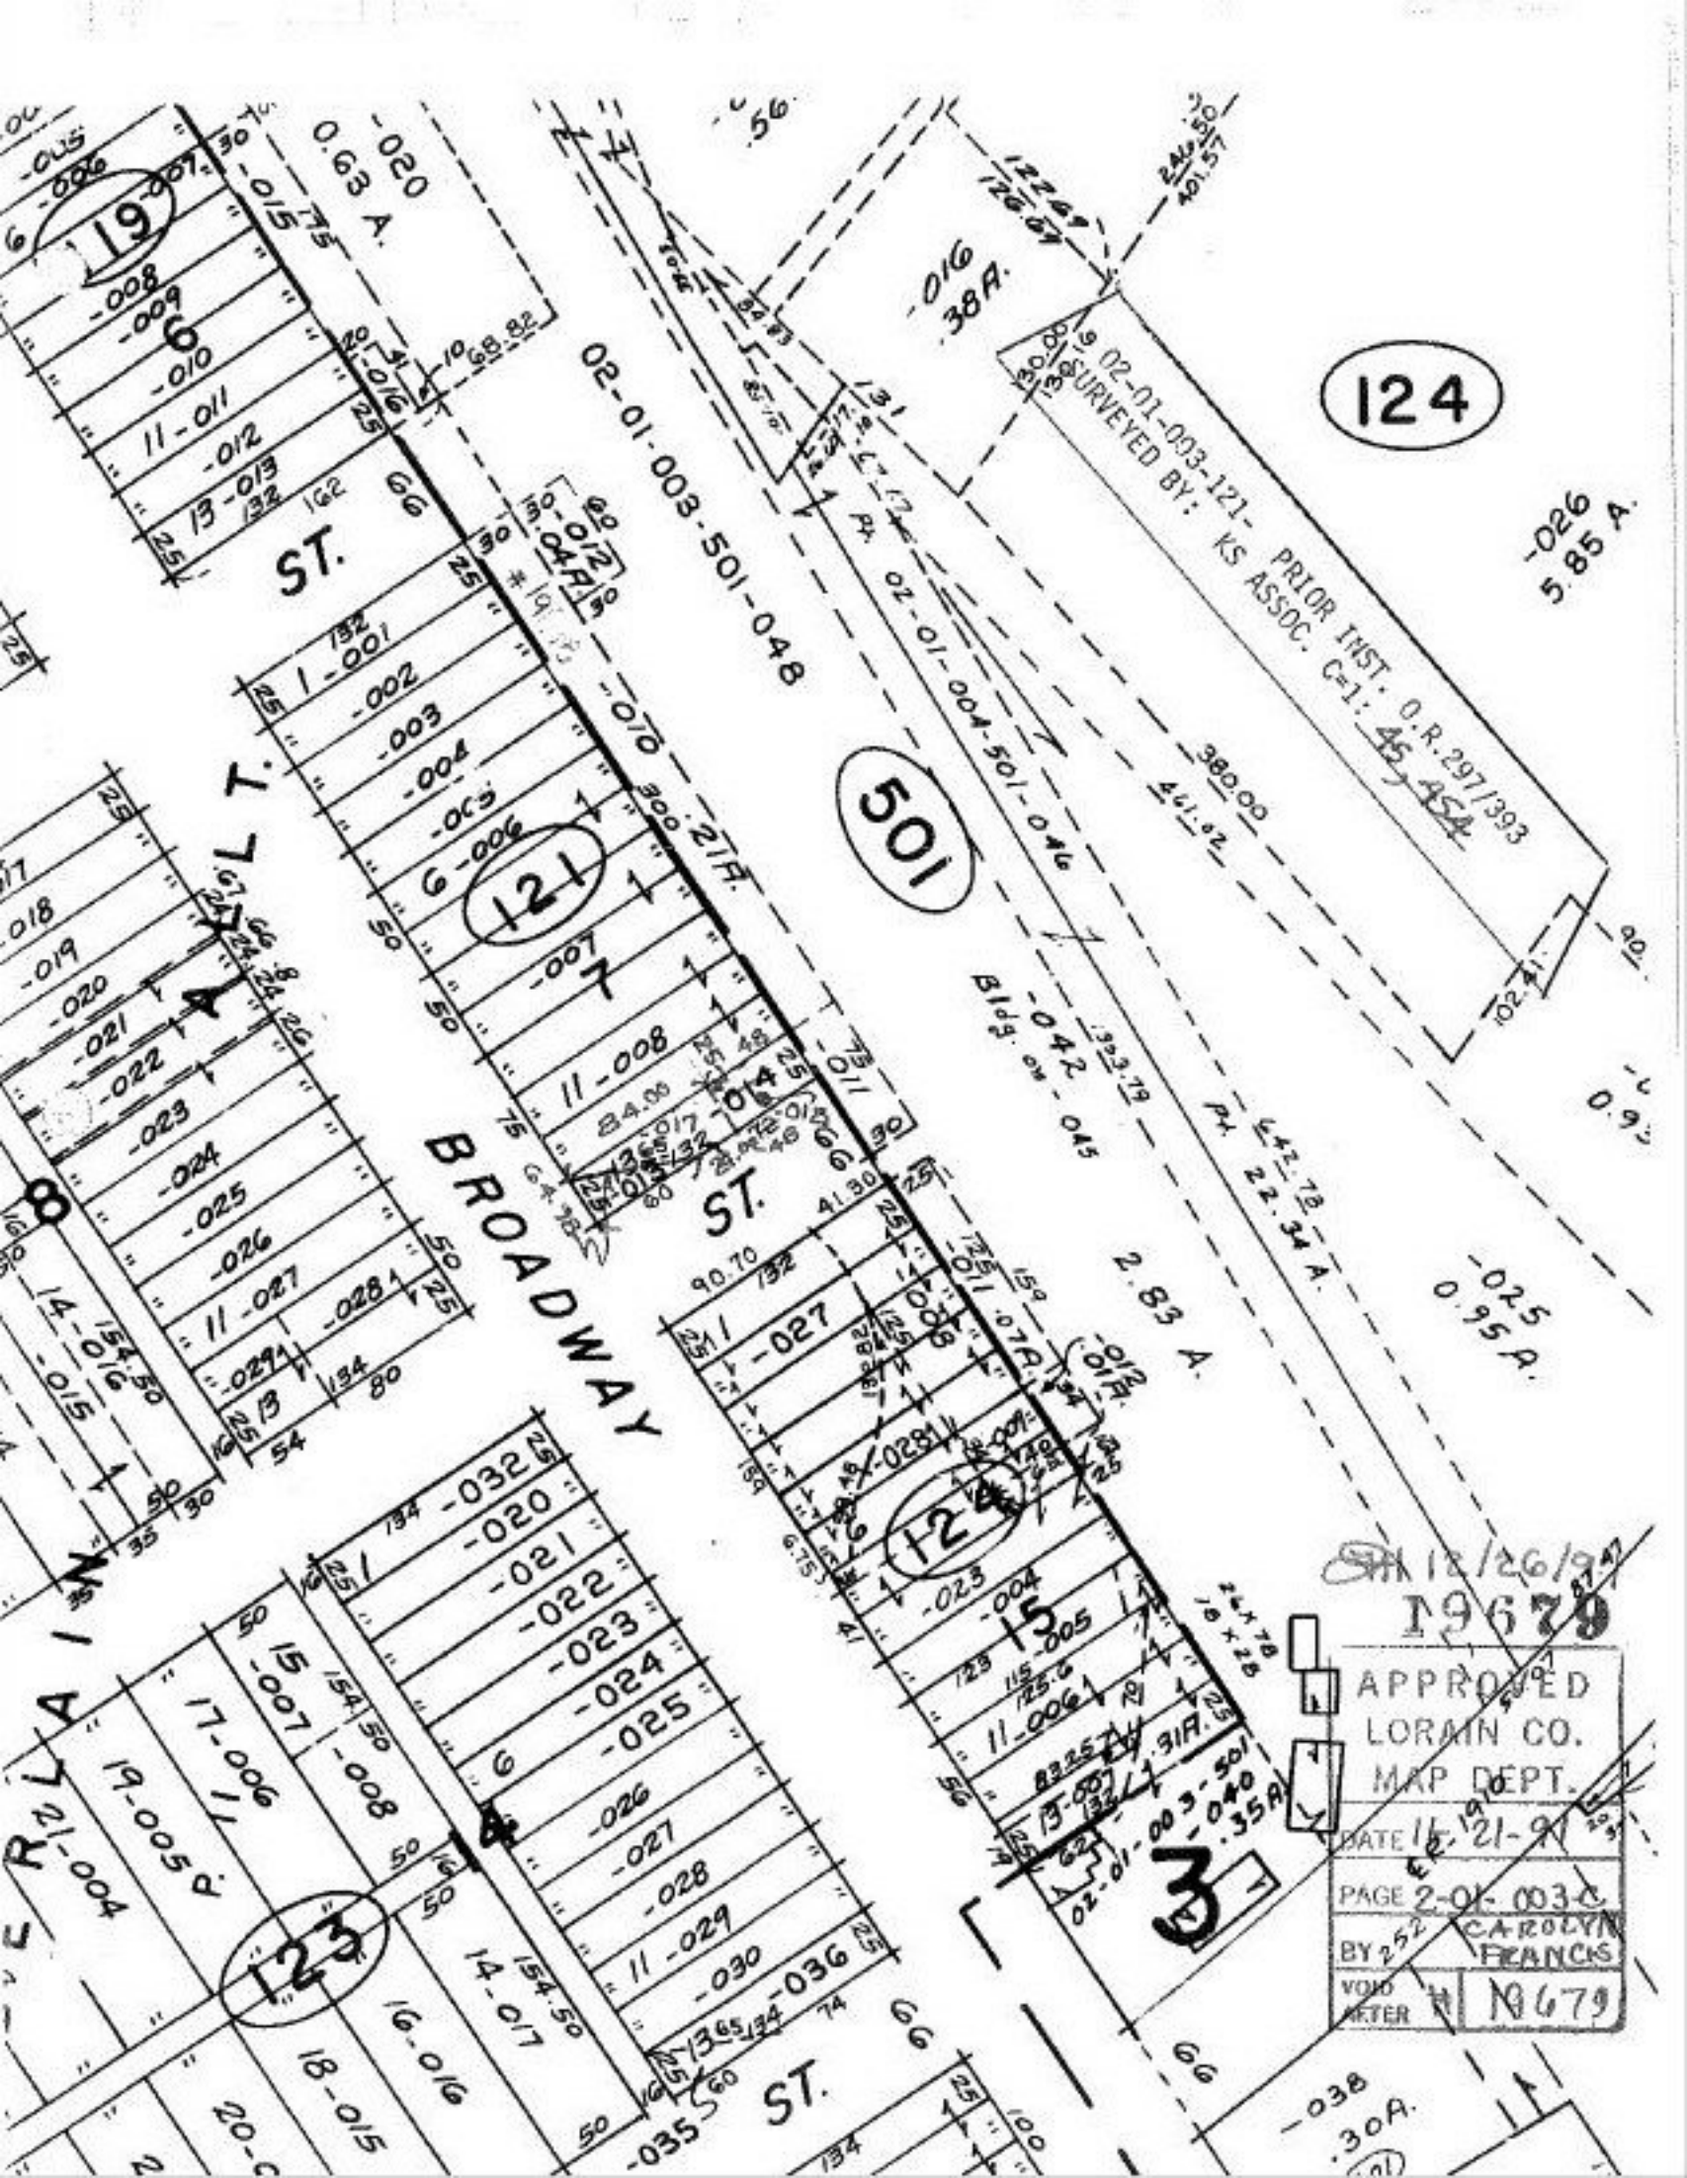
124
501
02-01-003-121- PRIOR INST. O.R. 297/393
SURVEYED BY: KS ASSOC. Co.: 45,454
02-01-003-501-048
02-01-004-501-046
-016 .38A.
-026 5.85 A.
-025 0.95 A.
-042
Bldg on -045
2.83 A.
-020 0.63 A.
-070 .21A.
-040 .35A.
BROADWAY
ST.
ST.
ST.
ALLEY
ALLEY
APPROVED
LORAIN CO.
MAP DEPT.
DATE 12-21-97
PAGE 2-01-003-C
BY CAROLYN FRANCIS
VOID AFTER 19679
12/26/97
19679