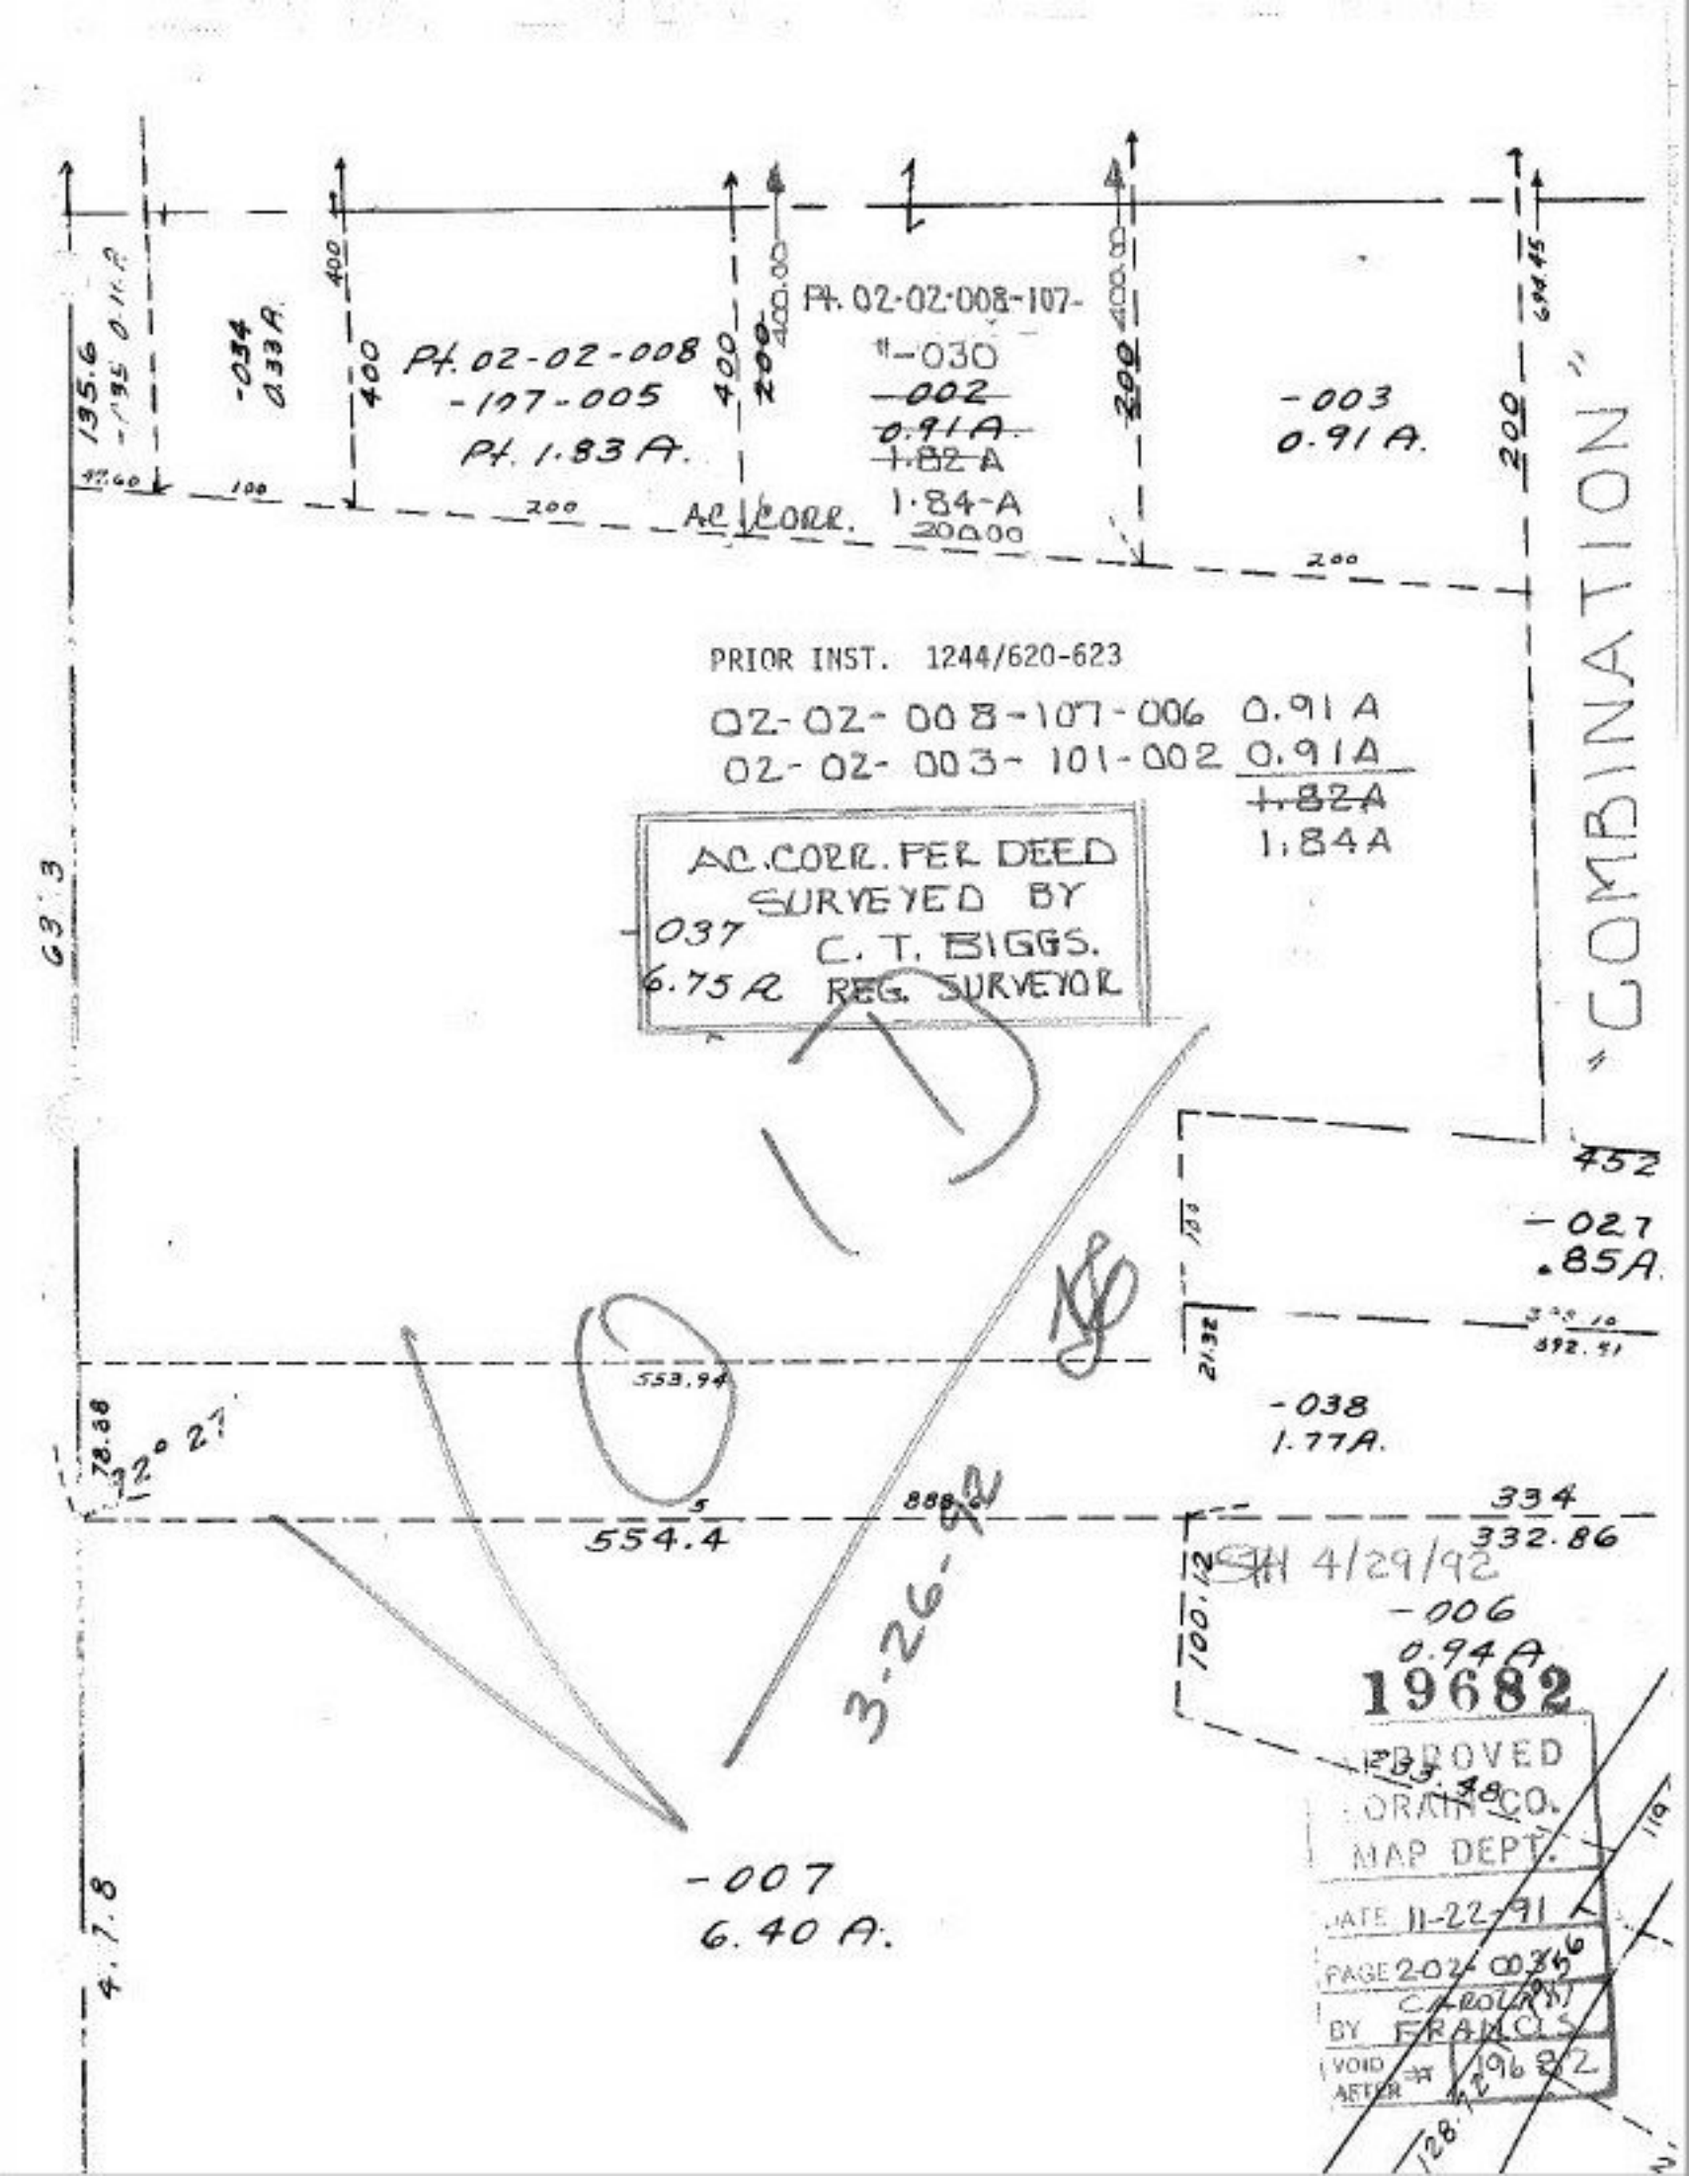
Pt. 02-02-008-107-005
Pt. 1.83 A.
-034
0.33A.
135.6
-135 0.11A.
400
200
Pt. 02-02-008-107-030
-002
0.91A
1.82 A
1.84-A
AC. COR.
-003
0.91 A.
694.45
"COMBINATION"
PRIOR INST. 1244/620-623
02-02-008-107-006 0.91 A
02-02-003-101-002 0.91A
1.82A
1.84A
AC. COR. PER DEED
SURVEYED BY
C. T. BIGGS.
REG. SURVEYOR
-037
6.75 A
693.3
452
-027
.85A.
553.94
-038
1.77A.
78.38
554.4
334
332.86
SH 4/29/92
-006
0.94A
19682
-007
6.40 A.
4.7.8
3.26.82
APPROVED
ORAIN CO.
MAP DEPT.
DATE 11-22-91
PAGE 2-02-0036
BY FRANCIS
VOID AFTER 19682