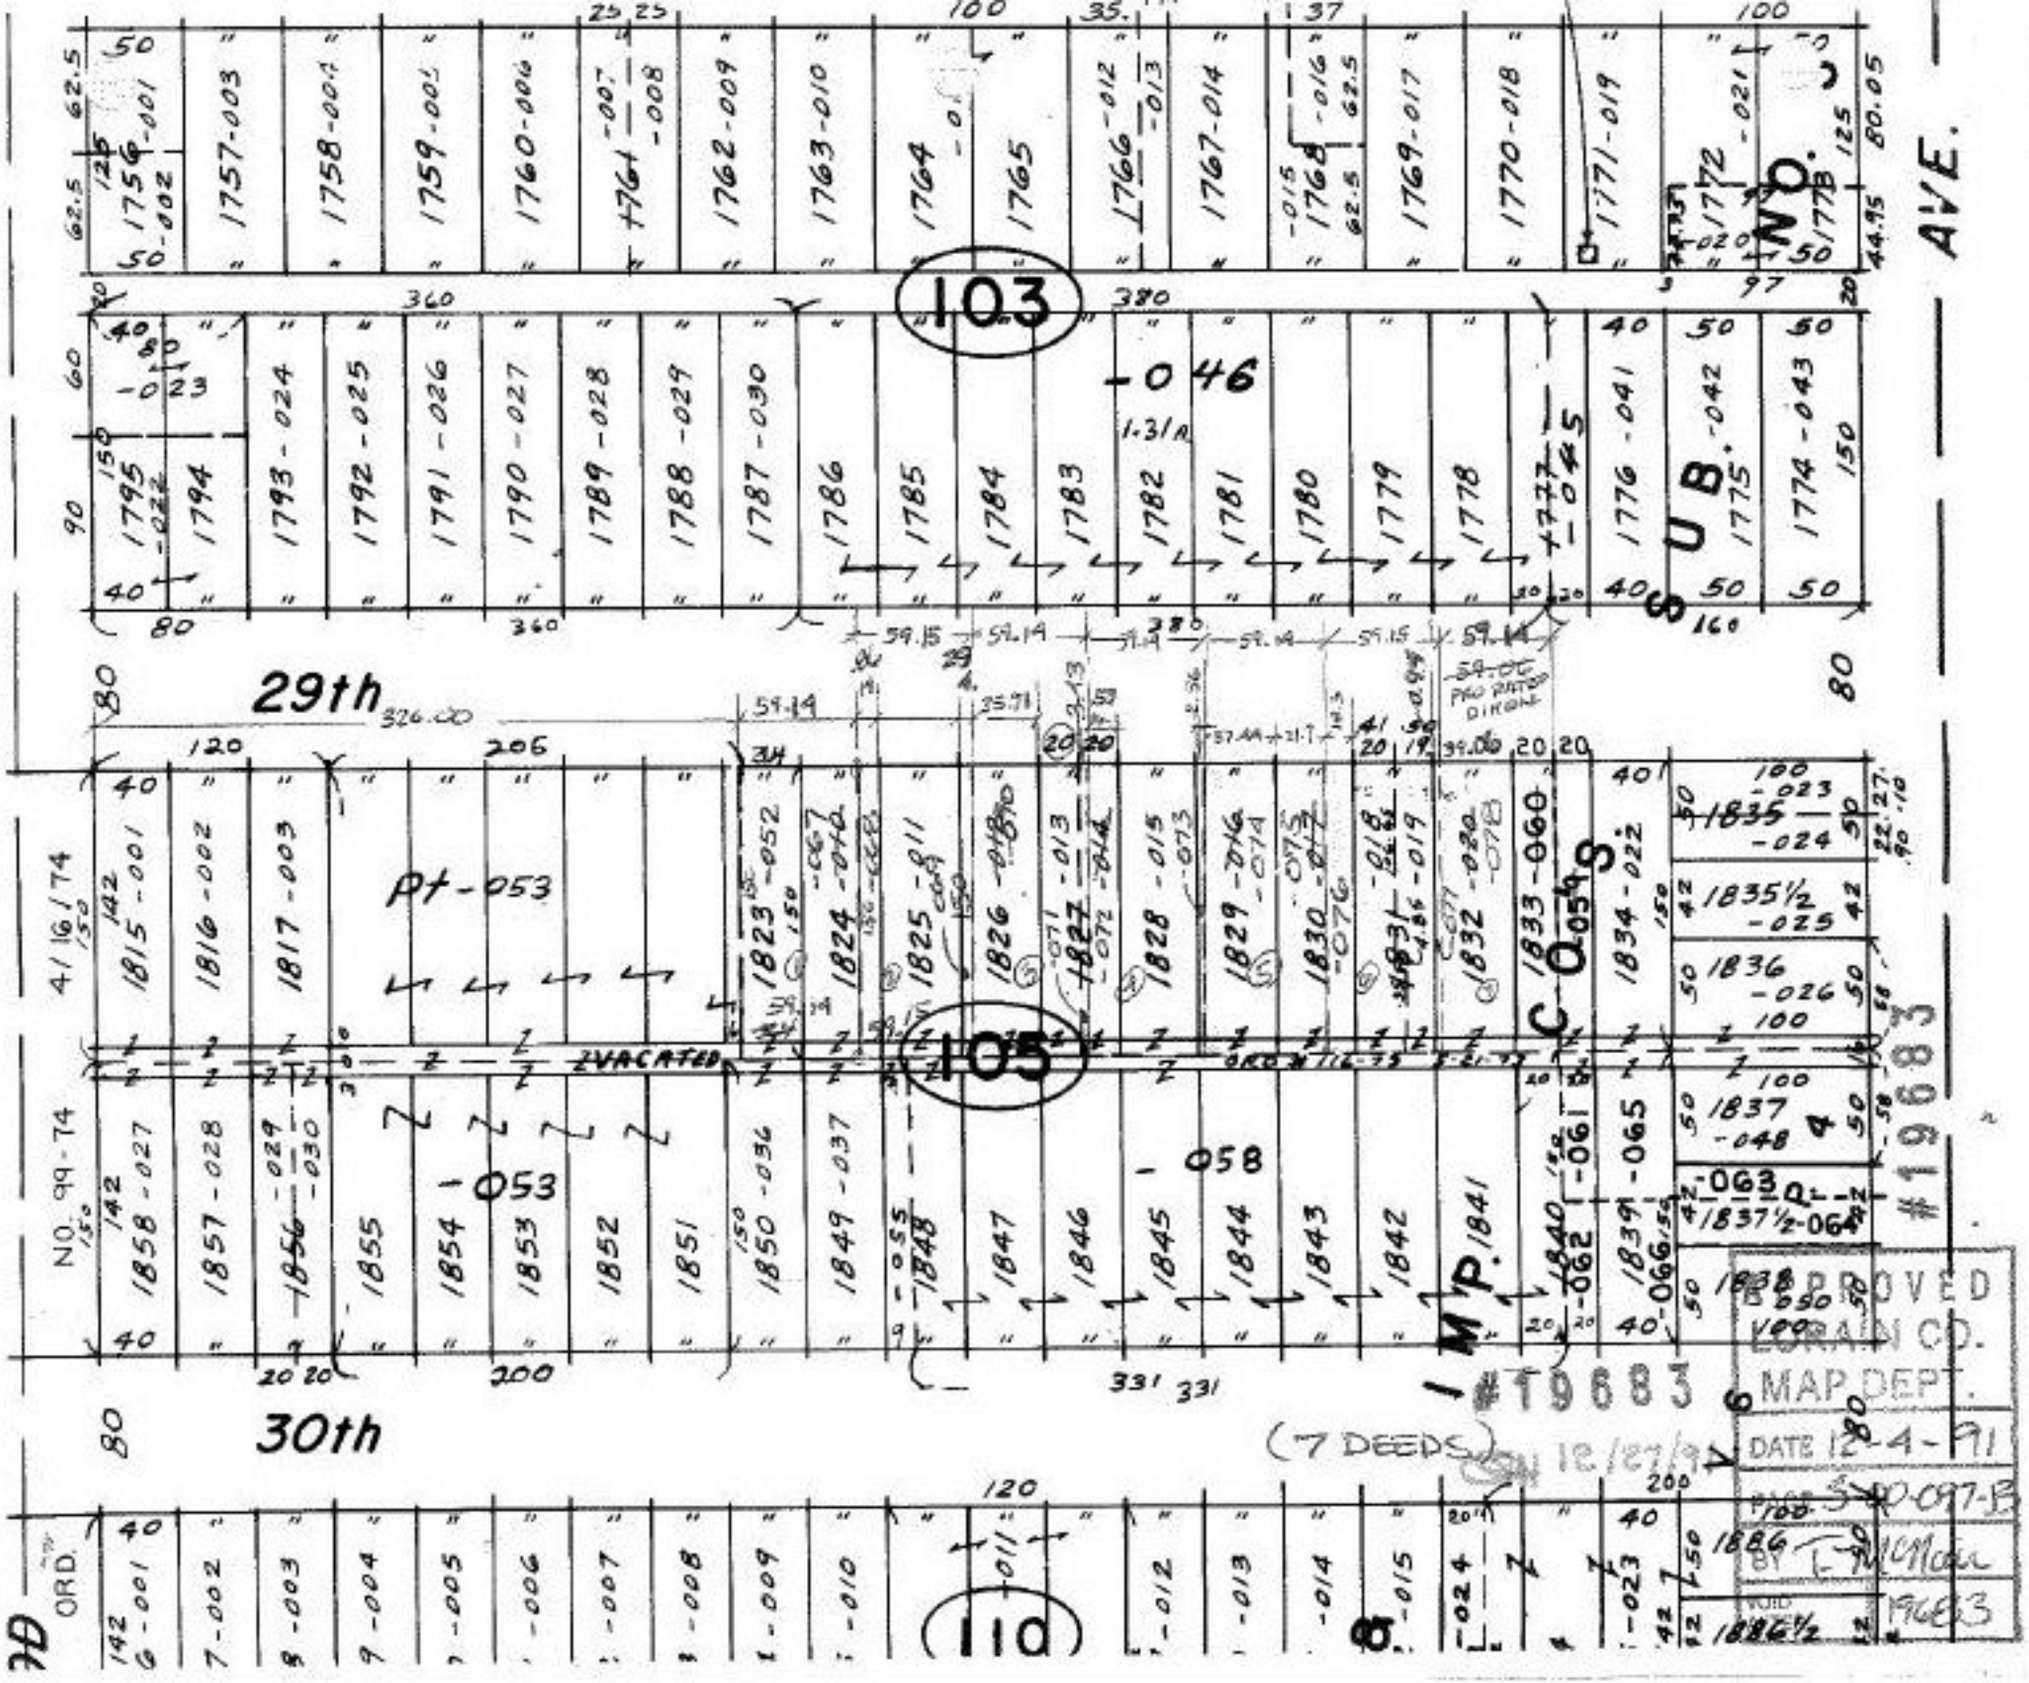

APPROVED
LORAIN CO.
MAP DEPT.
DATE 12-4-91
PAGE 3-40-097-B
BY
VOID
19683