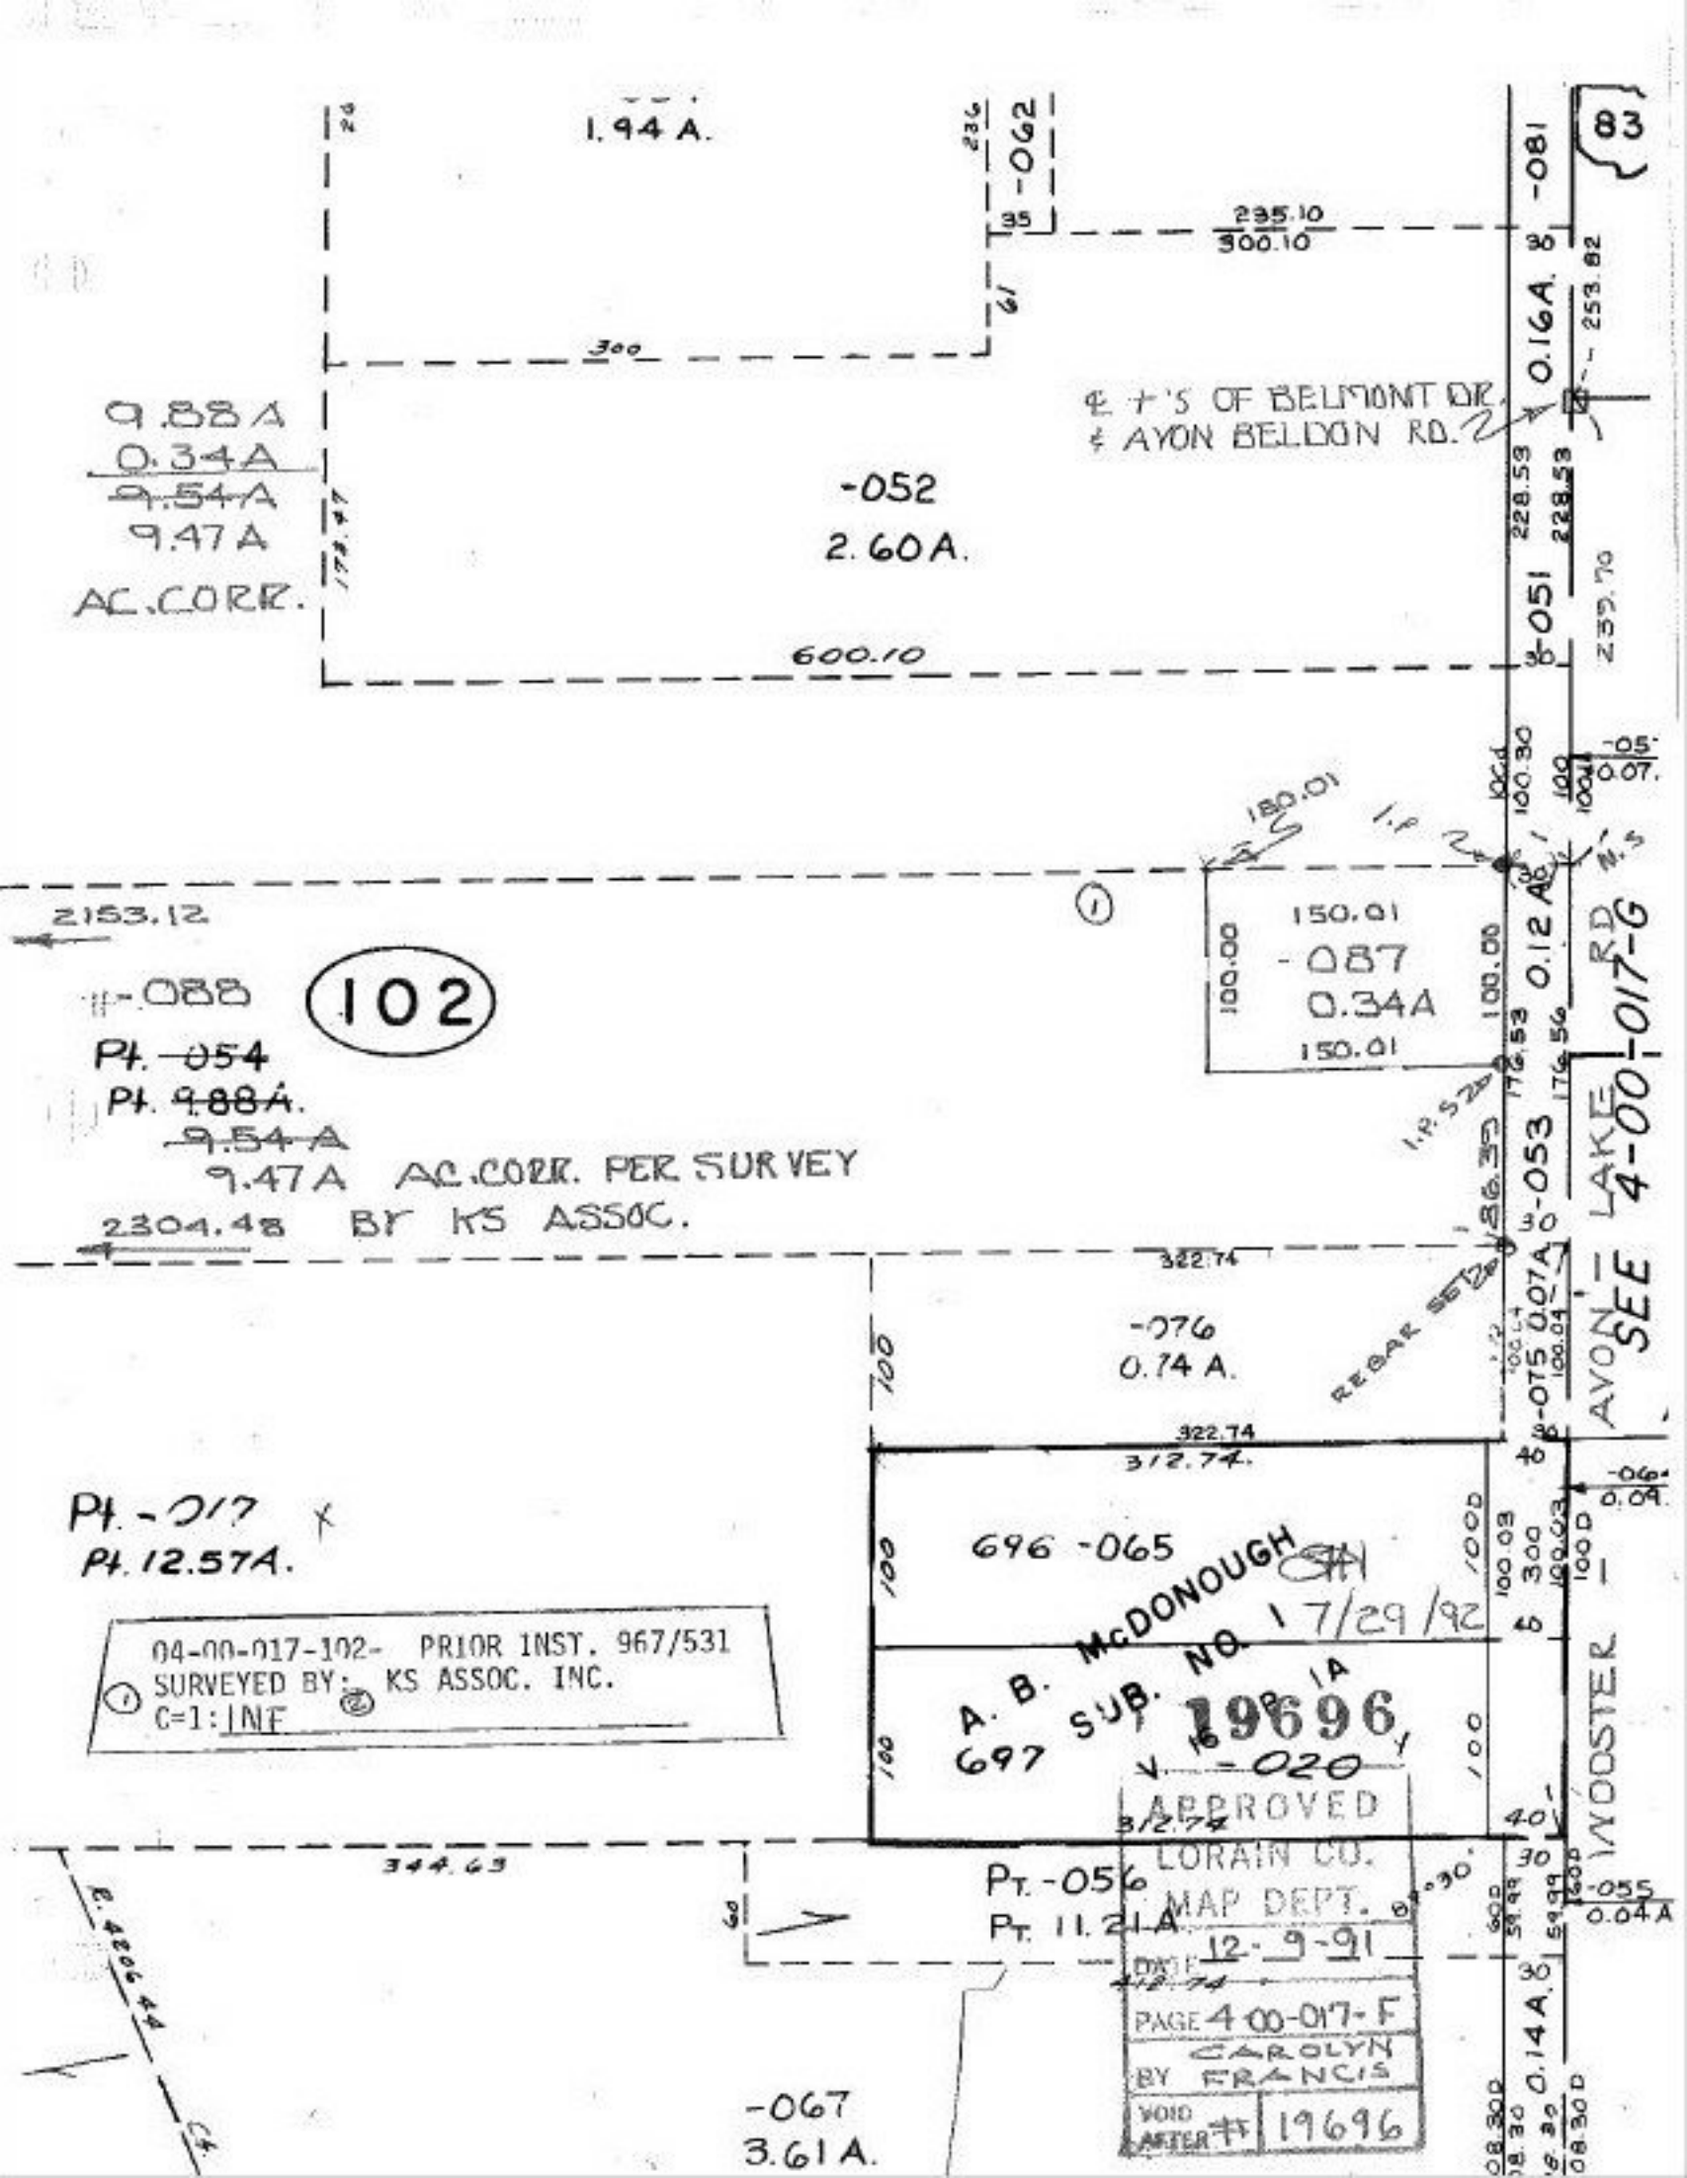
1.94 A.
-062
-081
83
235.10
300.10
0.16A.
253.82
300
9.88A
0.34A
9.54A
9.47A
AC. CORR.
E & T'S OF BELMONT DR.
& AYON BELDON RD.
-052
2.60A.
228.53
228.53
-051
239.70
600.10
180.01
I.P.
150.01
-087
0.34A
150.01
0.12 AC
RD
LAKE
4-00-017-G
2153.12
-088
102
Pt. 054
Pt. 9.88A.
9.54A
9.47A AC. CORR. PER SURVEY
2304.48 BY KS ASSOC.
-053
0.07A
-076
0.74 A.
REBAR SET
322.74
312.74.
-075
0.06A
AVON
SEE
Pt. -017
Pt. 12.57A.
696 -065
A. B. McDONOUGH
697 SUB. NO. 1
7/29/92
19696
-020
APPROVED
LORAIN CO.
MAP DEPT.
12-9-91
PAGE 4-00-017-F
BY CAROLYN FRANCIS
VOID AFTER 19696
WOOSTER
04-00-017-102- PRIOR INST. 967/531
SURVEYED BY: KS ASSOC. INC.
C=1: INF
344.63
Pt. -056
Pt. 11.21A
-055
0.04A
0.14A
-067
3.61A.