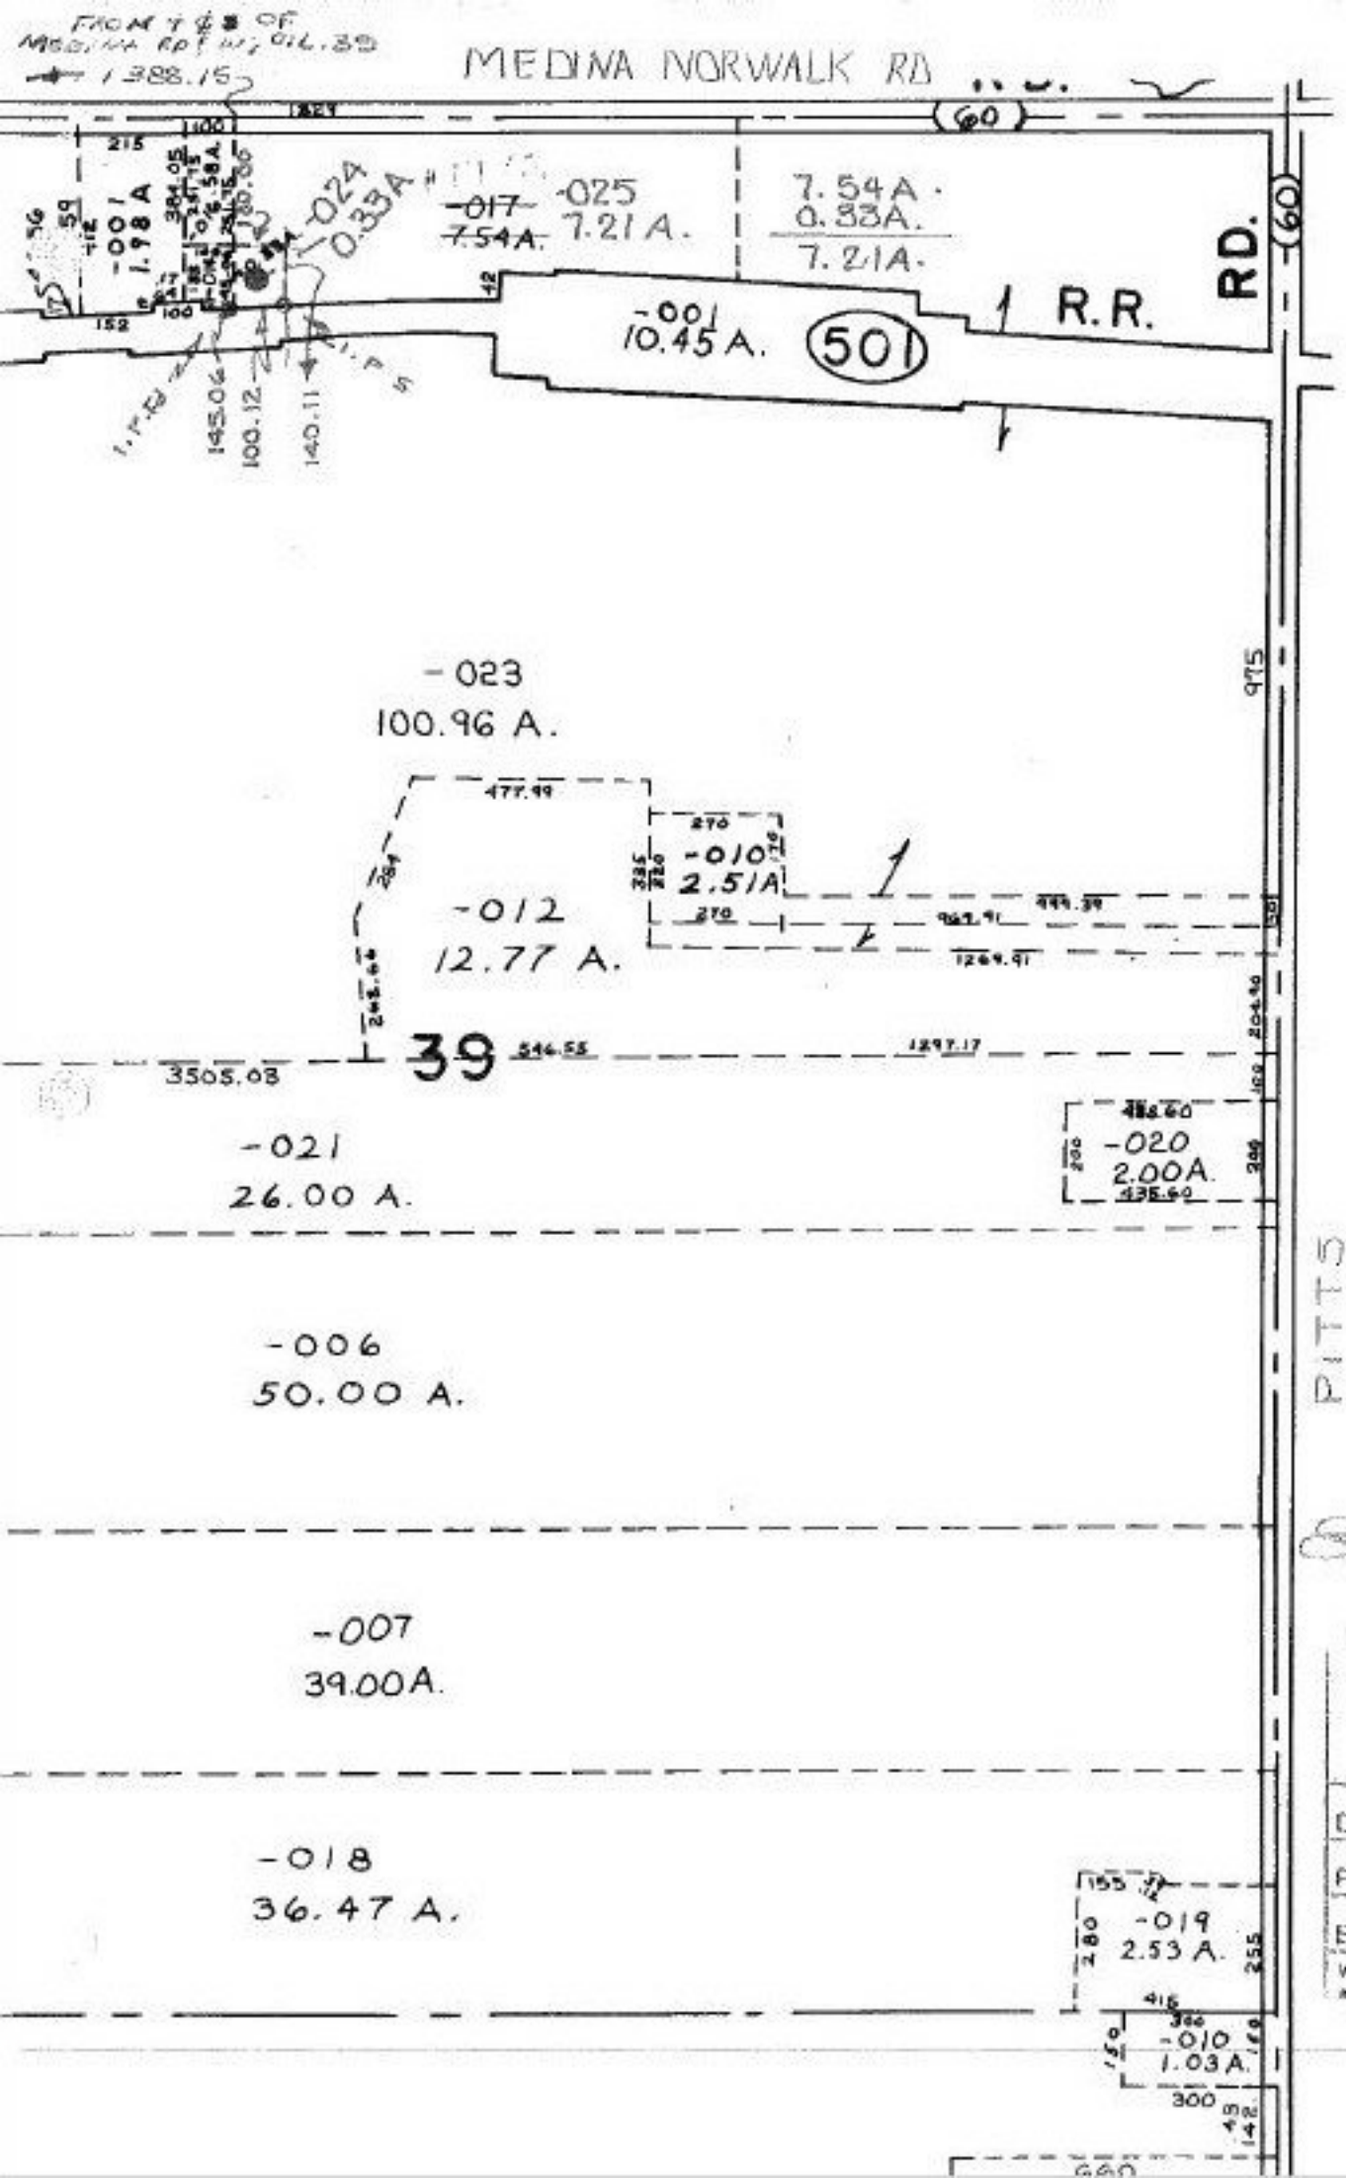
FROM T # 8 OF MEDINA APP'D 01.89
1388.15
MEDINA NORWALK RD
60
-001
1.98 A
-024
0.33A
-017
7.54A.
-025
7.21A.
7.54A.
0.33A.
7.21A.
-001
10.45A.
501
1 R.R.
RD.
60
145.04
100.12
140.11
-023
100.96 A.
975
-010
2.51A
-012
12.77 A.
39
544.55
1297.17
3505.08
-021
26.00 A.
-020
2.00A.
-006
50.00 A.
-007
39.00A.
-018
36.47 A.
-019
2.53 A.
-010
1.03A.
300
PITTS
18-00-039-000- PRIOR INST. 458/346 C=1:107,957
SURVEYED BY: JOHN POZYWAK REG. SURVEYOR
5/7/92
19702
APPROVED
LORAIN CO.
MAP DEPT.
DATE 12-12-91
PAGE 18-E
BY CAROLYN FRANCIS
VOID AFTER # 19702