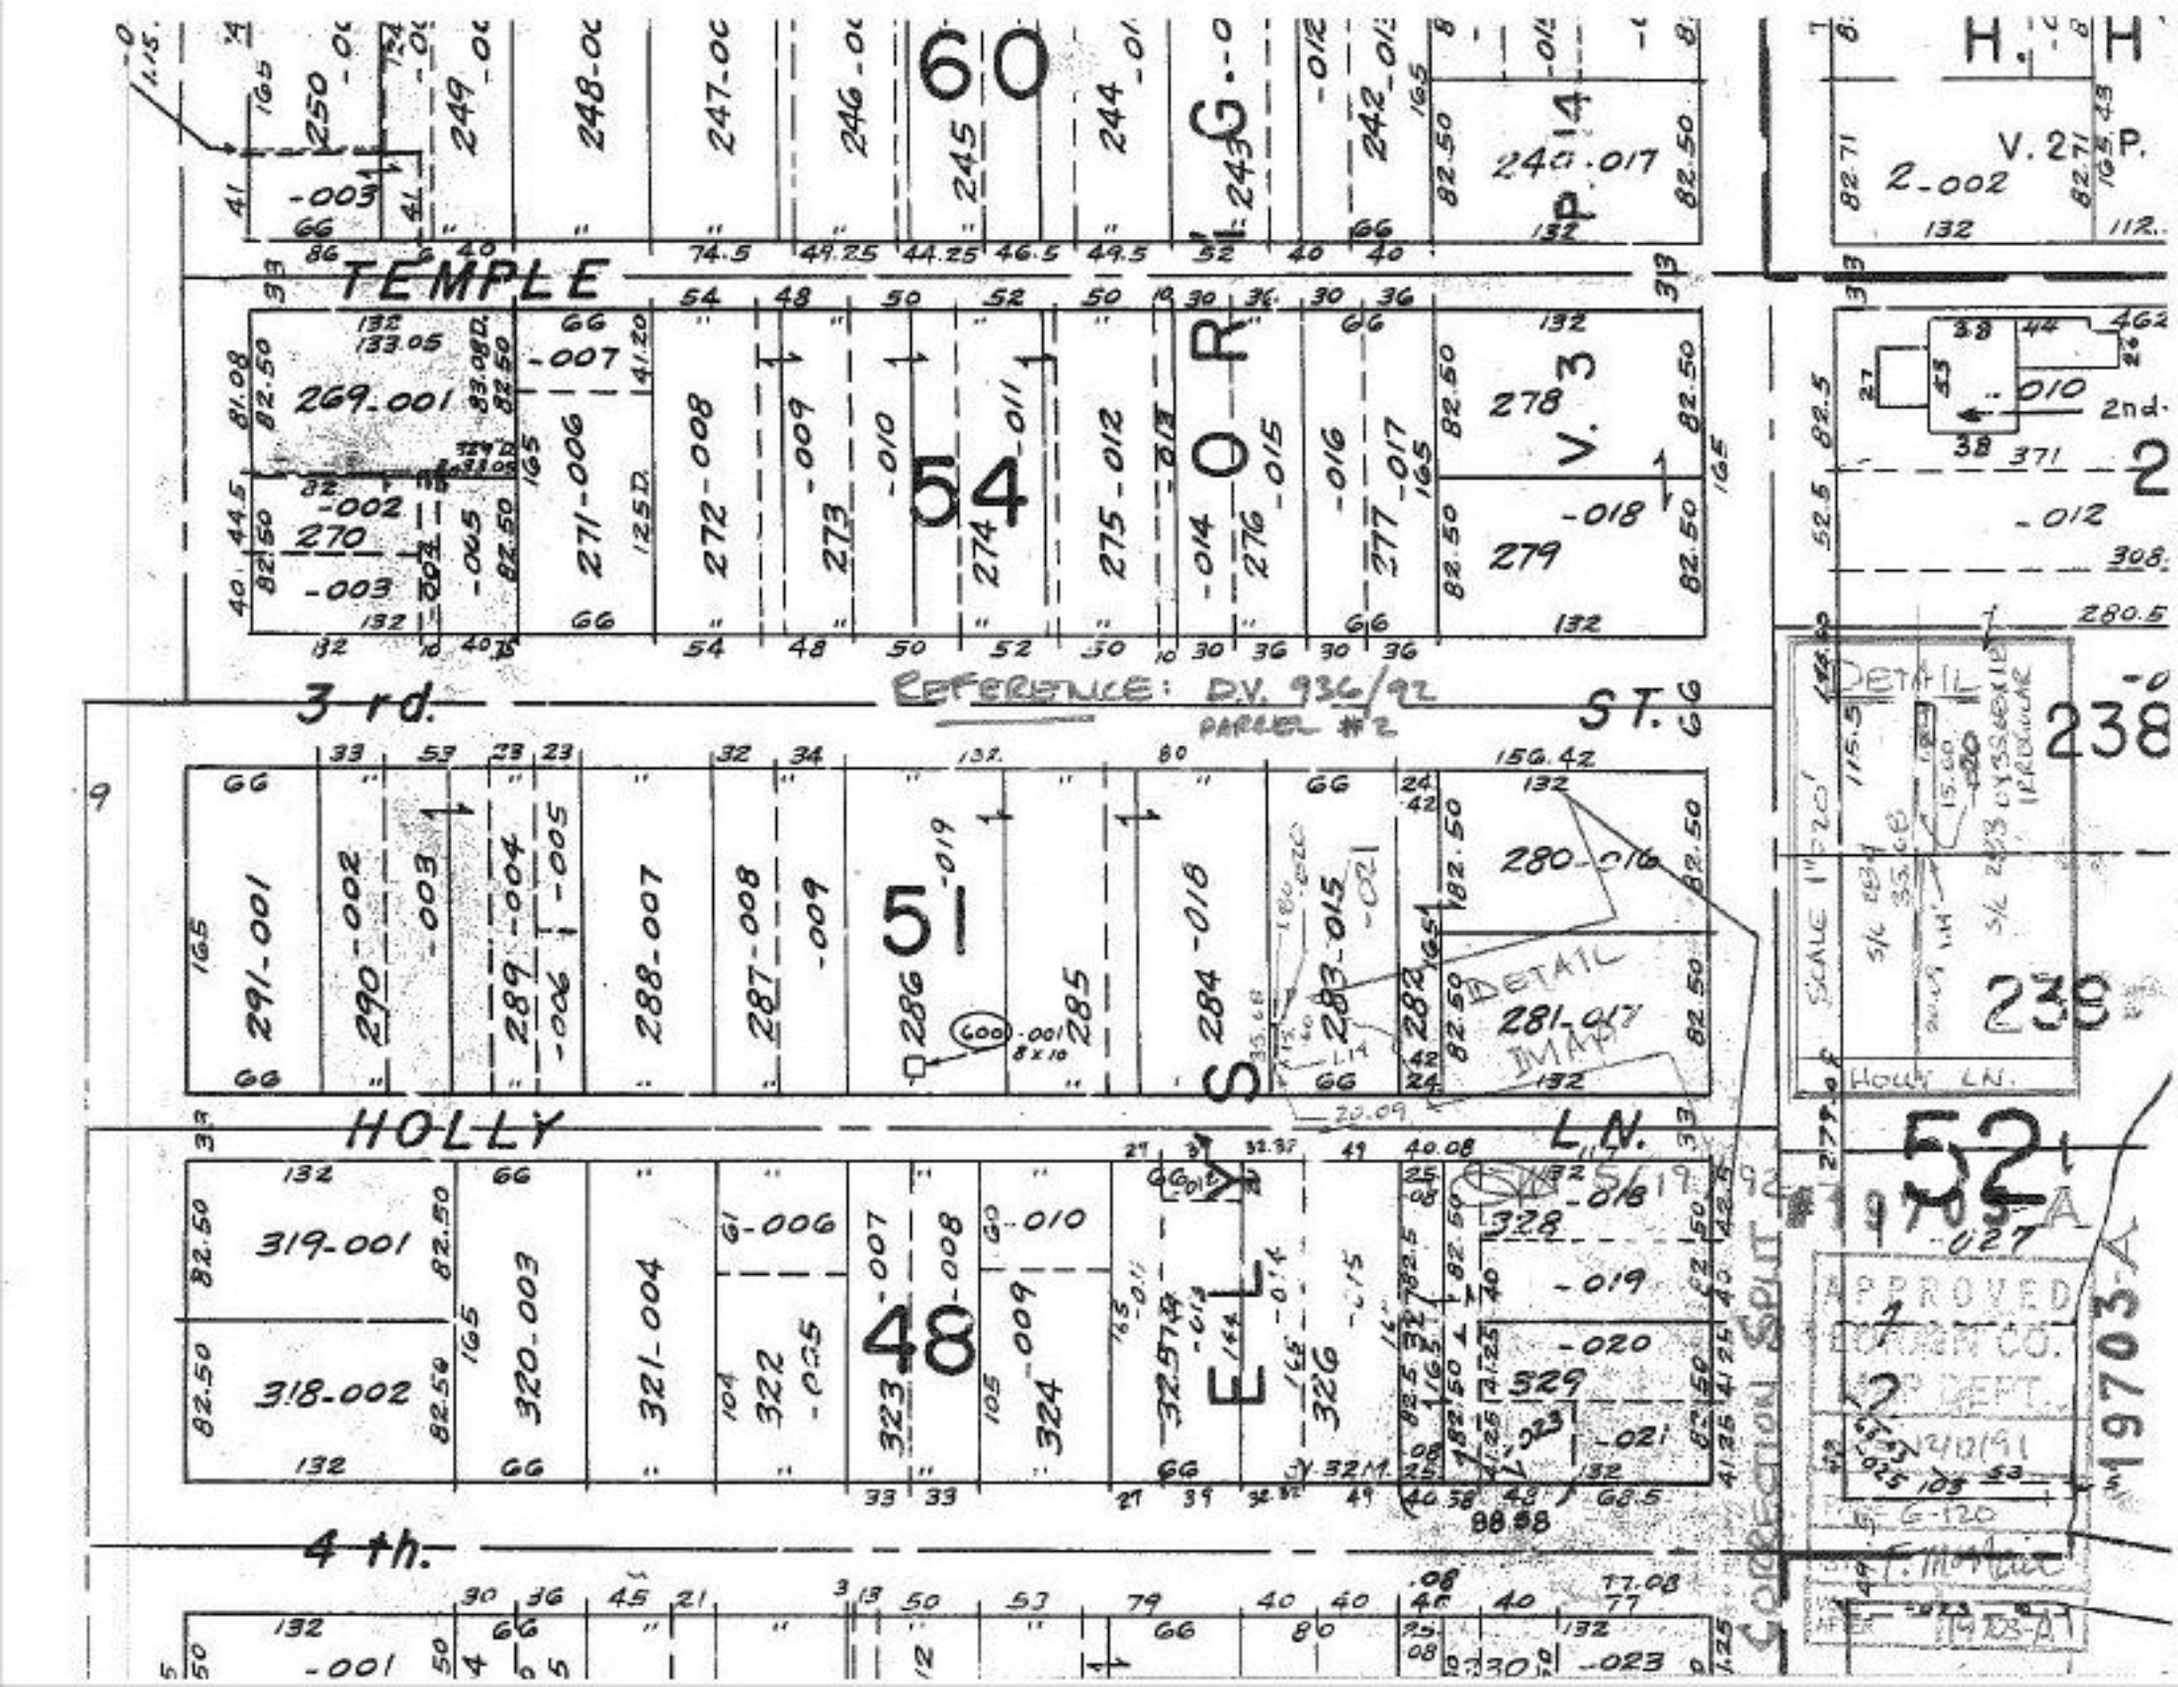
TEMPLE
3 rd.
ST.
HOLLY
LN.
4 th.
REFERENCE: D.V. 936/92
PARCEL #2
DETAIL
DETAIL
IMAP
SCALE 1"=20'
HOLLY LN.
CORRECTION SPLIT
APPROVED
19703-A
19703-A