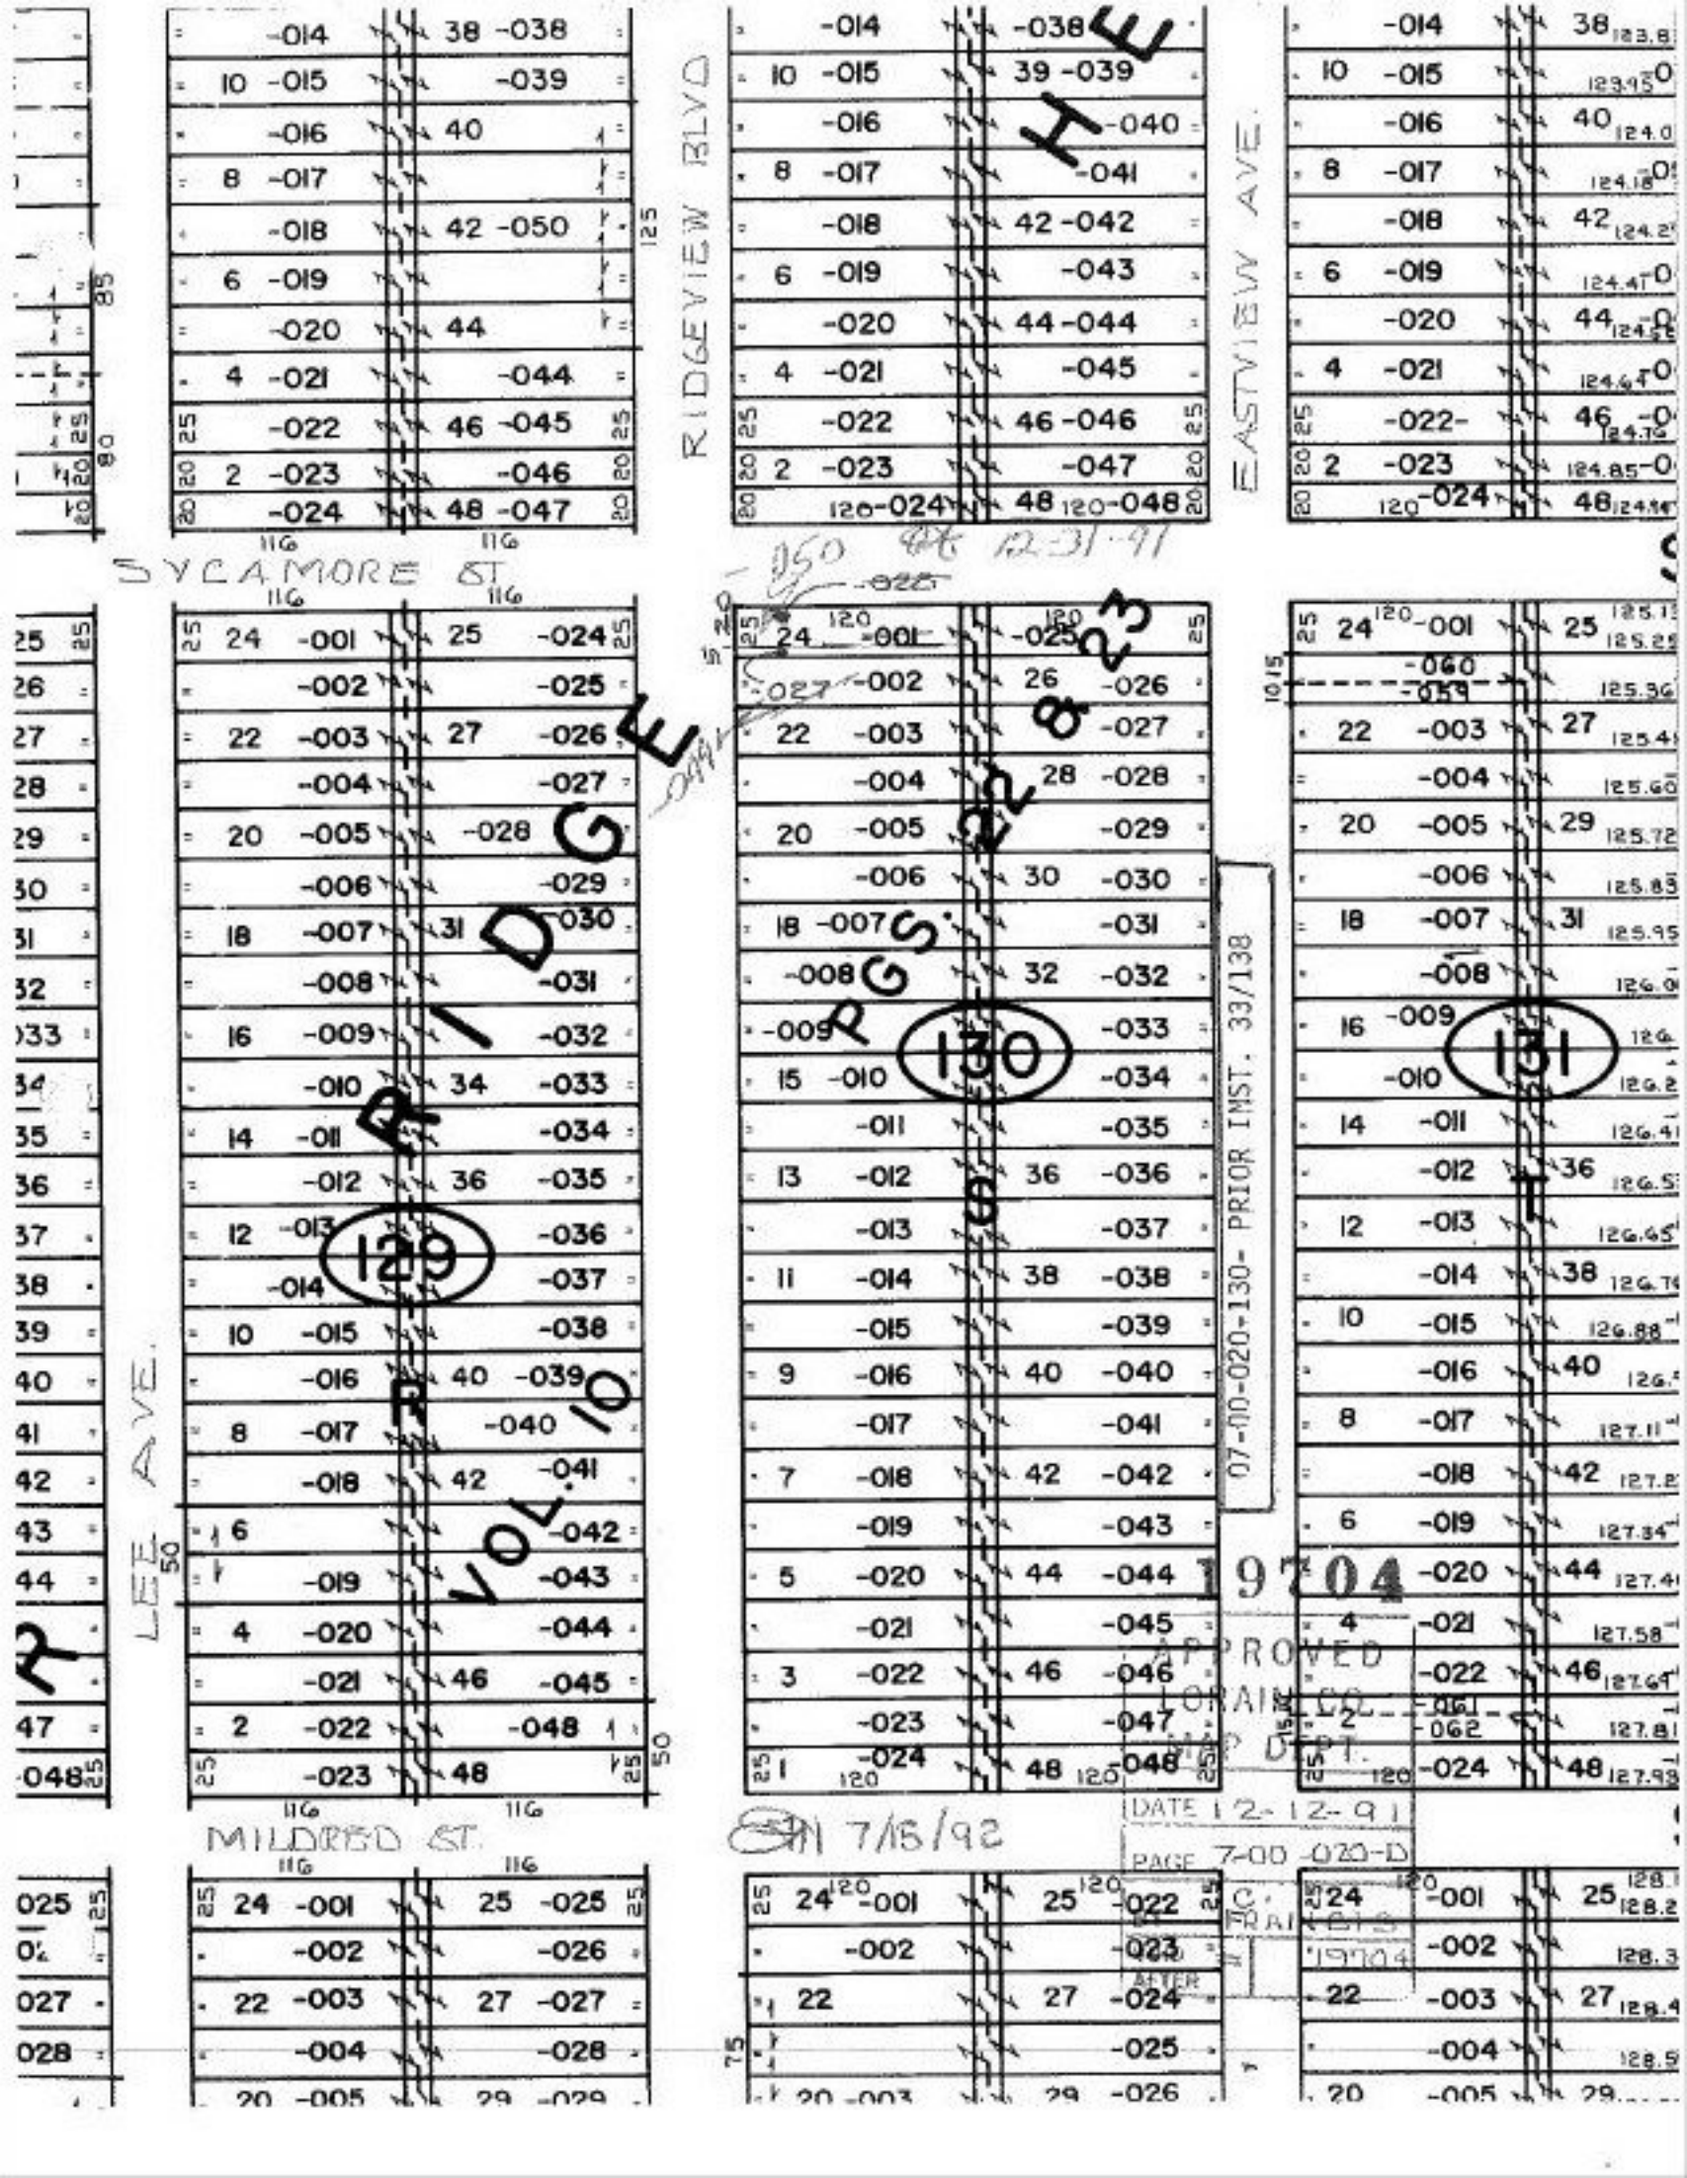

SYCAMORE ST.
RIDGEVIEW BLVD
EASTVIEW AVE.
LEE AVE.
MILDRED ST.
RIDGE
VOL. 10
PGS. 22 & 23
130
131
129
07-00-020-130- PRIOR INST. 33/138
19704
APPROVED
LORAIN CO.
MAP DEPT.
DATE 12-12-91
PAGE 7-00-020-D
7/15/92