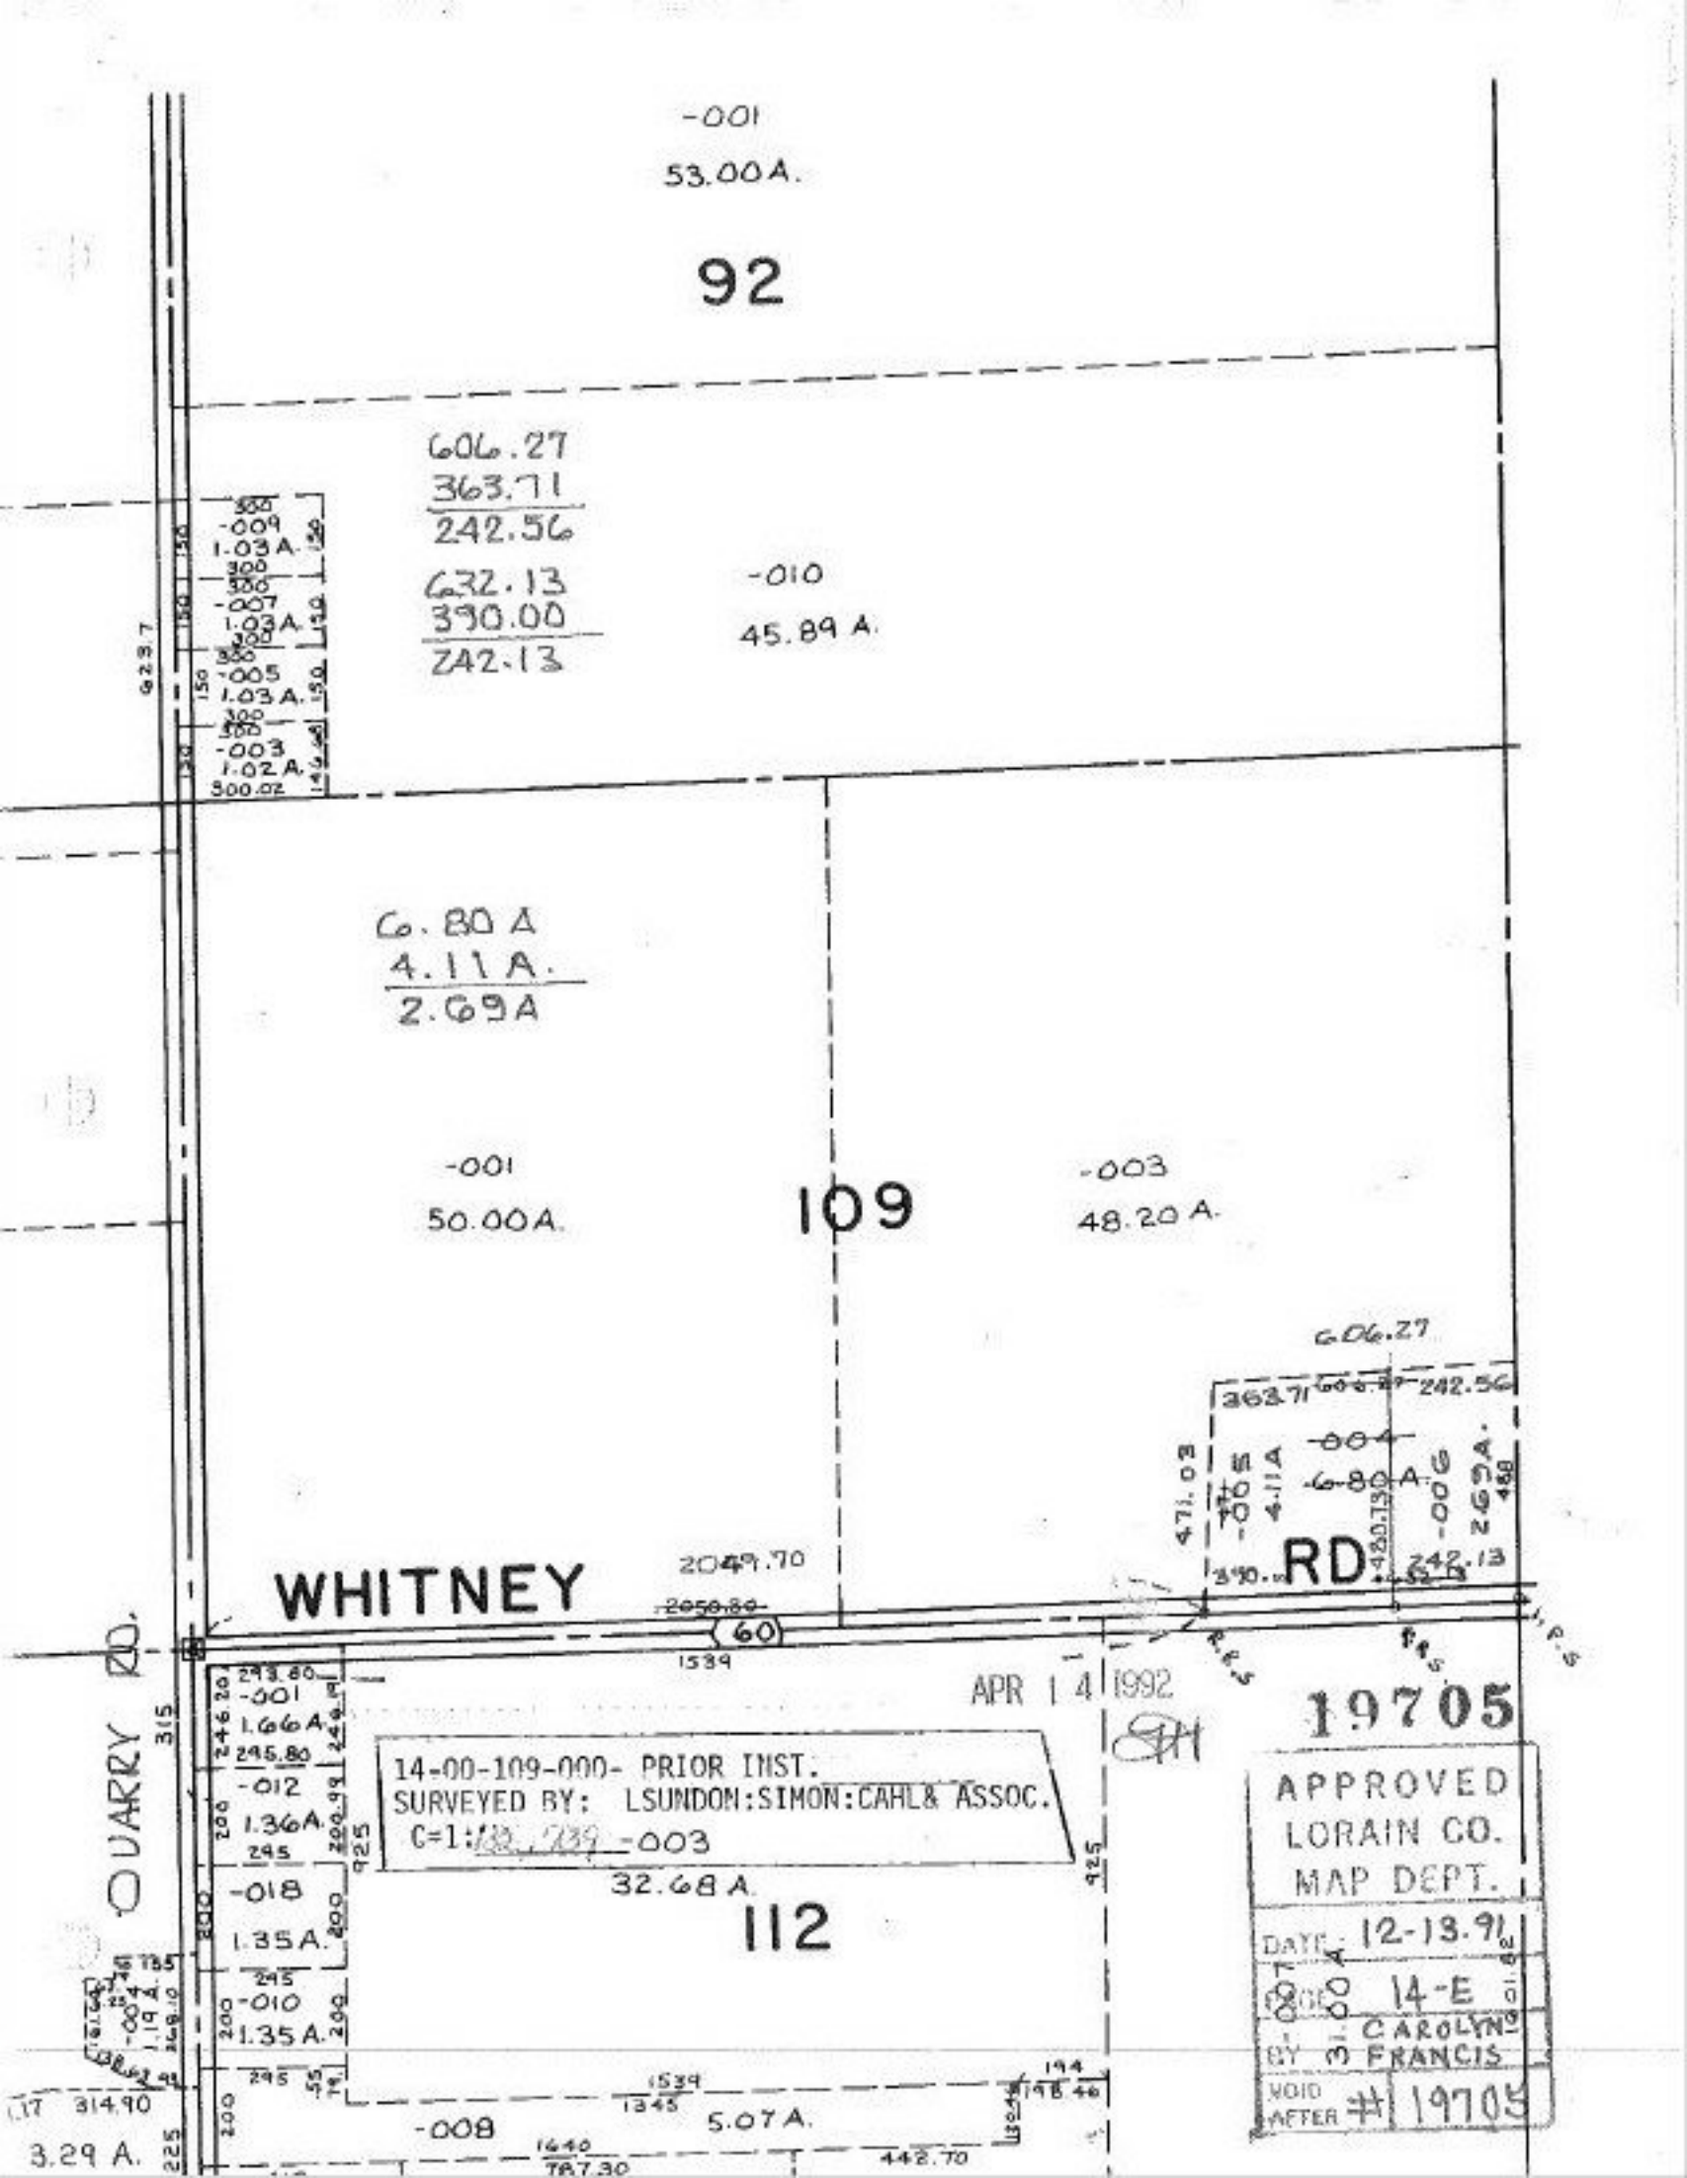
-001
53.00A.
92
606.27
363.71
242.56
632.13
390.00
242.13
-010
45.89 A.
-009
1.03A.
-007
1.03A.
-005
1.03A.
-003
1.02A.
6.80 A
4.11 A.
2.69A
-001
50.00A.
109
-003
48.20 A.
606.27
363.71
242.56
-004
6.80A.
-005
4.11A
-006
2.69A.
471.03
RD
242.13
WHITNEY
2049.70
60
1539
QUARRY RD.
-001
1.66A.
-012
1.36A.
-018
1.35A.
-010
1.35A.
-003
32.68 A.
112
-008
5.07A.
3.29 A.
APR 14 1992
19705
14-00-109-000- PRIOR INST.
SURVEYED BY: LSUNDON:SIMON:CAHL& ASSOC.
C=1:
APPROVED
LORAIN CO.
MAP DEPT.
DATE 12-13.91
PAGE 14-E
BY CAROLYN FRANCIS
VOID AFTER # 19705