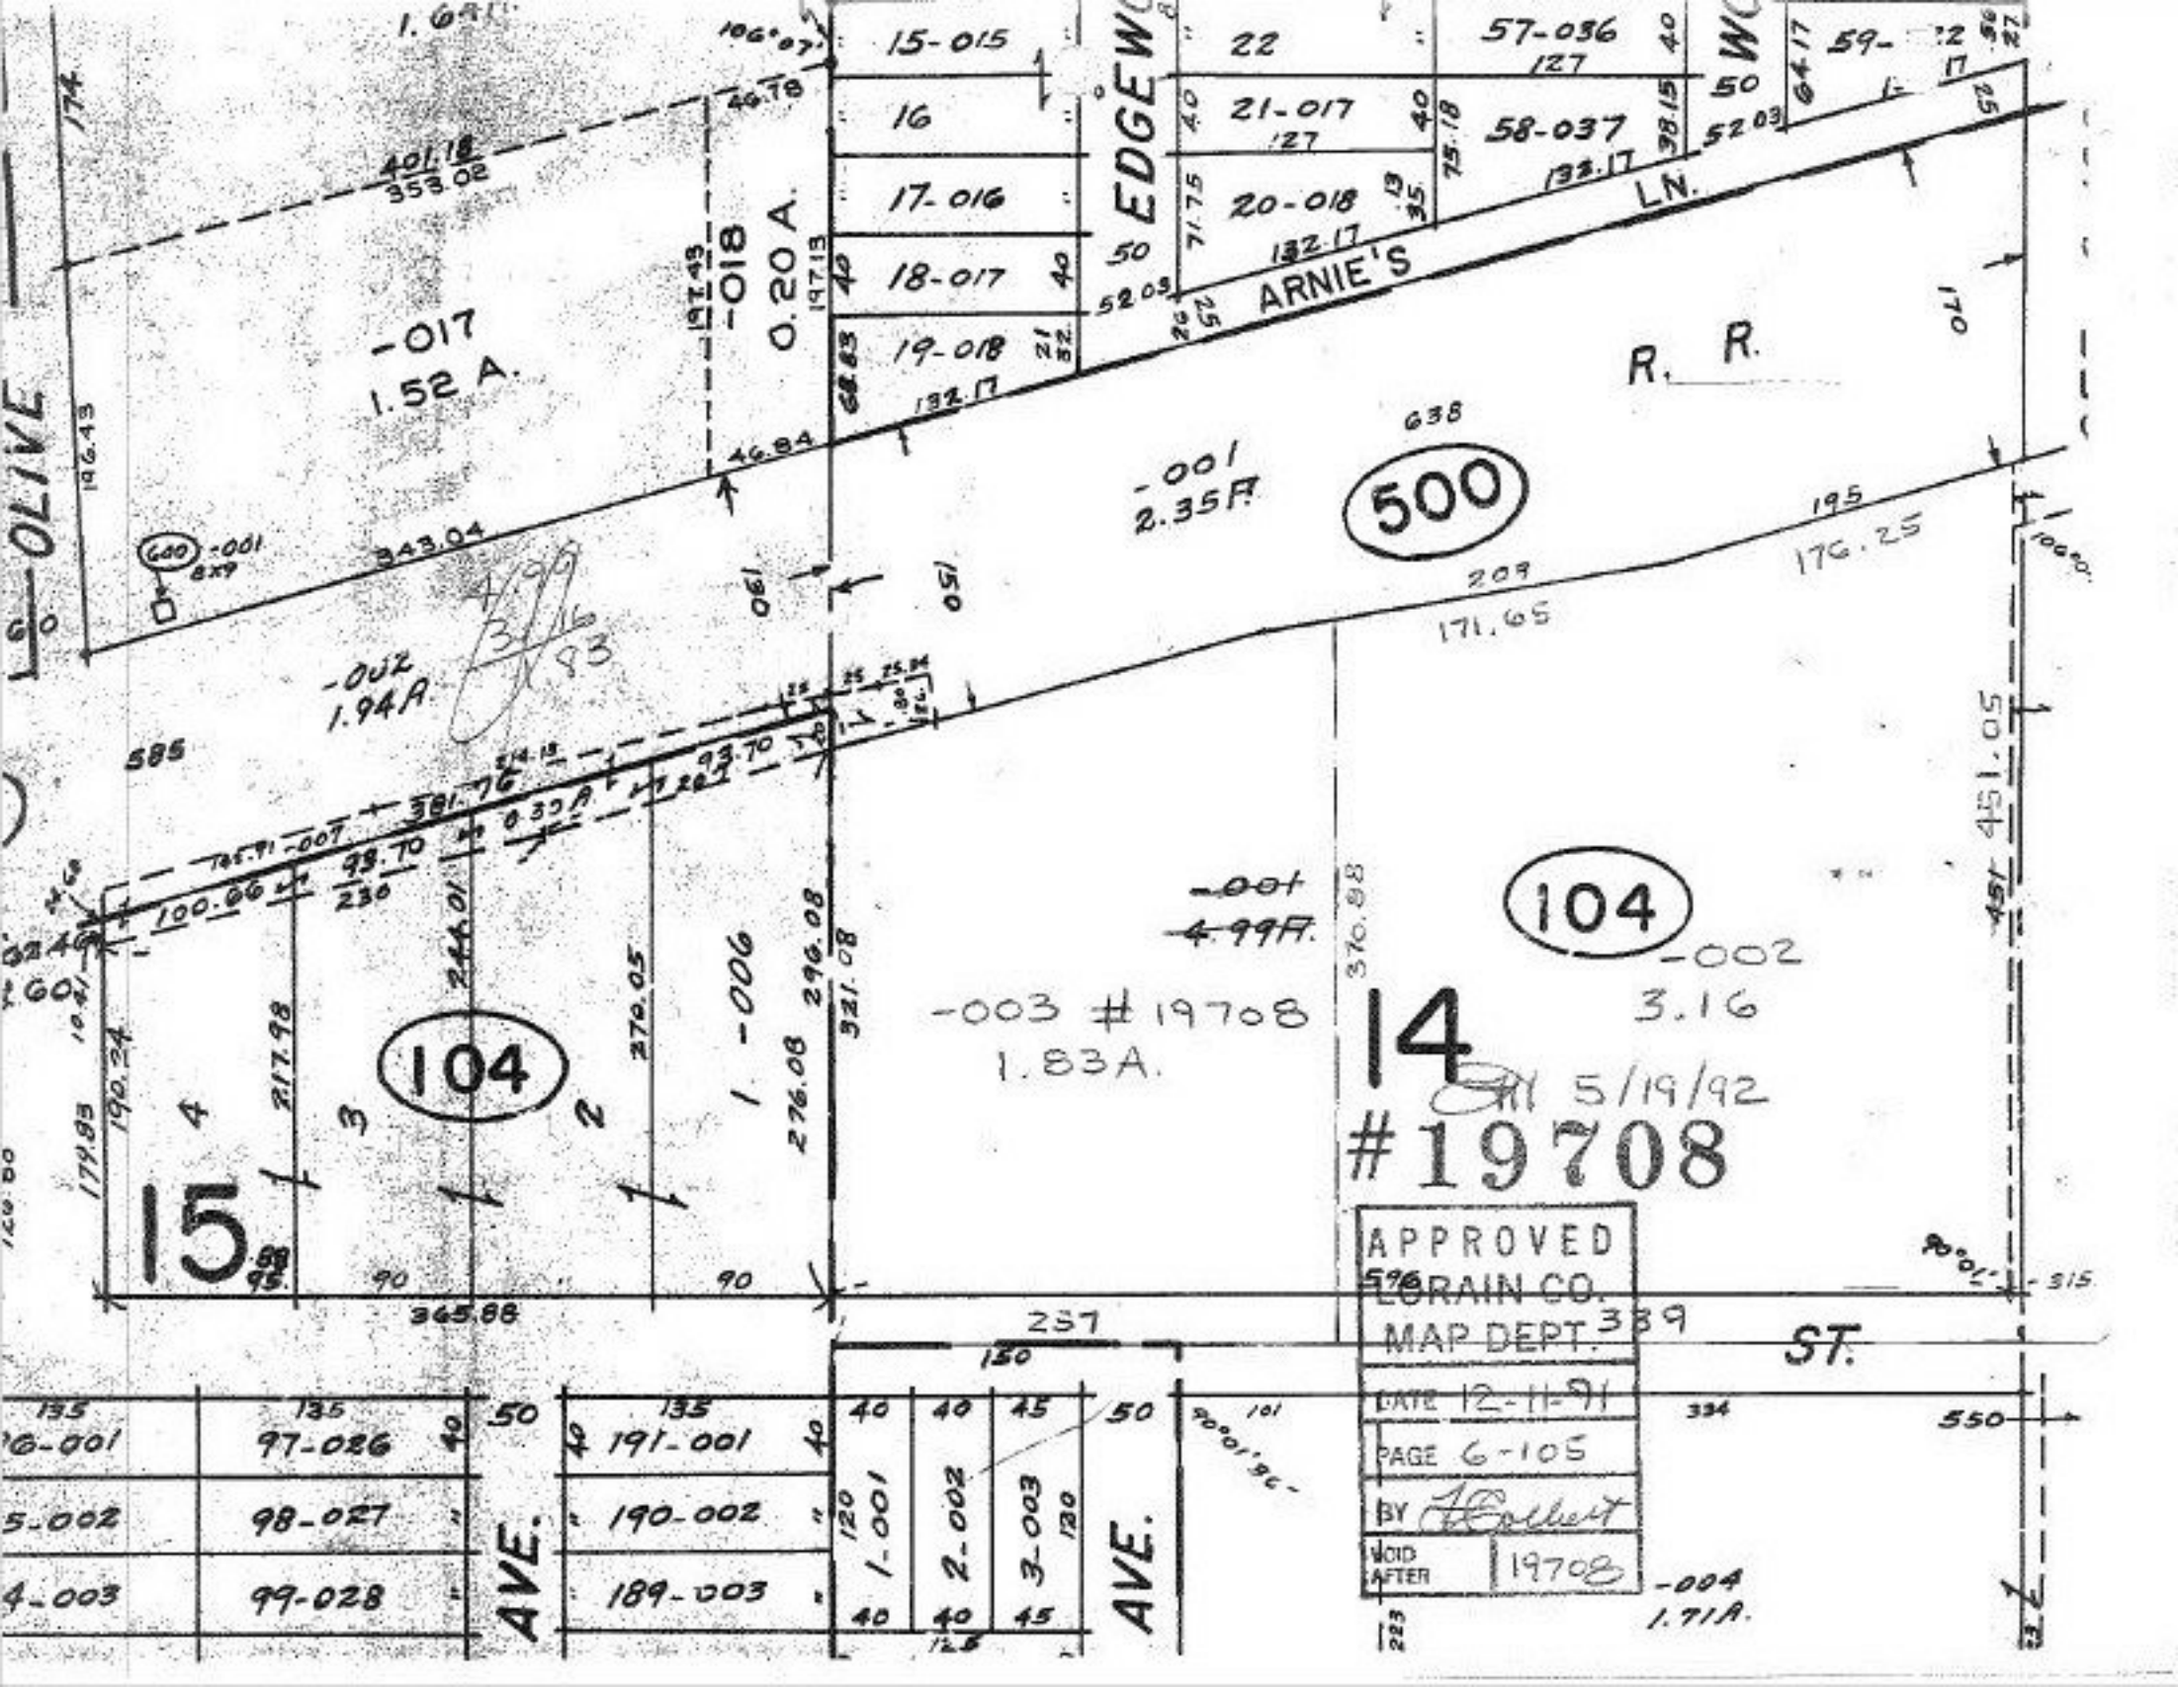
OLIVE
EDGEWOOD
ARNIE'S LN.
R. R.
ST.
AVE.
AVE.
-017
1.52 A.
-018
0.20 A.
-001
2.35 A.
-002
1.94 A.
-003 #19708
1.83A.
-004
1.71A.
-006
1.
-001
4.99A.
-002
3.16
500
104
104
15
14
#19708
5/19/92
APPROVED
LORAIN CO.
MAP DEPT.
DATE 12-11-91
PAGE 6-105
BY
VOID AFTER 19708
15-015
16
17-016
18-017
19-018
22
21-017
20-018
57-036
58-037
59-
97-026
98-027
99-028
191-001
190-002
189-003
1-001
2-002
3-003
345.88
257
451.05
176.25
171.65
401.18
353.02
343.04
196.43
197.13
132.17
638
585
370.88
321.08
276.08
270.05
244.01
217.98
190.24
100.06
98.70
90
50
40
45
120
130
334
550
315
223
339