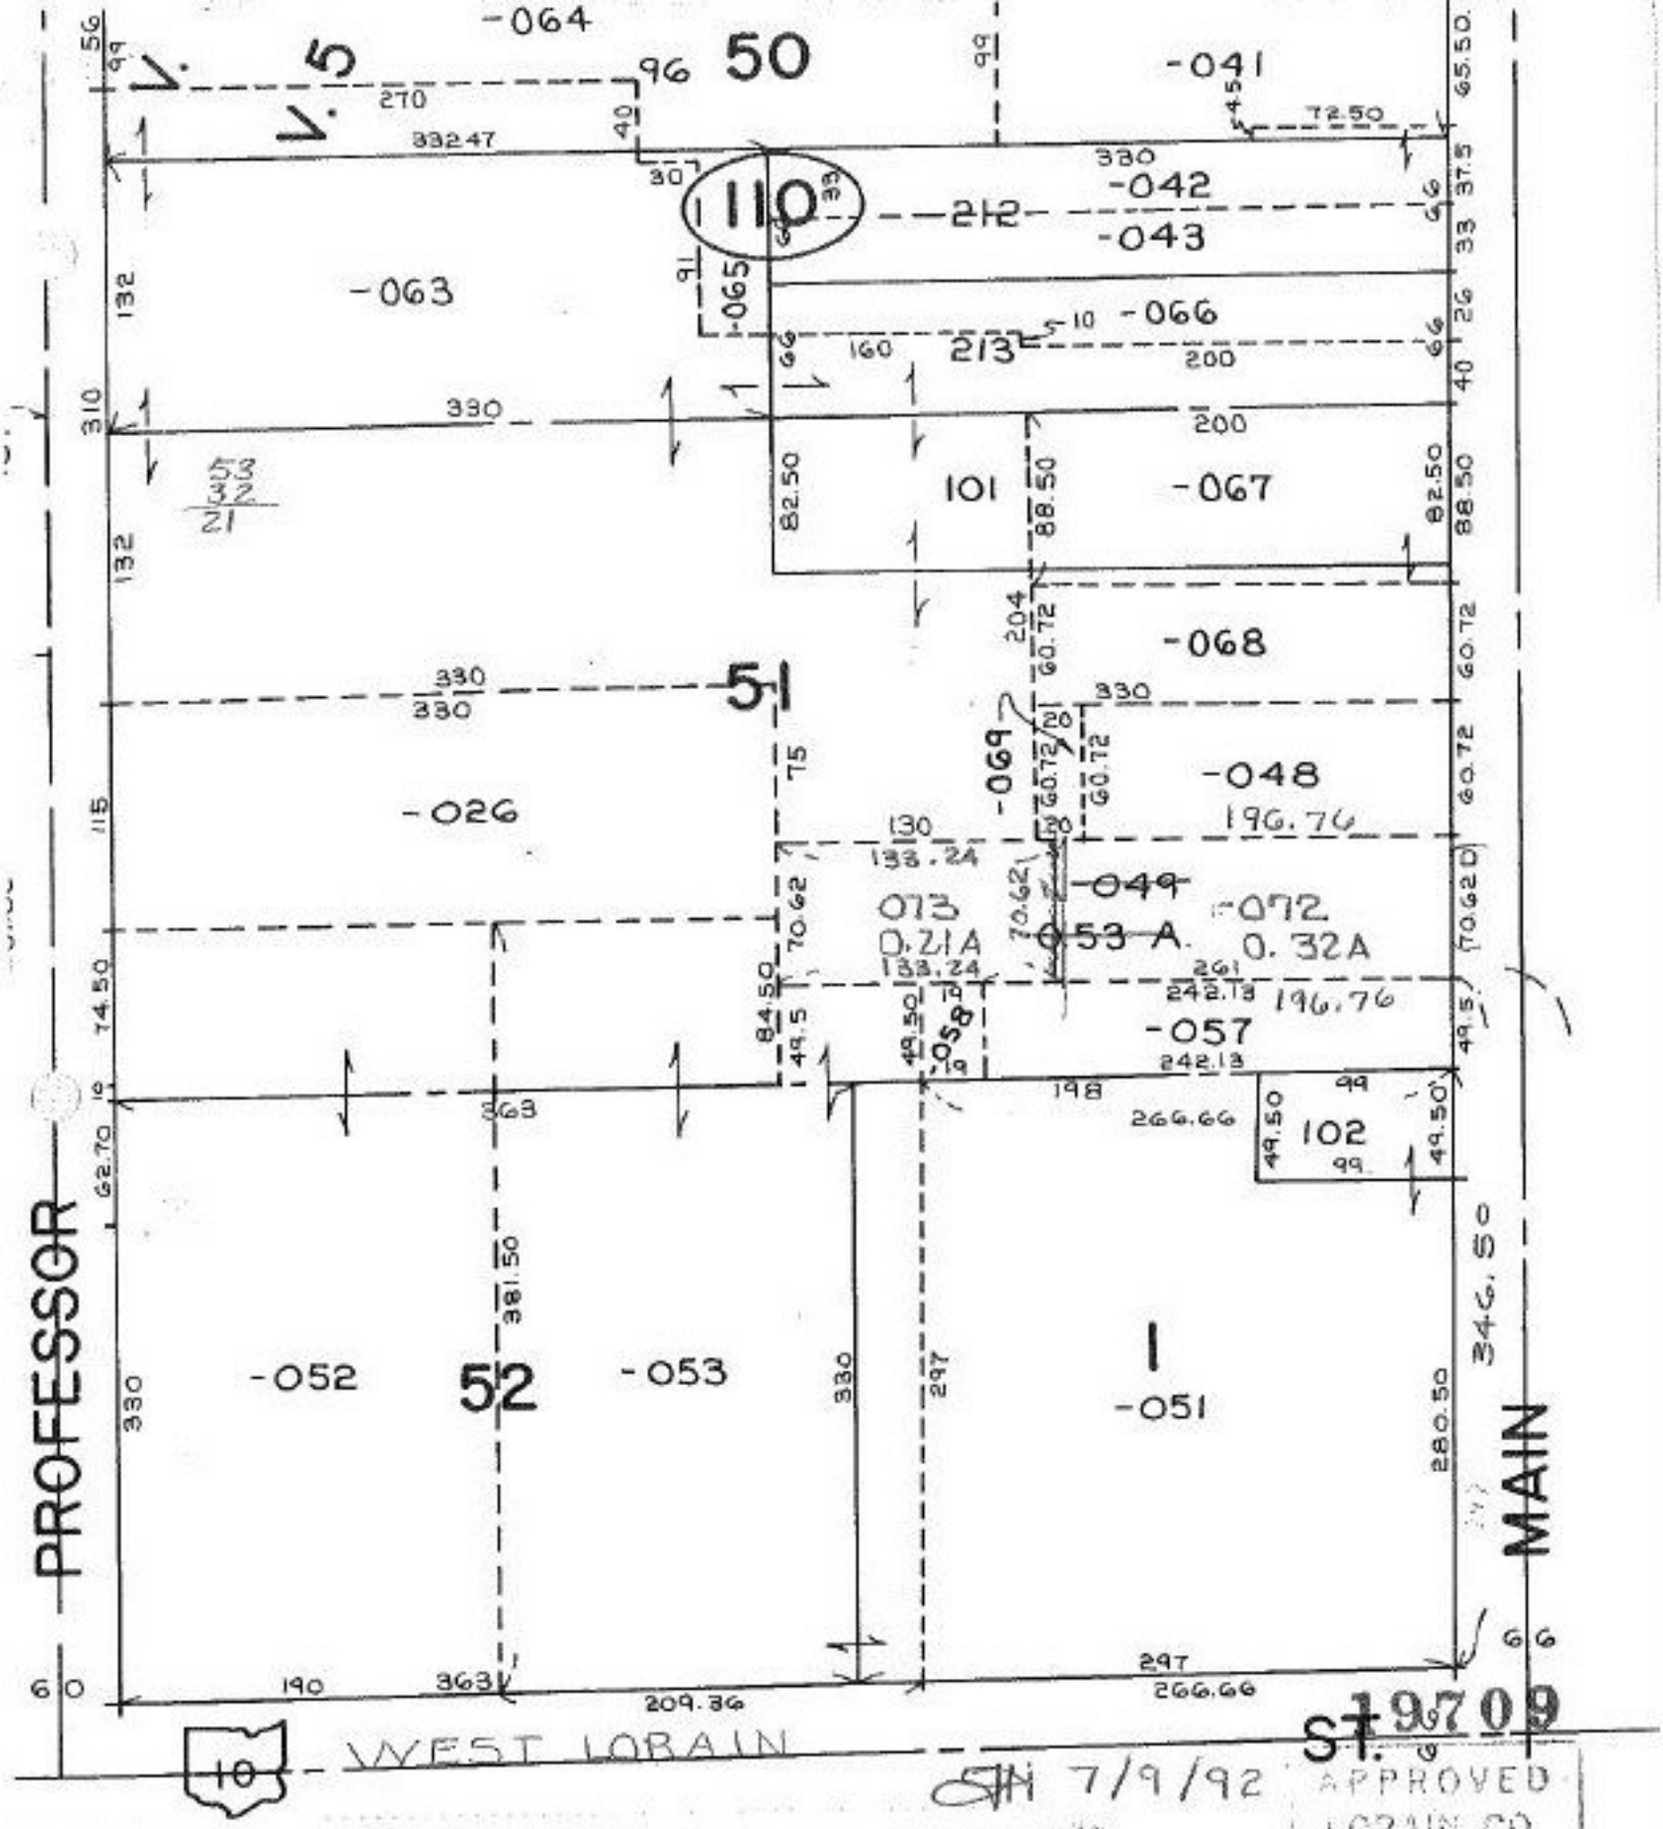

ST. 19709

SM 7/9/92

APPROVED
LORAIN CO.
MAP DEPT.
DATE 12-16-91
PAGE 9-00-075-B
BY CAROLYN FRANCIS
VOID AFTER # 19709

)0-085-B

09-00-075-110- PRIOR INST: 381/23 890/408
SURVEYED BY: LAUNDON, SIMON, CAHL & ASSOC.
C=1:INF