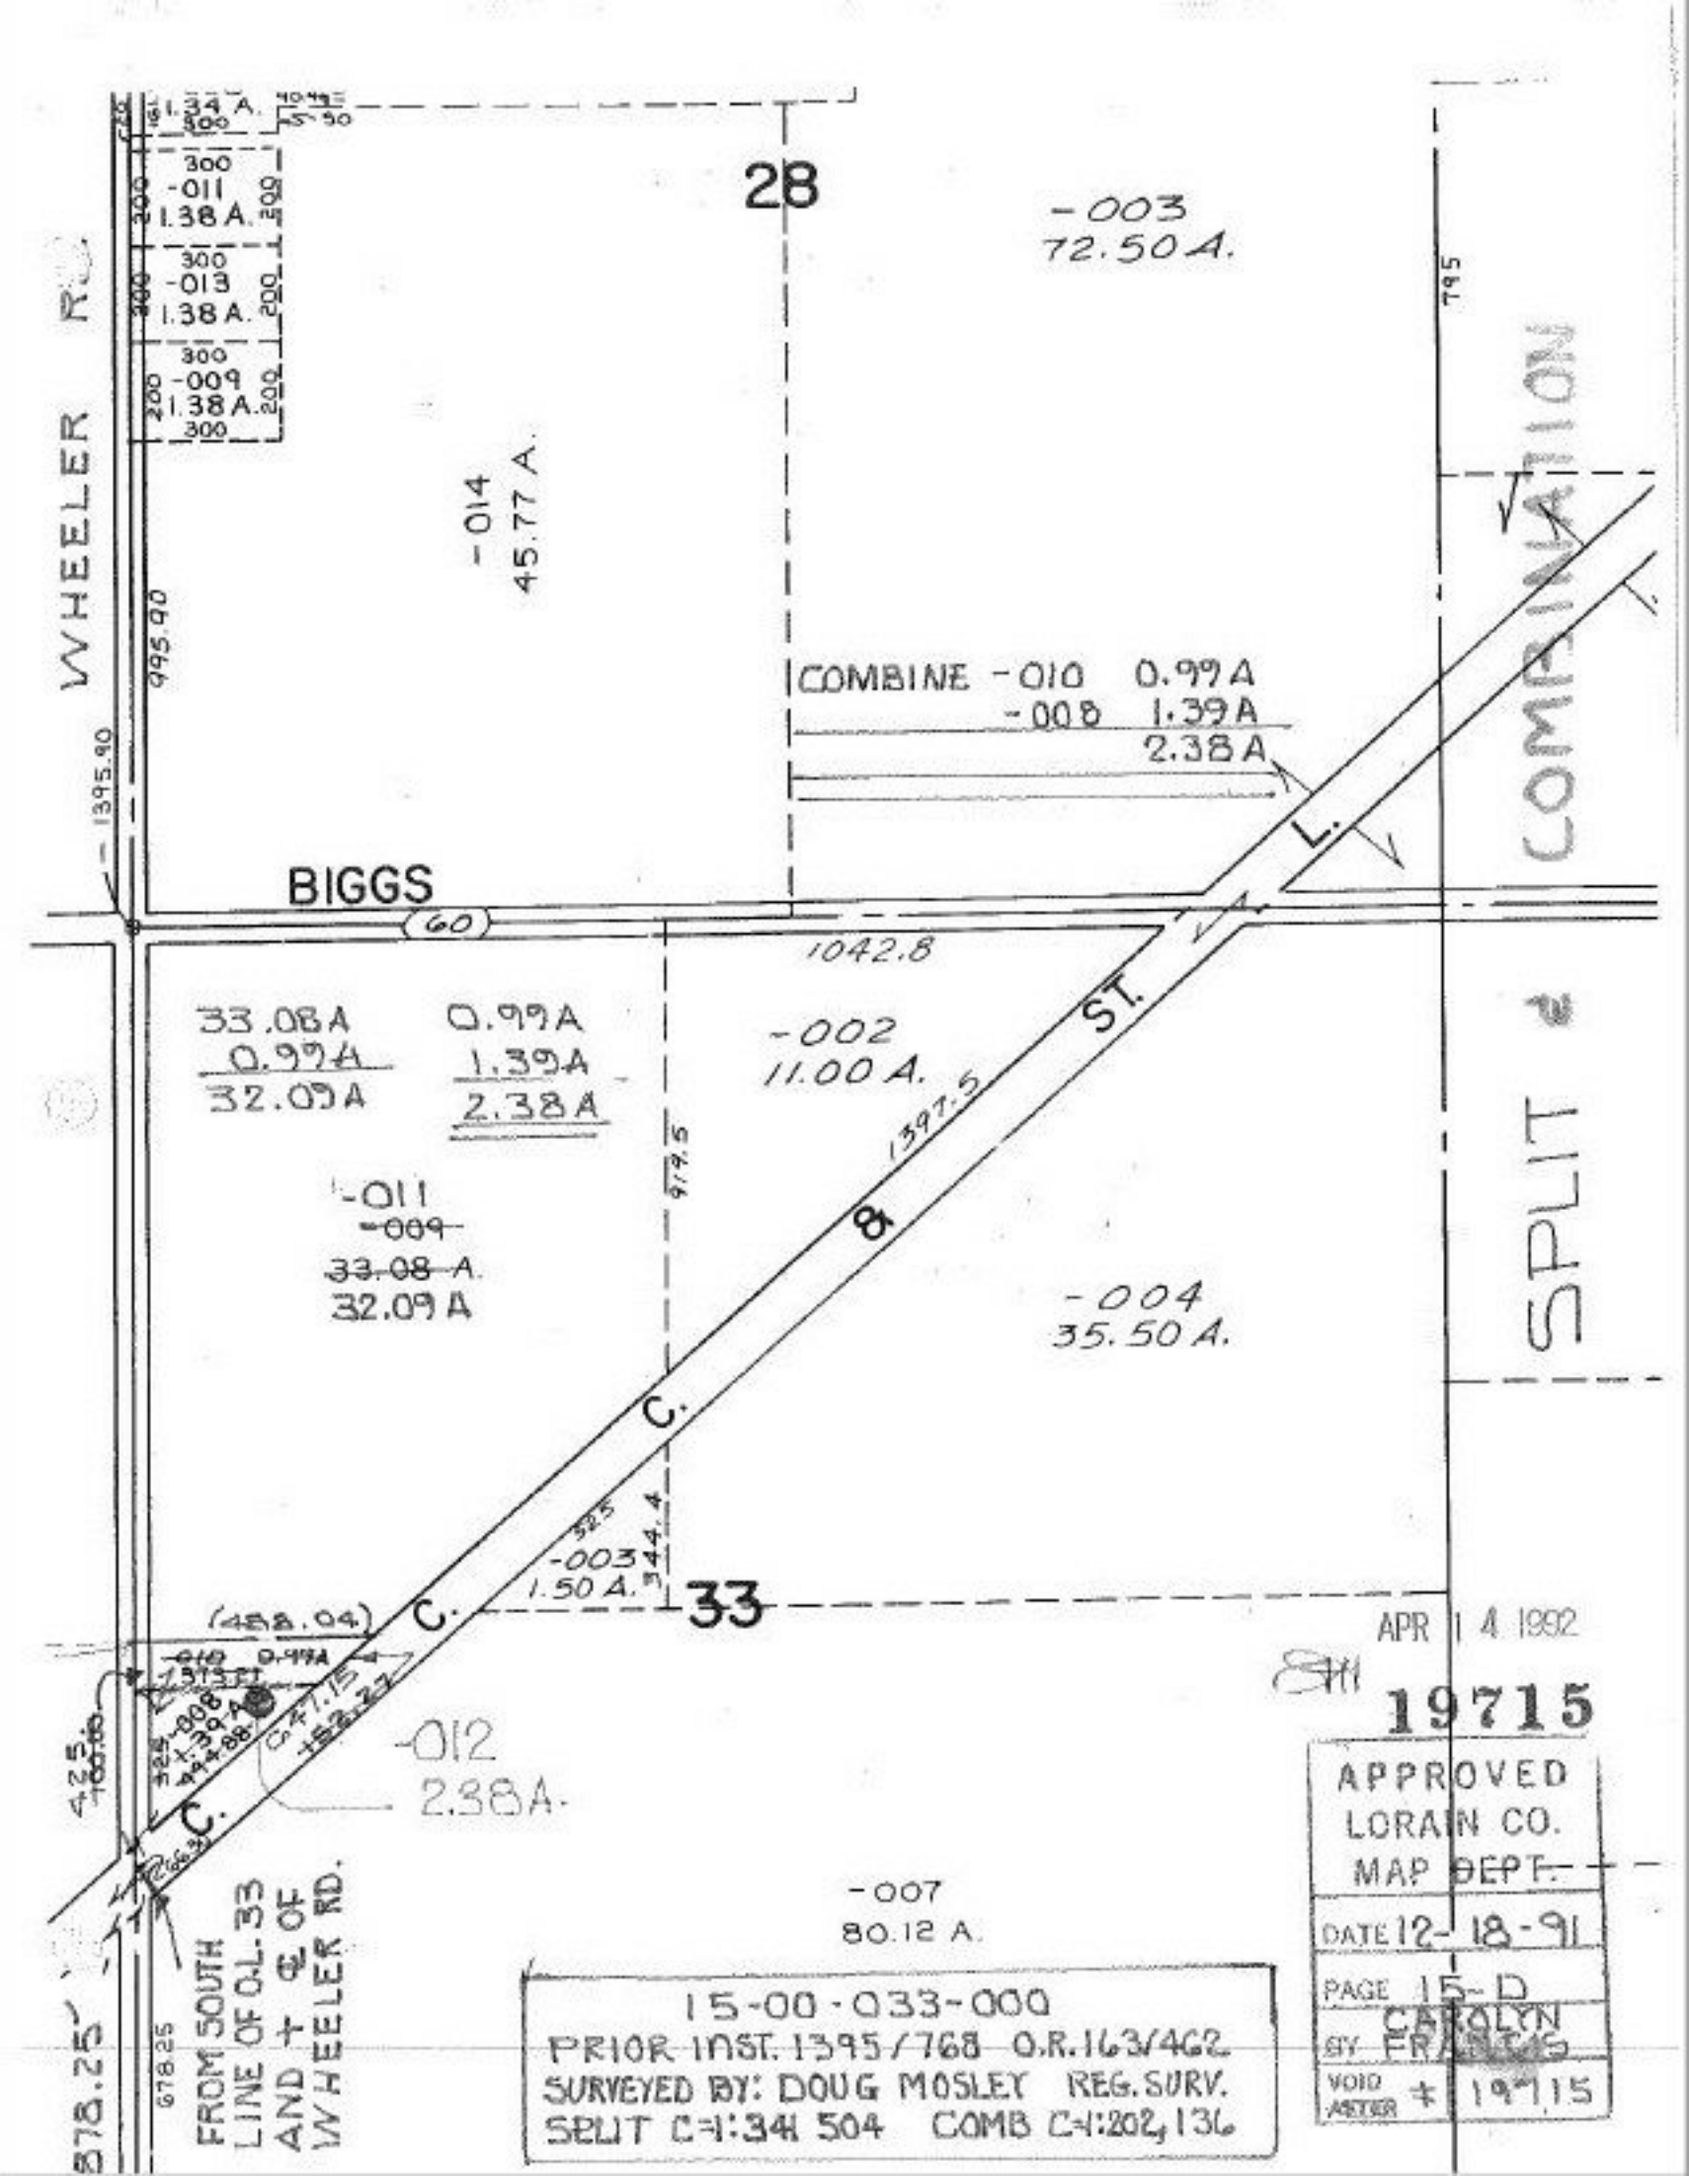
WHEELER RD.
28
-003
72.50 A.
-014
45.77 A.
795
995.90
1395.90
COMBINE -010 0.99A
-008 1.39A
2.38A
BIGGS
60
1042.8
SPLIT & COMBINATION
33.08A
0.99A
32.09A
0.99A
1.39A
2.38A
-002
11.00 A.
1397.5
ST.
979.5
-011
-009
33.08 A.
32.09 A
-004
35.50 A.
C.
525
-003
1.50 A.
344.4
33
(458.04)
APR 14 1992
19715
APPROVED
LORAIN CO.
MAP DEPT.
DATE 12-18-91
PAGE 15-D
BY CAROLYN FRANCIS
VOID AFTER + 19715
-012
2.38A.
-007
80.12 A.
15-00-033-000
PRIOR INST. 1395/768 O.R. 163/462
SURVEYED BY: DOUG MOSLEY REG. SURV.
SPLIT C-1:341 504 COMB C-1:202,136
FROM SOUTH LINE OF O.L. 33 AND ℄ OF WHEELER RD.
878.25
678.25