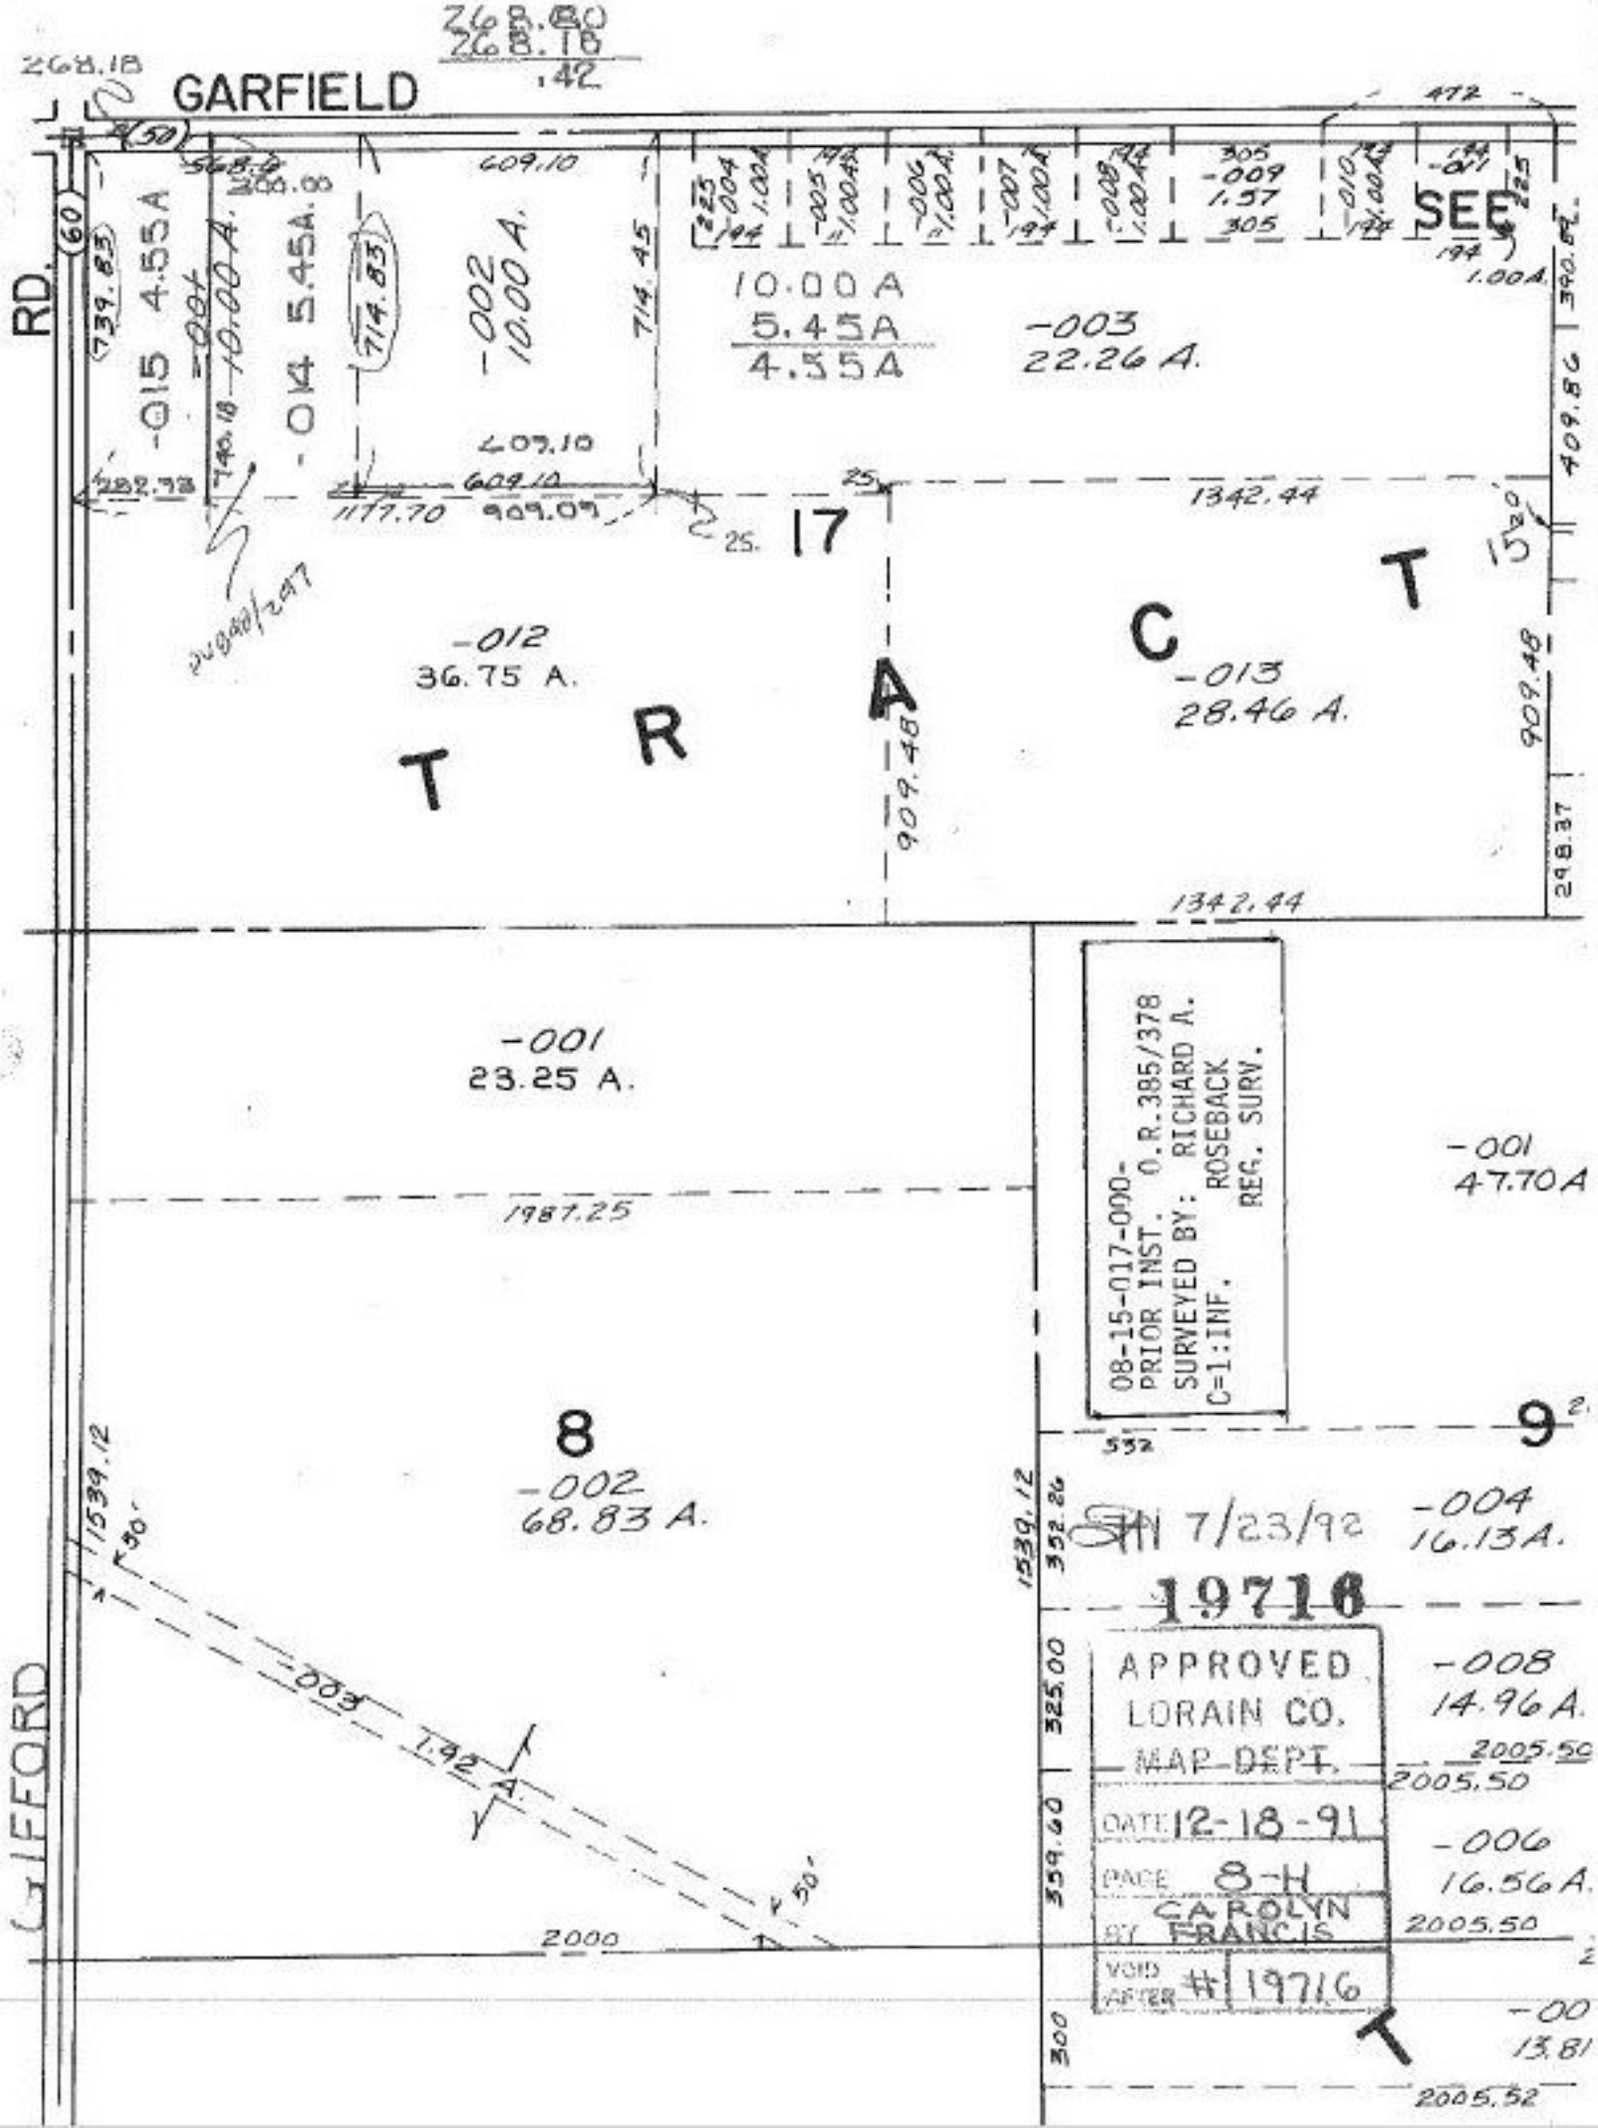
GARFIELD
RD.
GULFORD
-015 4.55A
-004
10.00A.
-014 5.45A.
-002
10.00 A.
10.00 A
5.45A
4.55A
-003
22.26 A.
SEE
-012
36.75 A.
-013
28.46 A.
-001
23.25 A.
-001
47.70A
-002
68.83 A.
-003
1.92 A.
-004
16.13A.
-008
14.96A.
-006
16.56A.
-00
13.81
17
8
9
TRACT
08-15-017-000-
PRIOR INST. O.R.385/378
SURVEYED BY: RICHARD A. ROSEBACK
C=1:INF. REG. SURV.
7/23/92
19716
APPROVED
LORAIN CO.
MAP DEPT.
DATE 12-18-91
PAGE 8-H
BY CAROLYN FRANCIS
VOID AFTER # 19716
609.10
714.45
1342.44
909.48
1987.25
2000
1539.12
2005.50