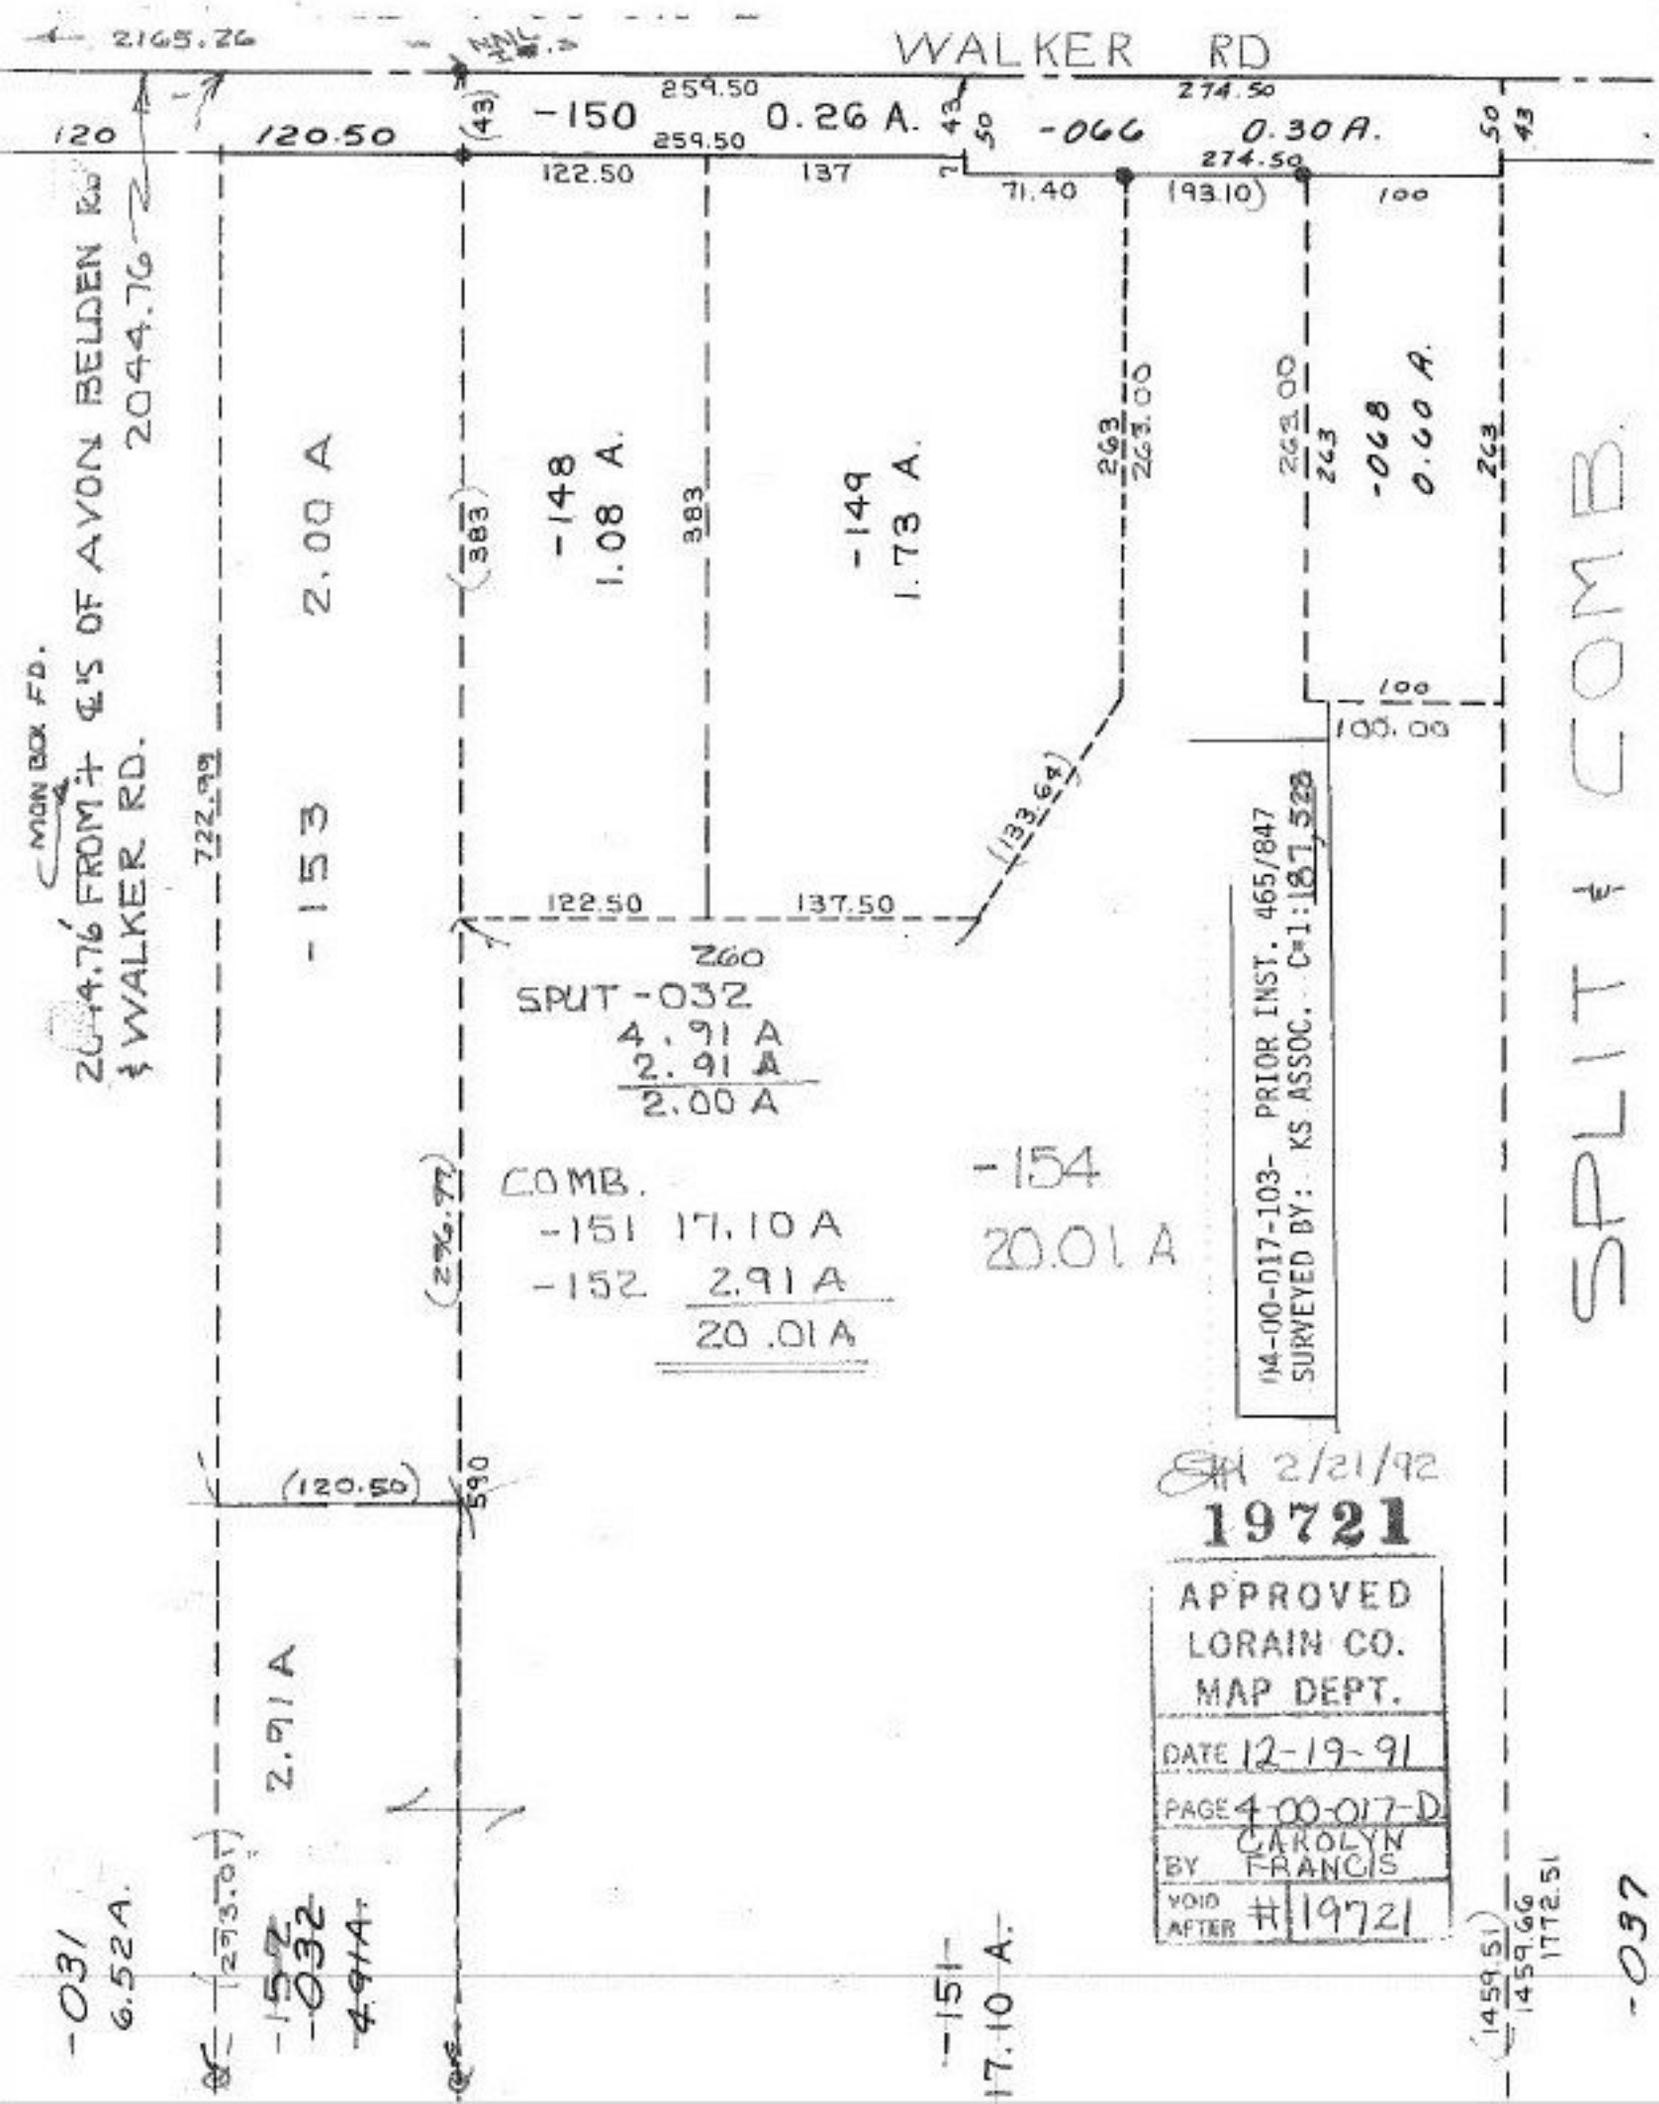

WALKER RD
2165.26
120
120.50
-150
0.26 A.
259.50
259.50
122.50
137
-066
0.30 A.
274.50
274.50
71.40
(93.10)
100
2044.76
2044.76' FROM ℄'S OF AVON BELDEN RD & WALKER RD.
MON BOX FD.
2.00 A
-153
722.99
-148
1.08 A.
383
-149
1.73 A.
263
263.00
-068
0.60 A.
100
100.00
(133.64)
122.50
137.50
260
SPUT -032
4.91 A
2.91 A
2.00 A
COMB.
-151 17.10 A
-152 2.91 A
20.01 A
-154
20.01 A
(296.77)
(120.50)
590
2.91 A
-031
6.52 A.
-152
-032
4.91 A
-151
17.10 A.
1459.51
1459.66
1772.51
-037
SPLIT & COMB
04-00-017-103- PRIOR INST. 465/847
SURVEYED BY: KS ASSOC. C=1:187,528
2/21/92
19721
APPROVED
LORAIN CO.
MAP DEPT.
DATE 12-19-91
PAGE 4-00-017-D
BY CAROLYN FRANCIS
VOID AFTER # 19721