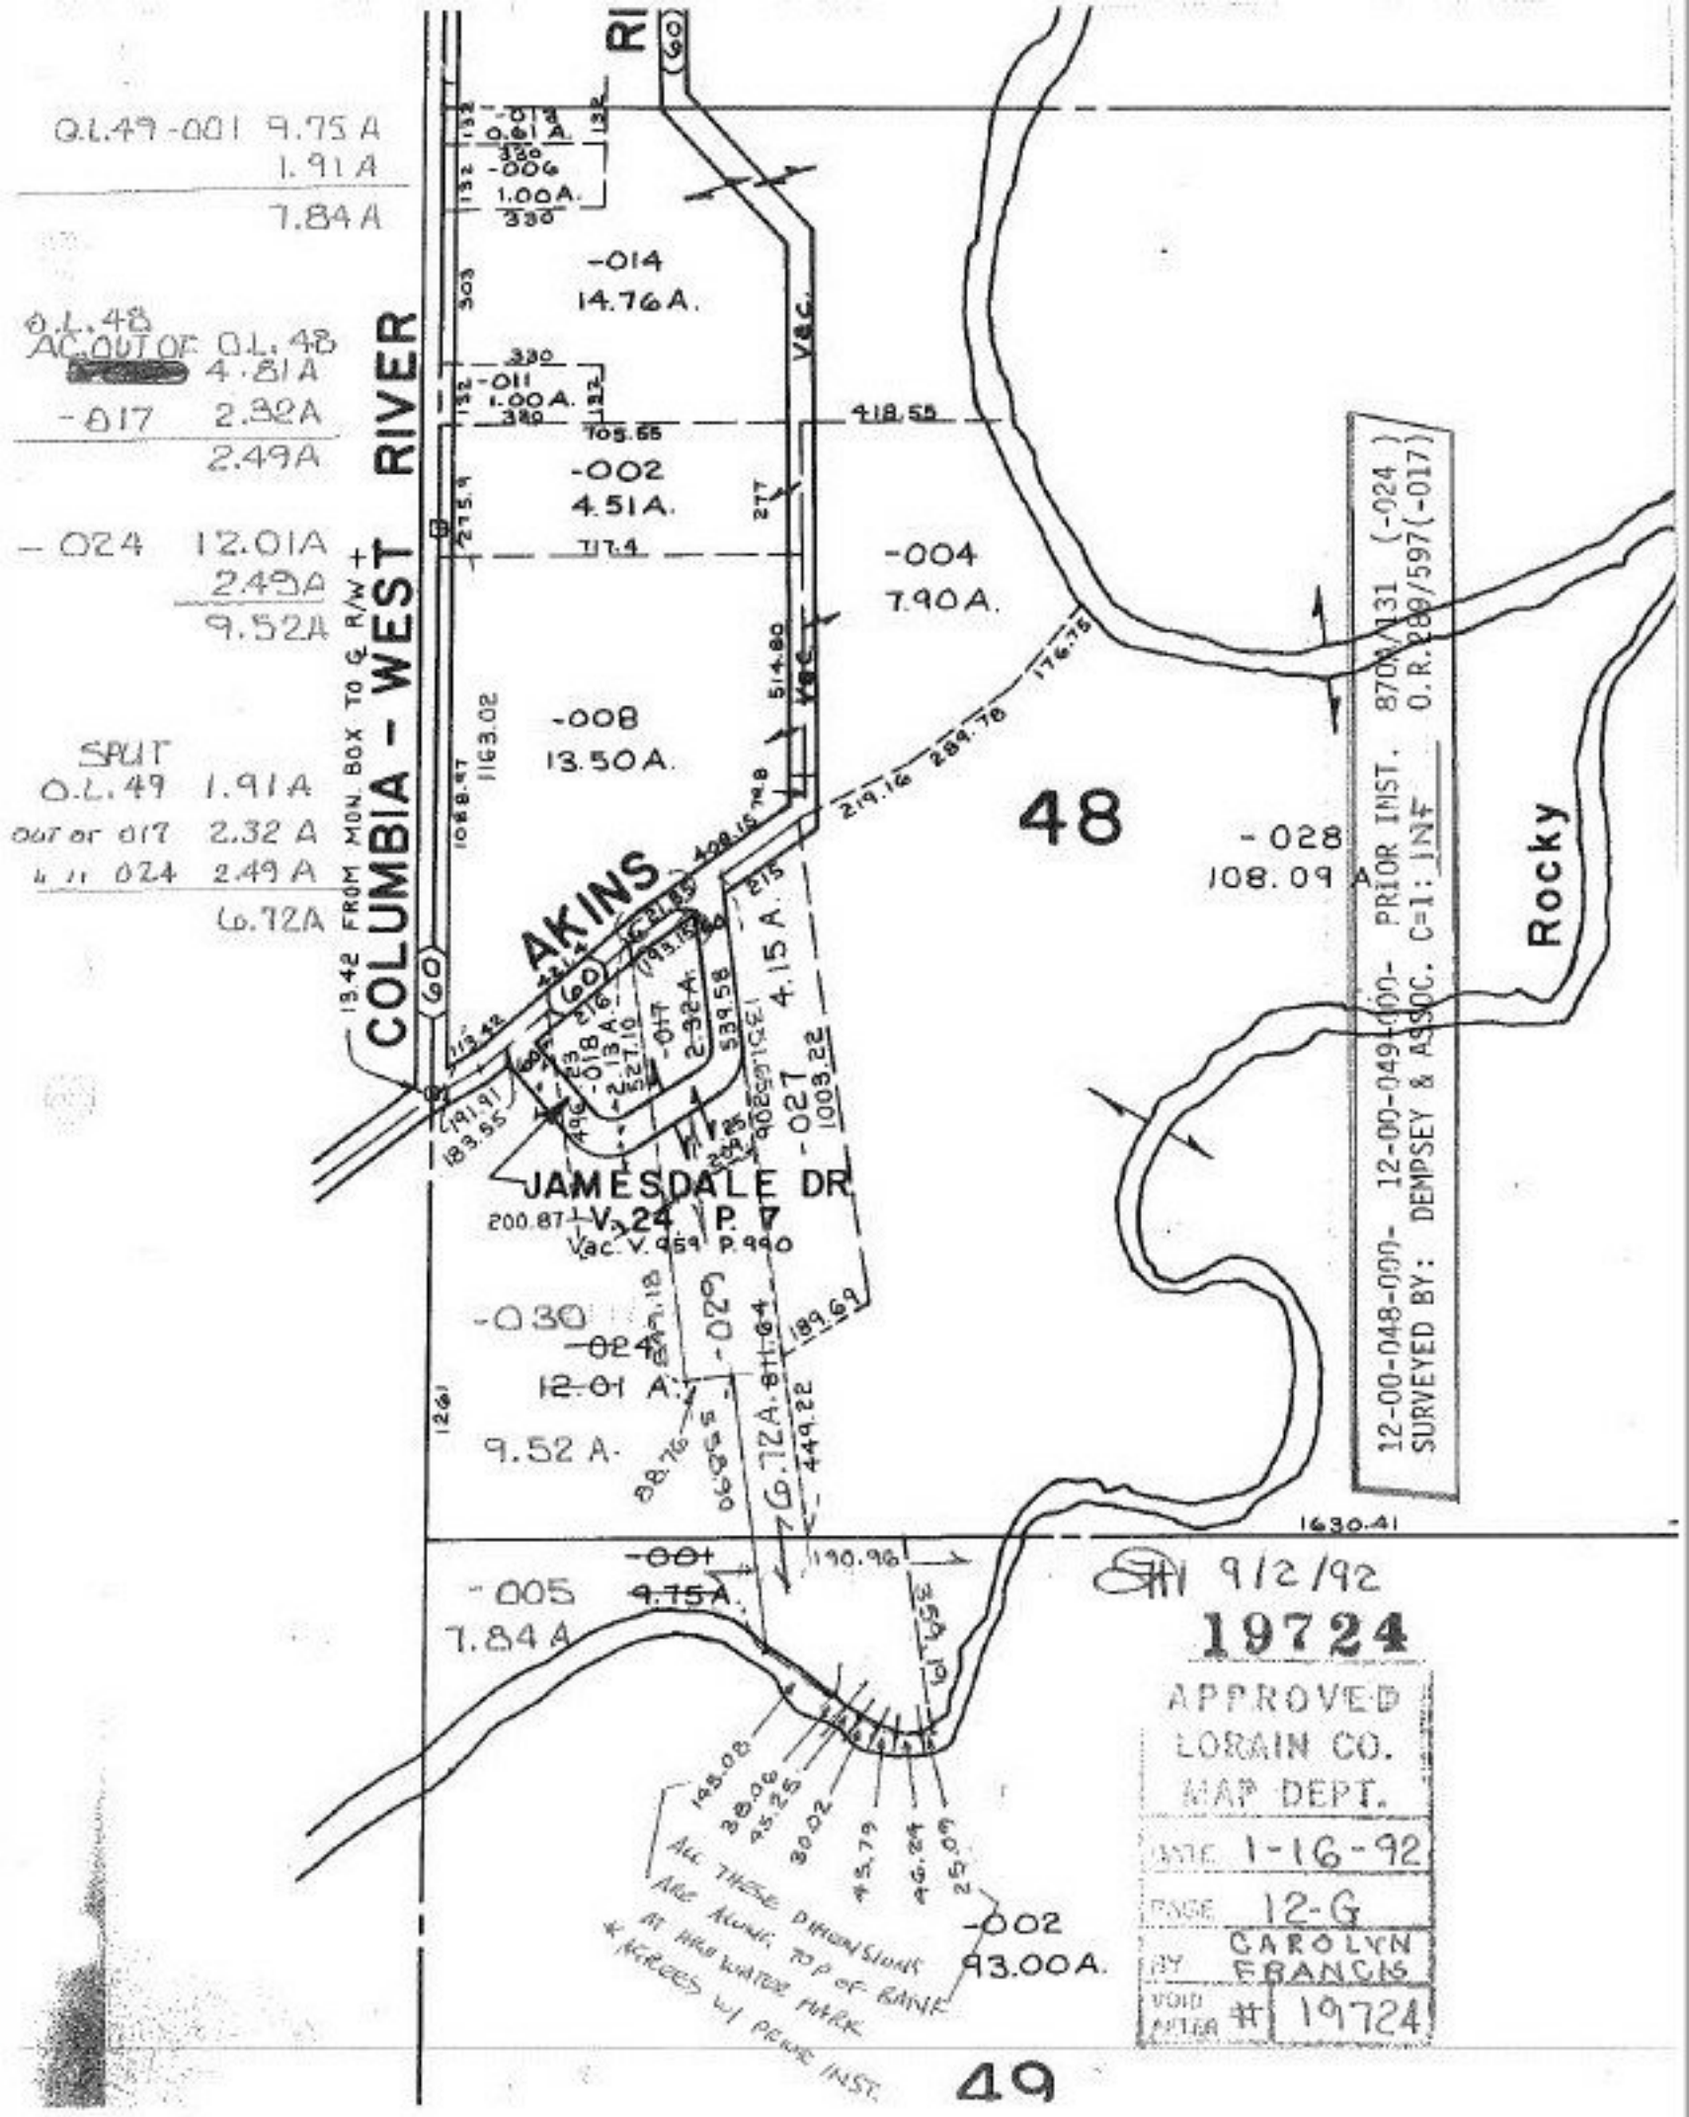

O.L.49-001 9.75 A
1.91 A
7.84 A
O.L.48
AC. OUT OF O.L.48
4.81 A
-017 2.32 A
2.49 A
-024 12.01 A
2.49 A
9.52 A
SPLIT
O.L.49 1.91 A
OUT OF 017 2.32 A
" " 024 2.49 A
6.72 A
COLUMBIA - WEST RIVER
13.42 FROM MON. BOX TO ℄ R/W +
AKINS
JAMESDALE DR
V. 24 P. 7
Vac. V. 959 P. 990
-014
14.76 A.
-002
4.51 A.
-004
7.90 A.
-008
13.50 A.
-028
108.09 A
48
Rocky
-030
-024
12.01 A.
9.52 A.
-029
6.72 A.
-001
9.75 A.
-005
7.84 A
-002
93.00 A.
ALL THESE DIMENSIONS ARE ALONG TOP OF BANK AT HIGH WATER MARK & AGREES W/ PRIOR INST.
12-00-048-000- 12-00-049-000- PRIOR INST. 870A/131 (-024)
SURVEYED BY: DEMPSEY & ASSOC. C=1: INF O.R. 289/597 (-017)
9/2/92
19724
APPROVED
LORAIN CO.
MAP DEPT.
DATE 1-16-92
PAGE 12-G
BY CAROLYN FRANCIS
VOID AFTER # 19724
49