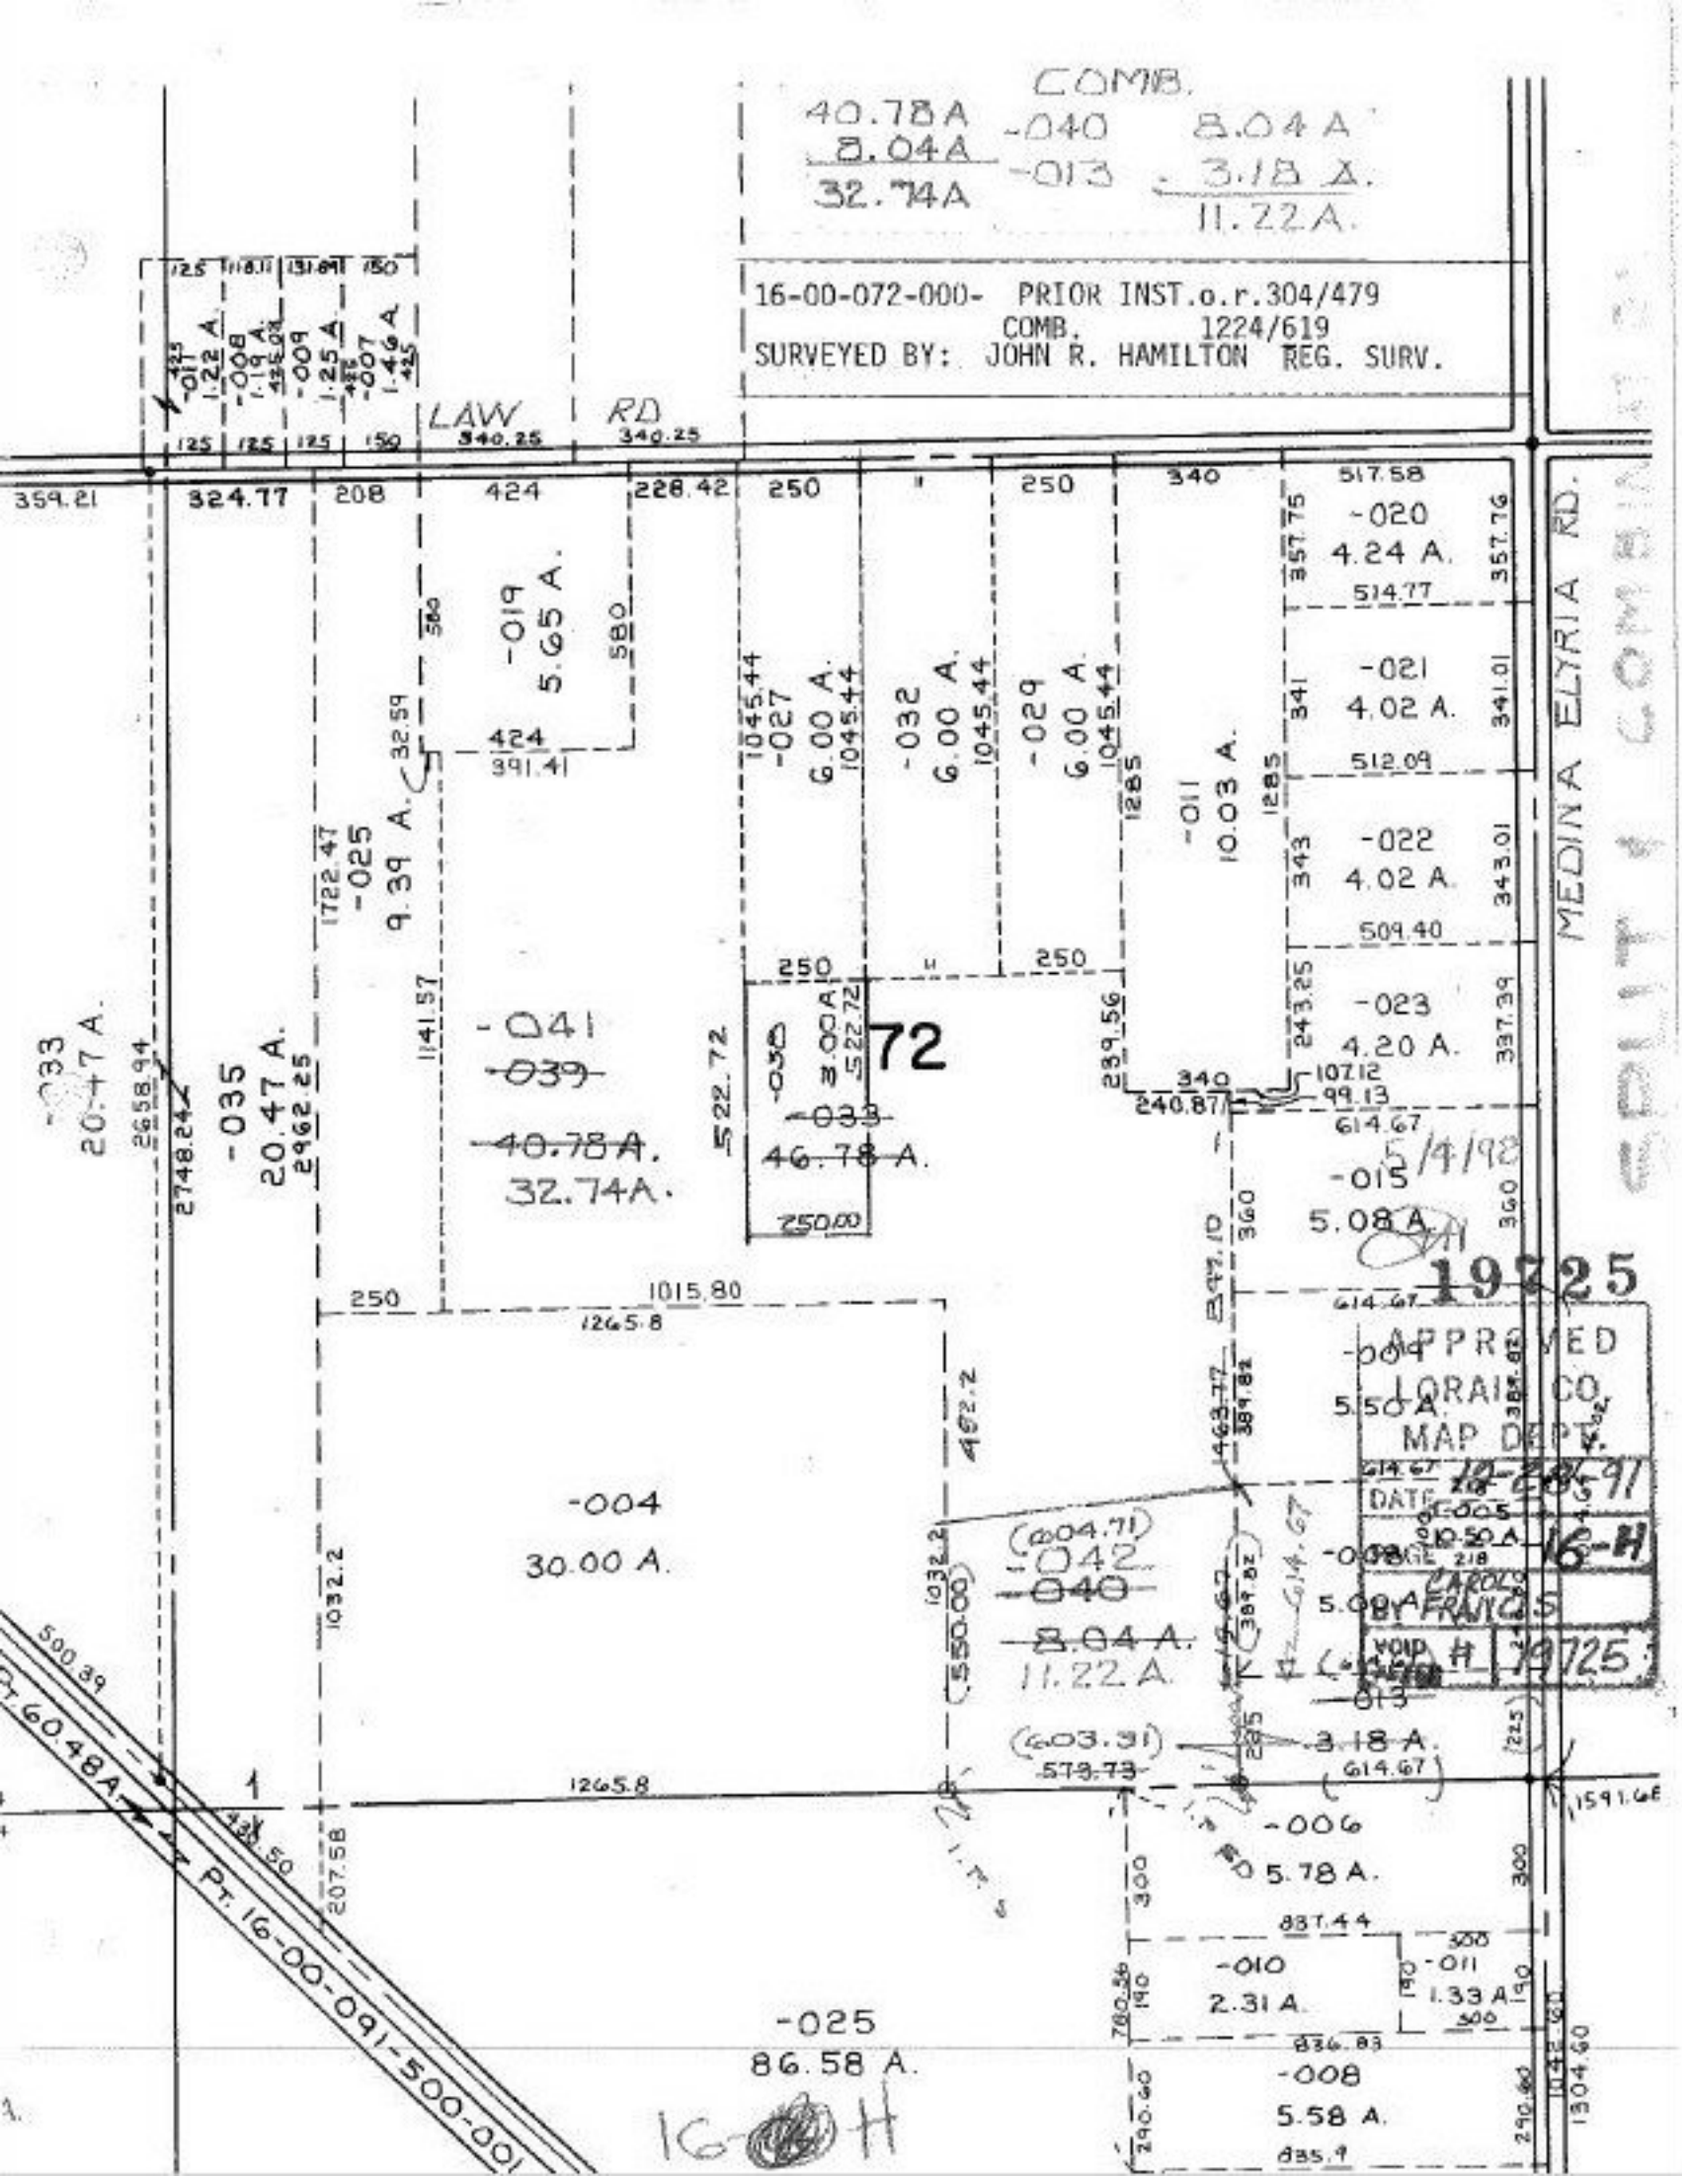
COMB.
40.78A -040 8.04A
8.04A -013 3.18 A.
32.74A 11.22A.
16-00-072-000- PRIOR INST.o.r.304/479
COMB. 1224/619
SURVEYED BY: JOHN R. HAMILTON REG. SURV.
LAW RD
MEDINA ELYRIA RD.
SPLIT & COMBINATION
-020 4.24 A.
-021 4.02 A.
-022 4.02 A.
-023 4.20 A.
-019 5.65 A.
-025 9.39 A.
-027 6.00 A.
-032 6.00 A.
-029 6.00 A.
-011 10.03 A.
-041
-039
40.78A.
32.74A.
-033
46.78 A.
72
-015 5.08 A.
5/4/92
19725
APPROVED
LORAIN CO.
MAP DEPT.
DATE 10-28-91
CAROL
BY FRANCIS
VOID # 19725
-004 30.00 A.
-042
-040
8.04 A.
11.22 A.
-013
3.18 A.
-006 5.78 A.
-010 2.31 A.
-011 1.33 A.
-008 5.58 A.
-025 86.58 A.
-035 20.47 A.
-033 20.47 A.
Pt. 16-00-091-500-001
Pt. 60.48A.
16-H