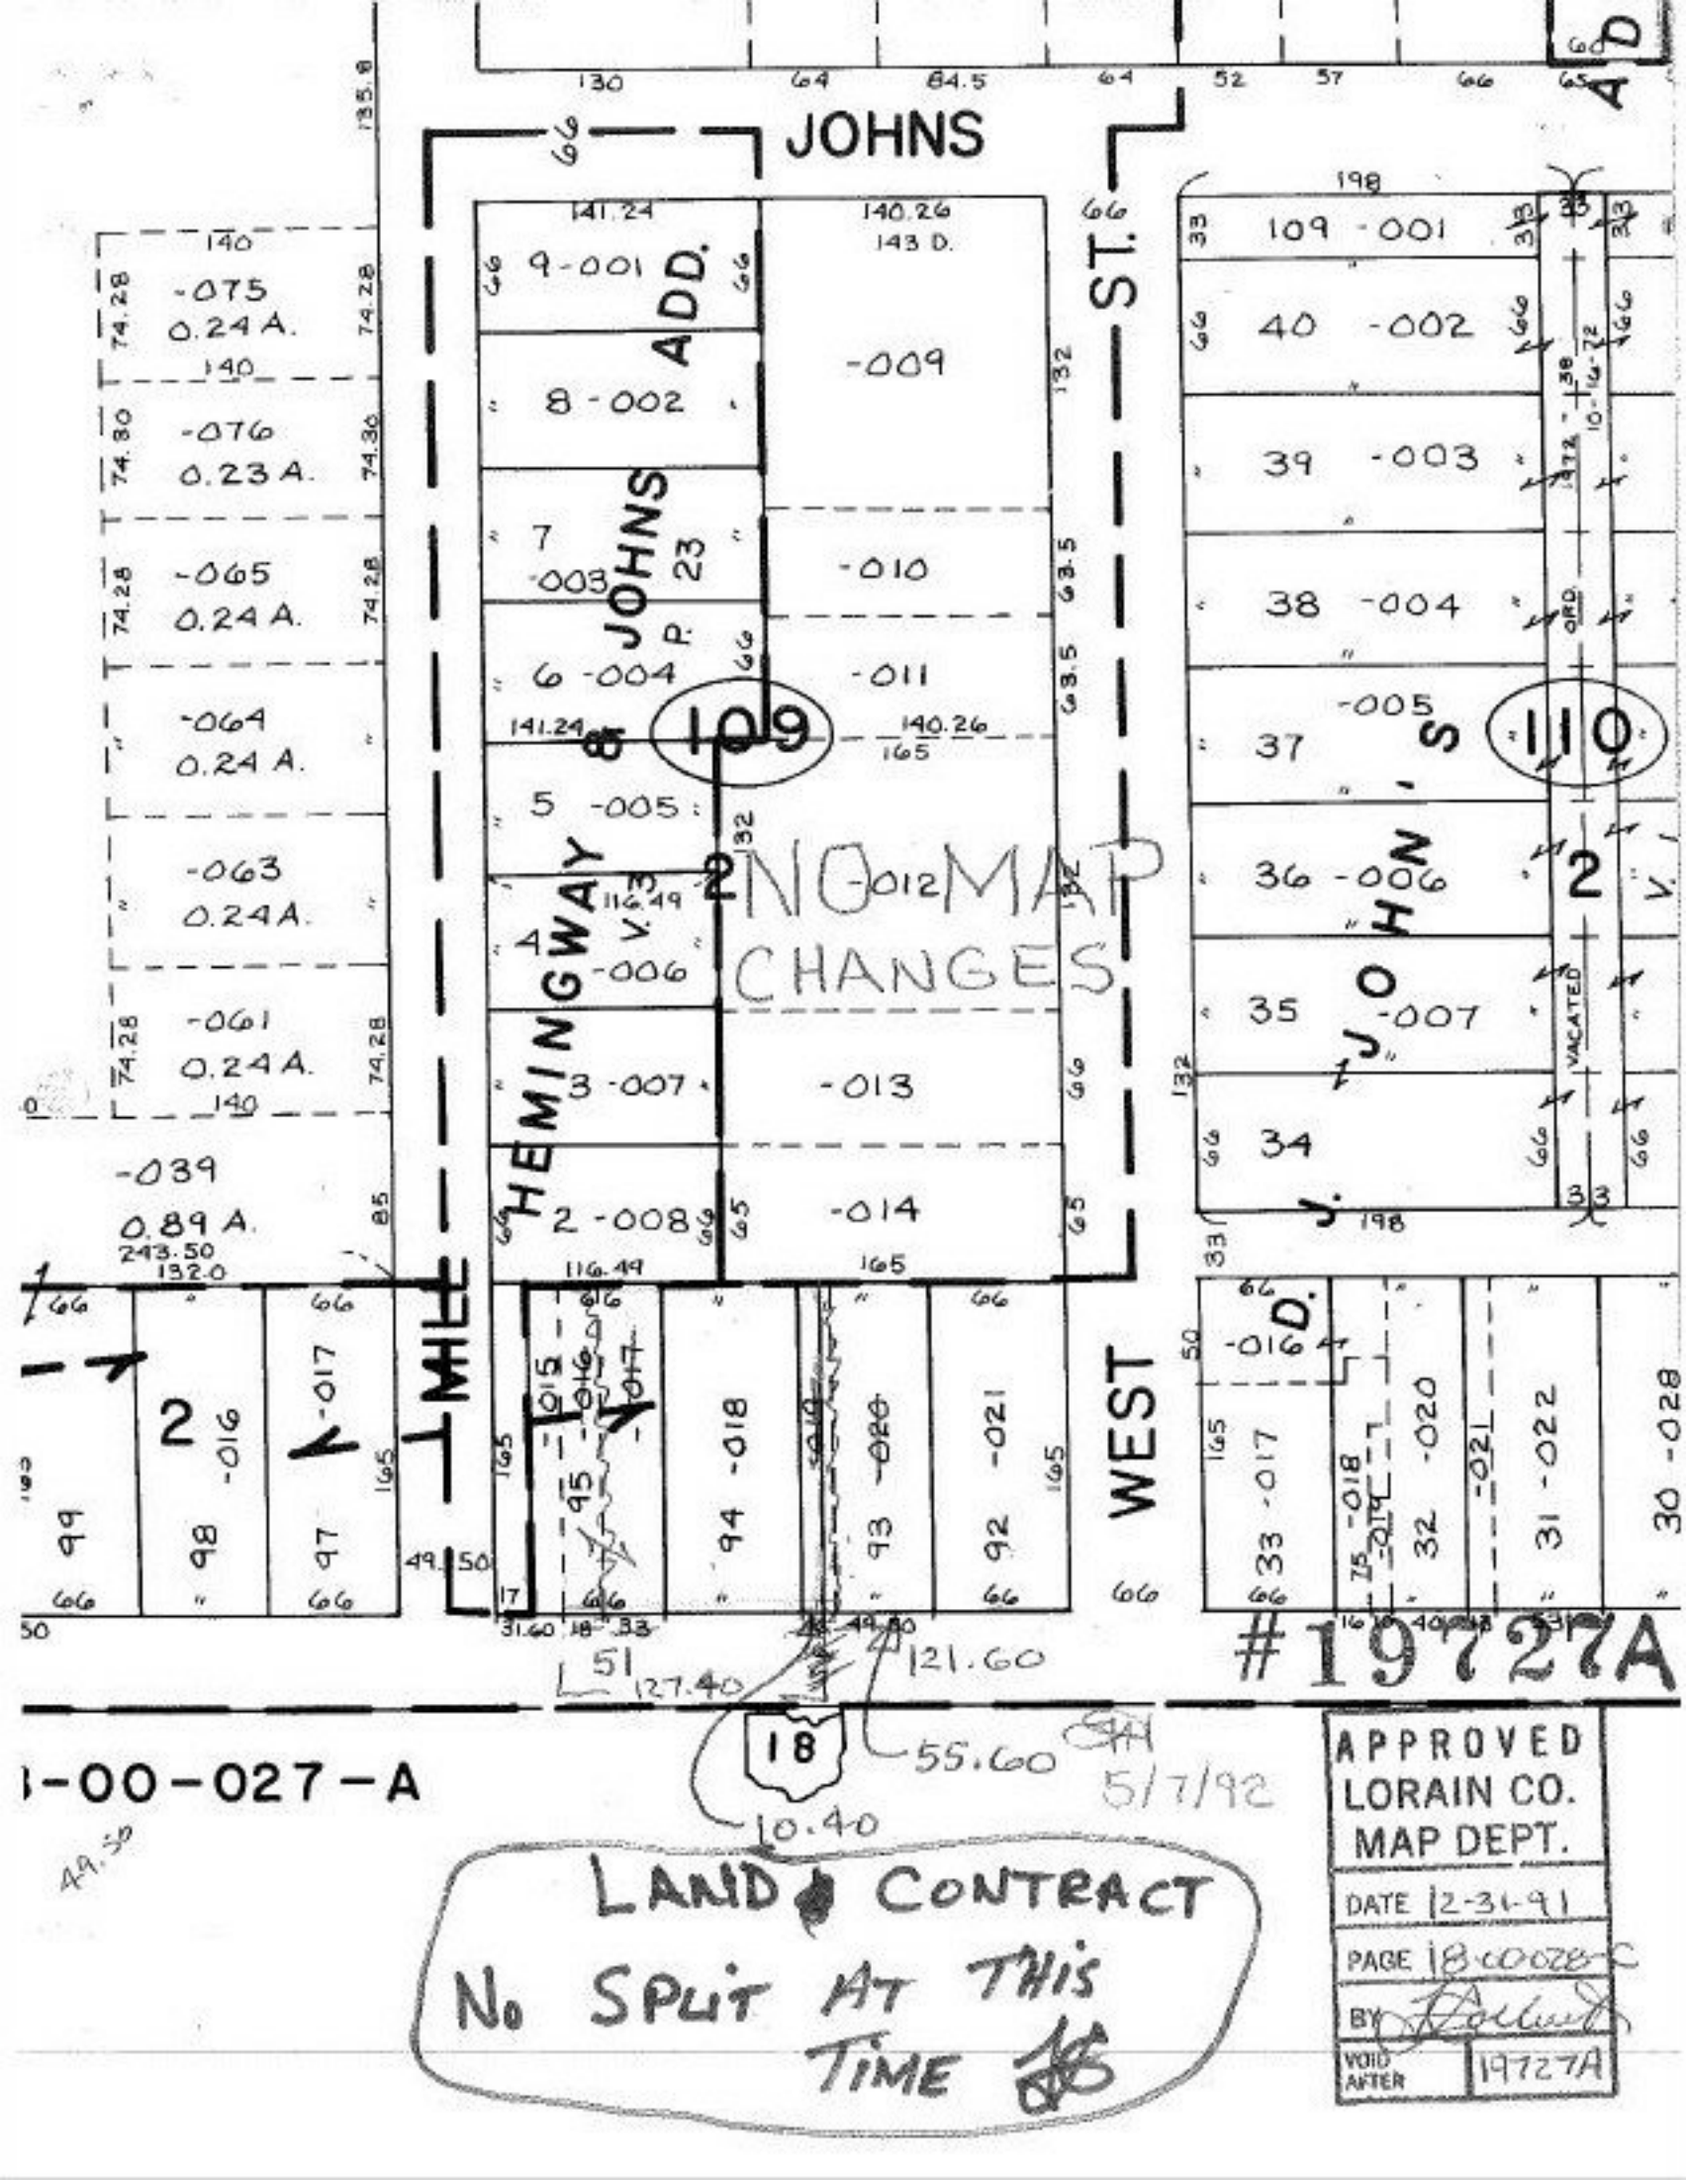
JOHNS
ST.
WEST
HEMINGWAY
JOHNS ADD.
JOHNS
109
110
NO MAP CHANGES
#19727A
APPROVED
LORAIN CO.
MAP DEPT.
DATE 12-31-91
PAGE 18-0028-C
BY
VOID AFTER 19727A
LAND CONTRACT
No Split At This Time
5/7/92
1-00-027-A