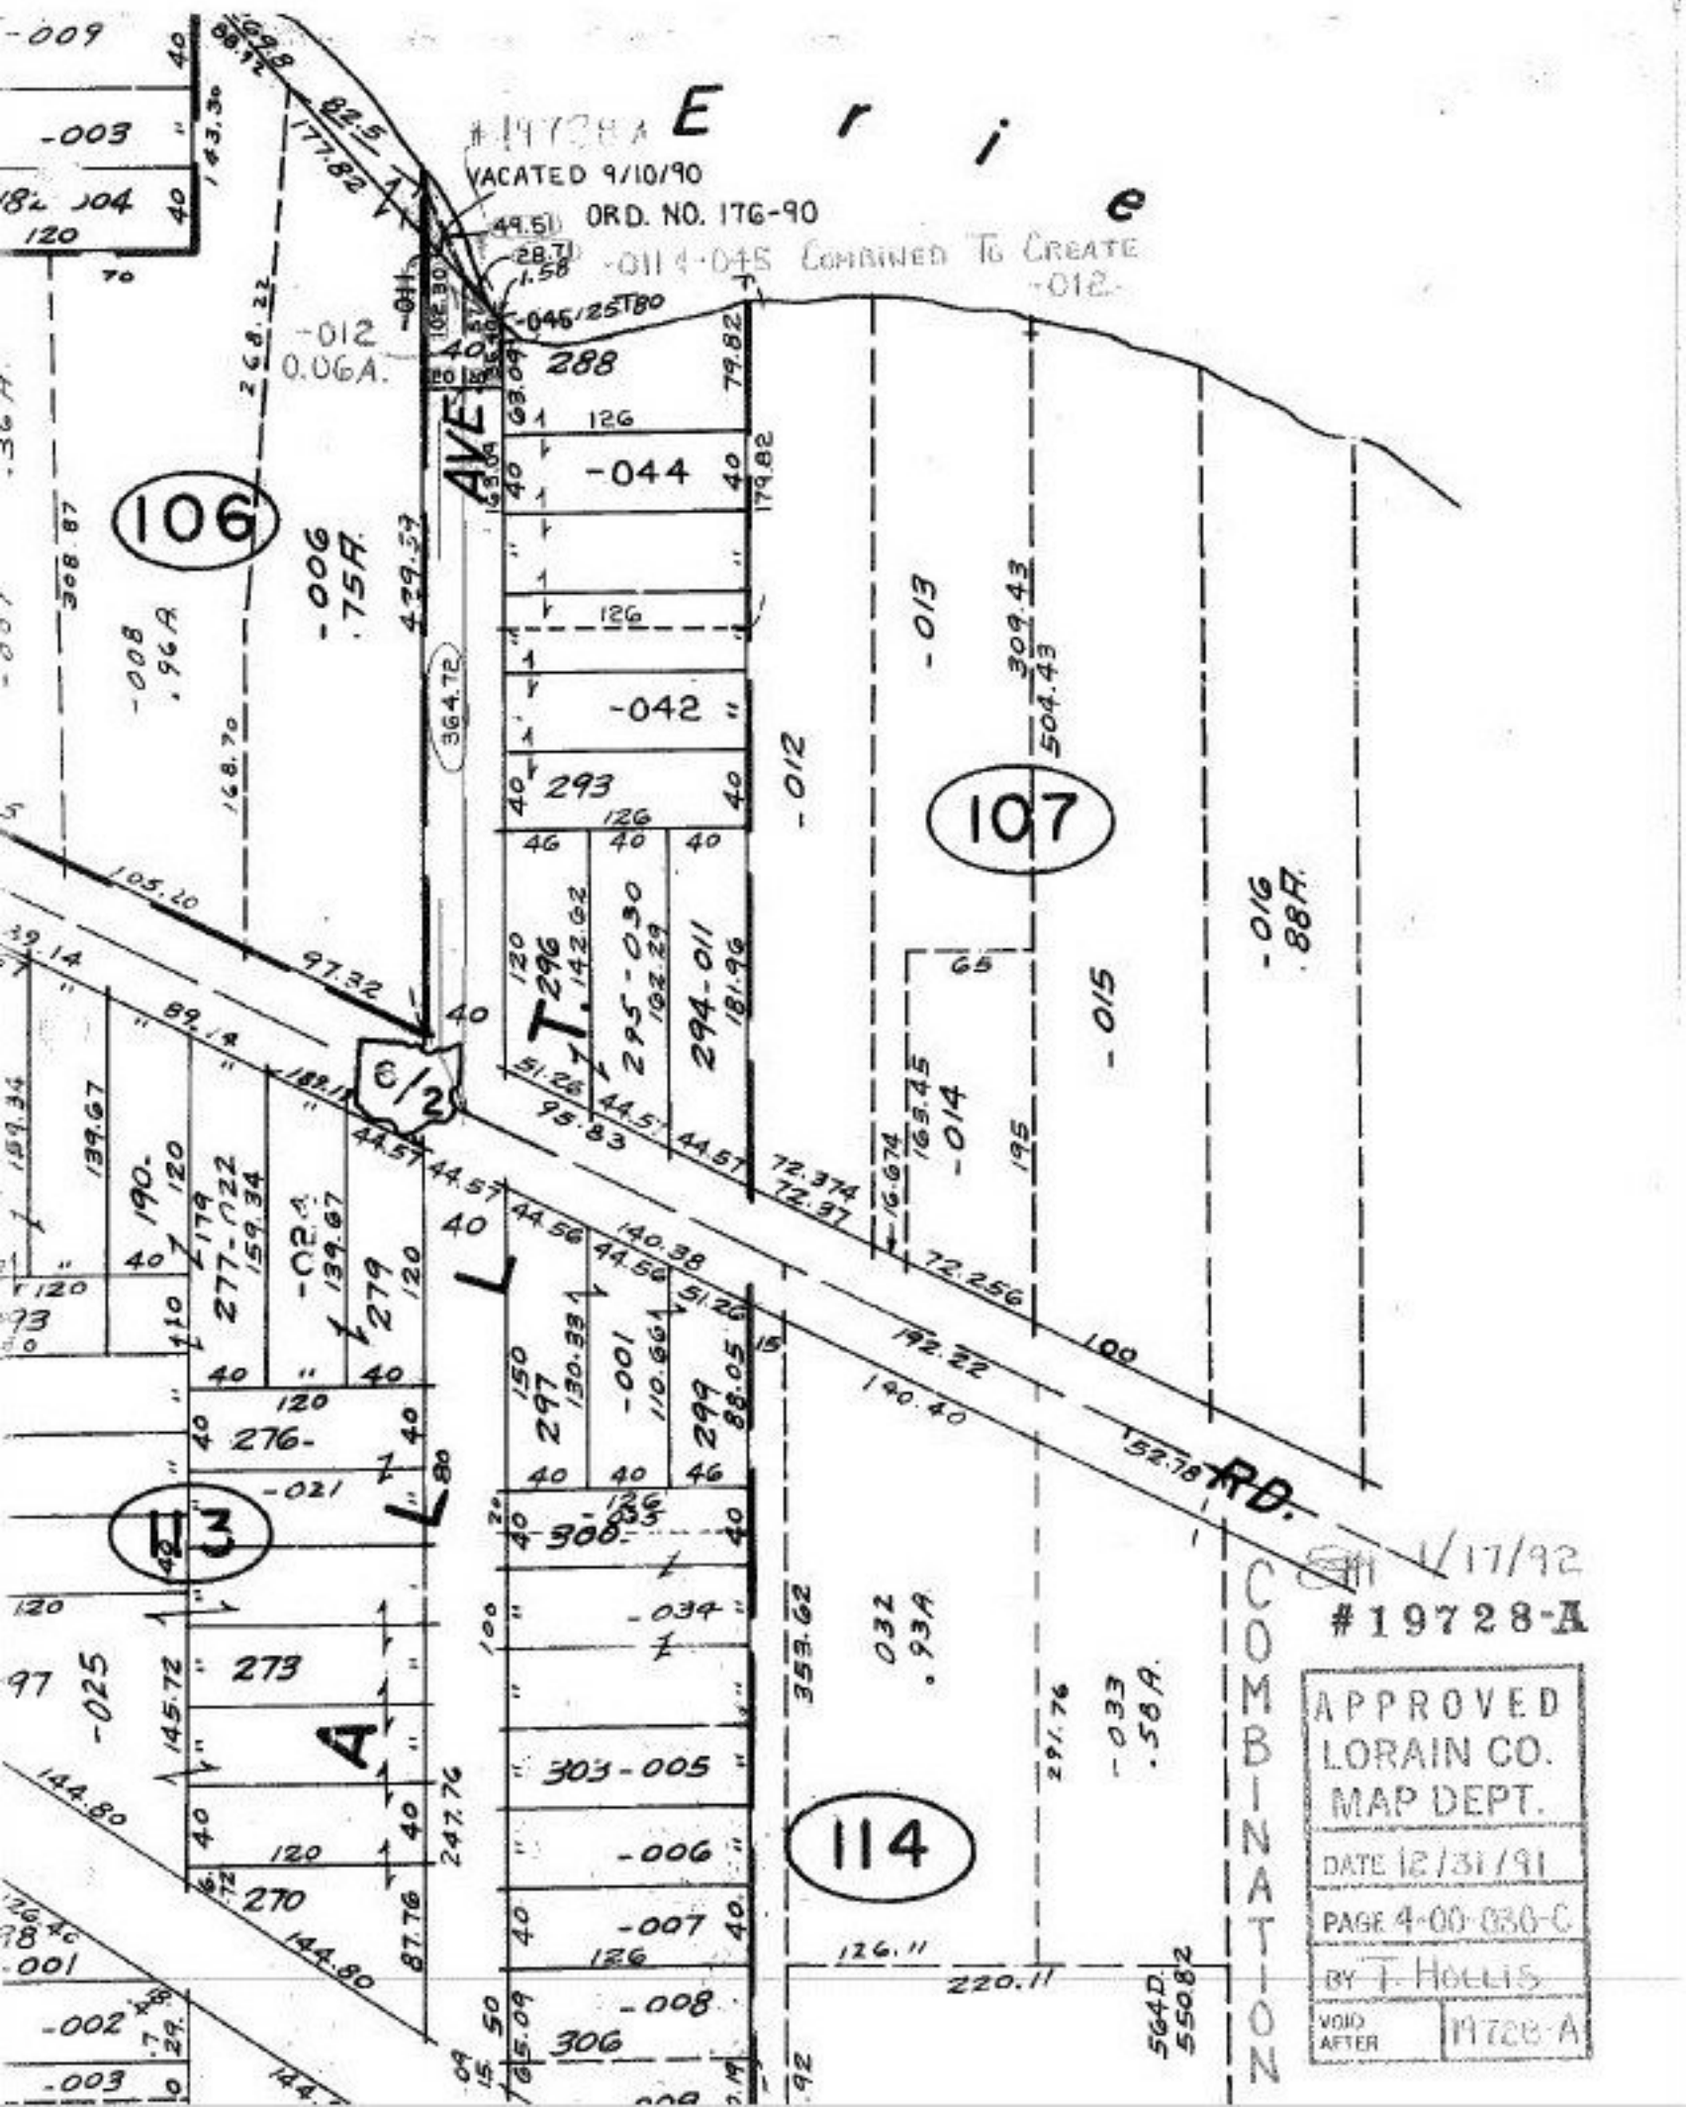
#19728-A
VACATED 9/10/90
ORD. NO. 176-90
-011 -045 COMBINED TO CREATE -012-
-012
0.06A.
-046/25TBO
288
-044
293
-042
106
107
114
-006
.75A.
-008
.96A
-013
-012
-015
-014
-016
.88A.
-025
-021
-033
-034
-001
-007
-008
-002
-003
-009
-011
-012
-022
-023
-024
-030
-031
