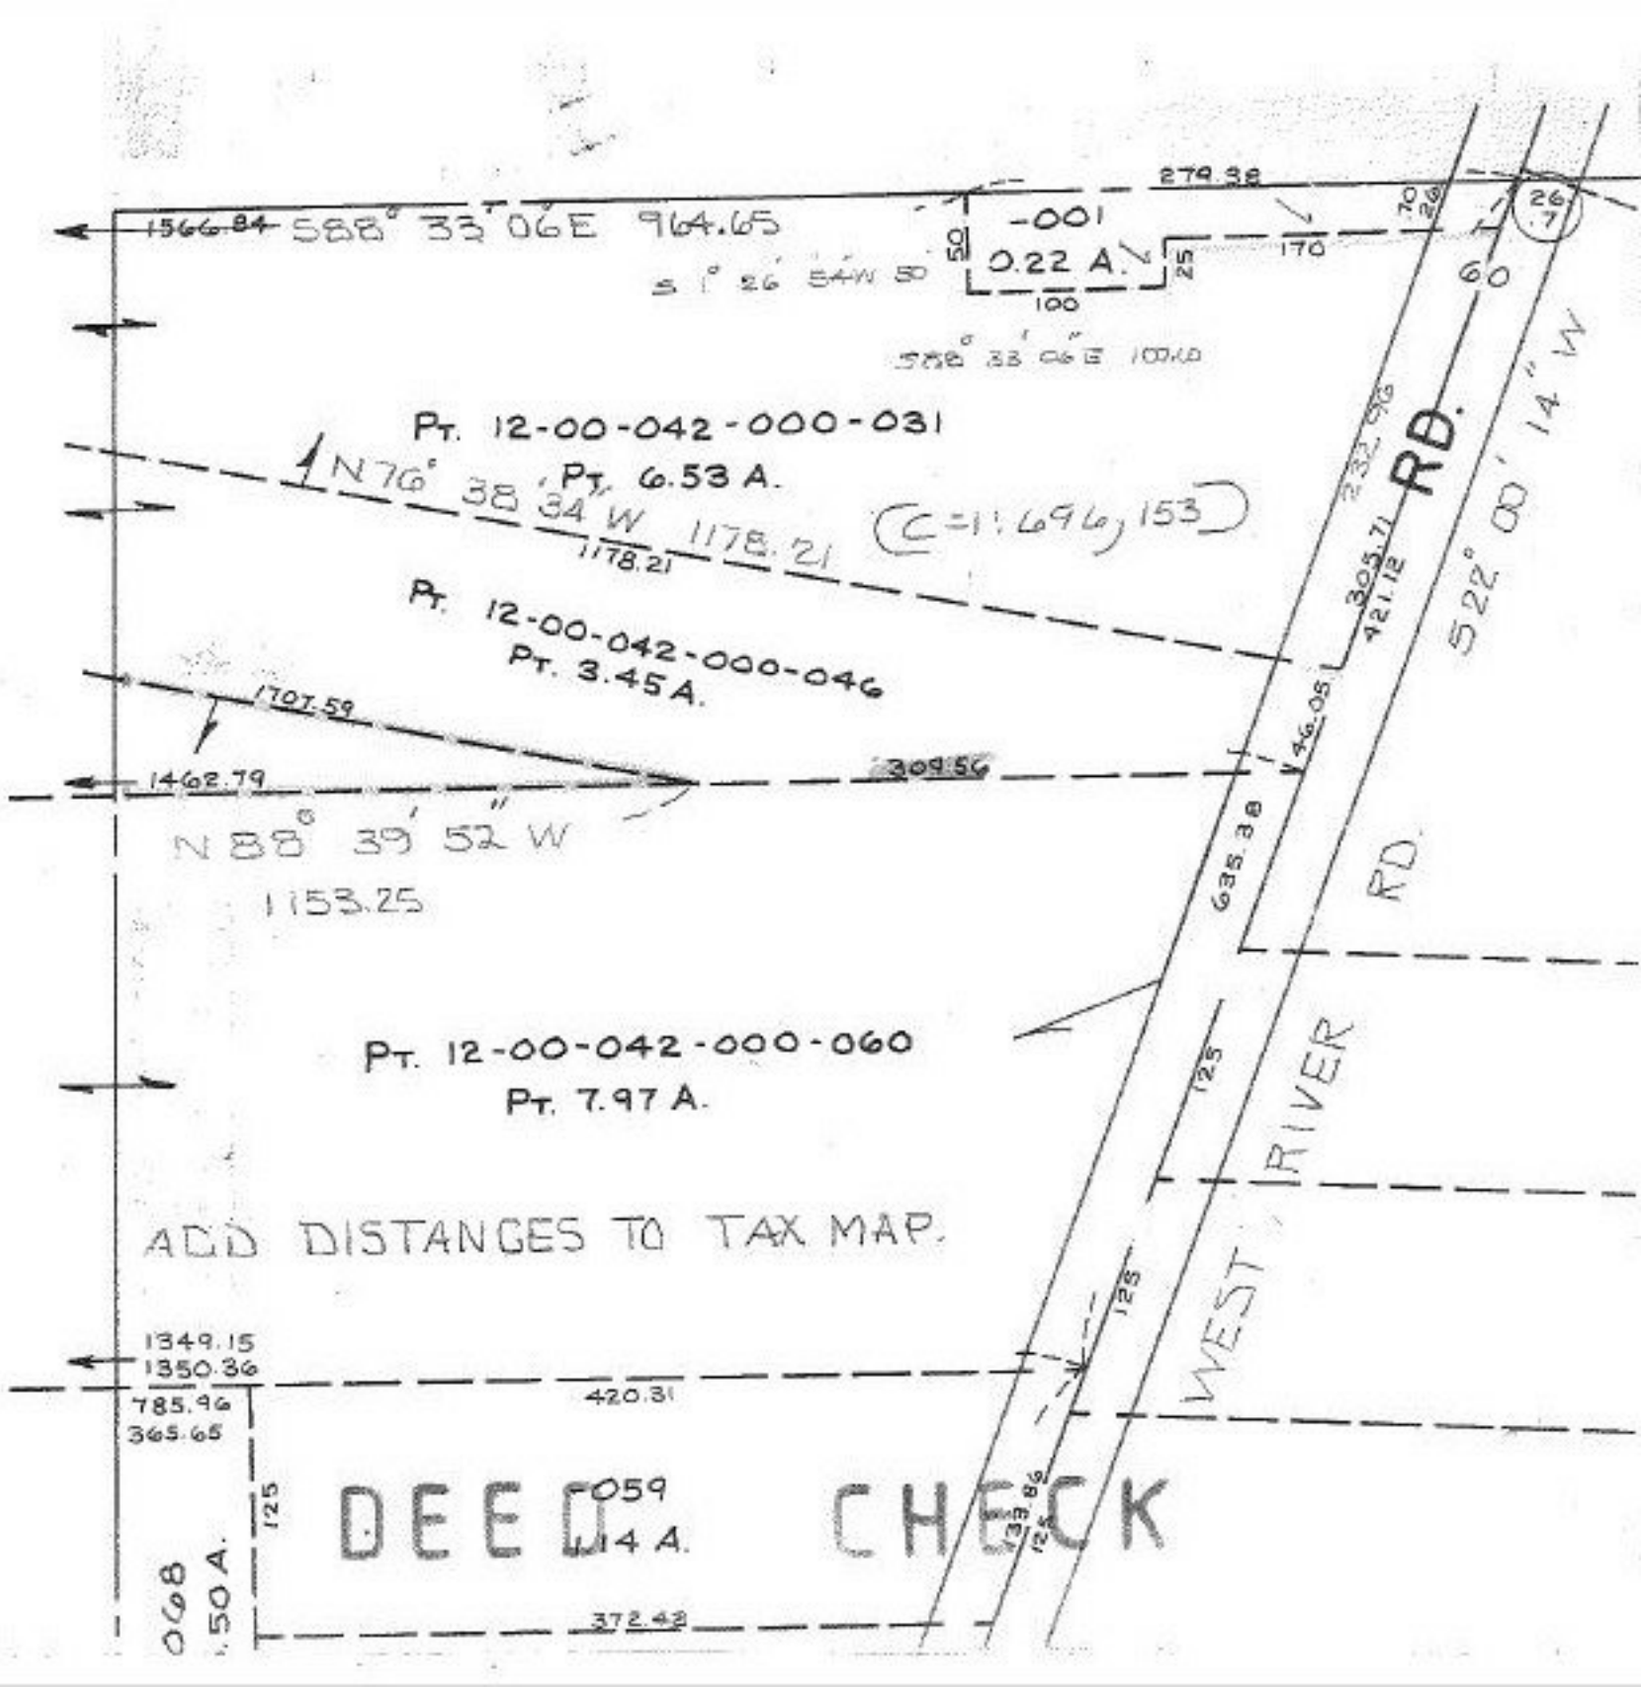

REF: DEEDS
1228/755
O.R.V. 203/672

9/2/92
19729A

APPROVED LORAIN CO. MAP DEPT.	
DATE 1-22-92	
PAGE 12-00-039-	A
BY CAROLYN FRANCIS	
VOID AFTER #	19729-A