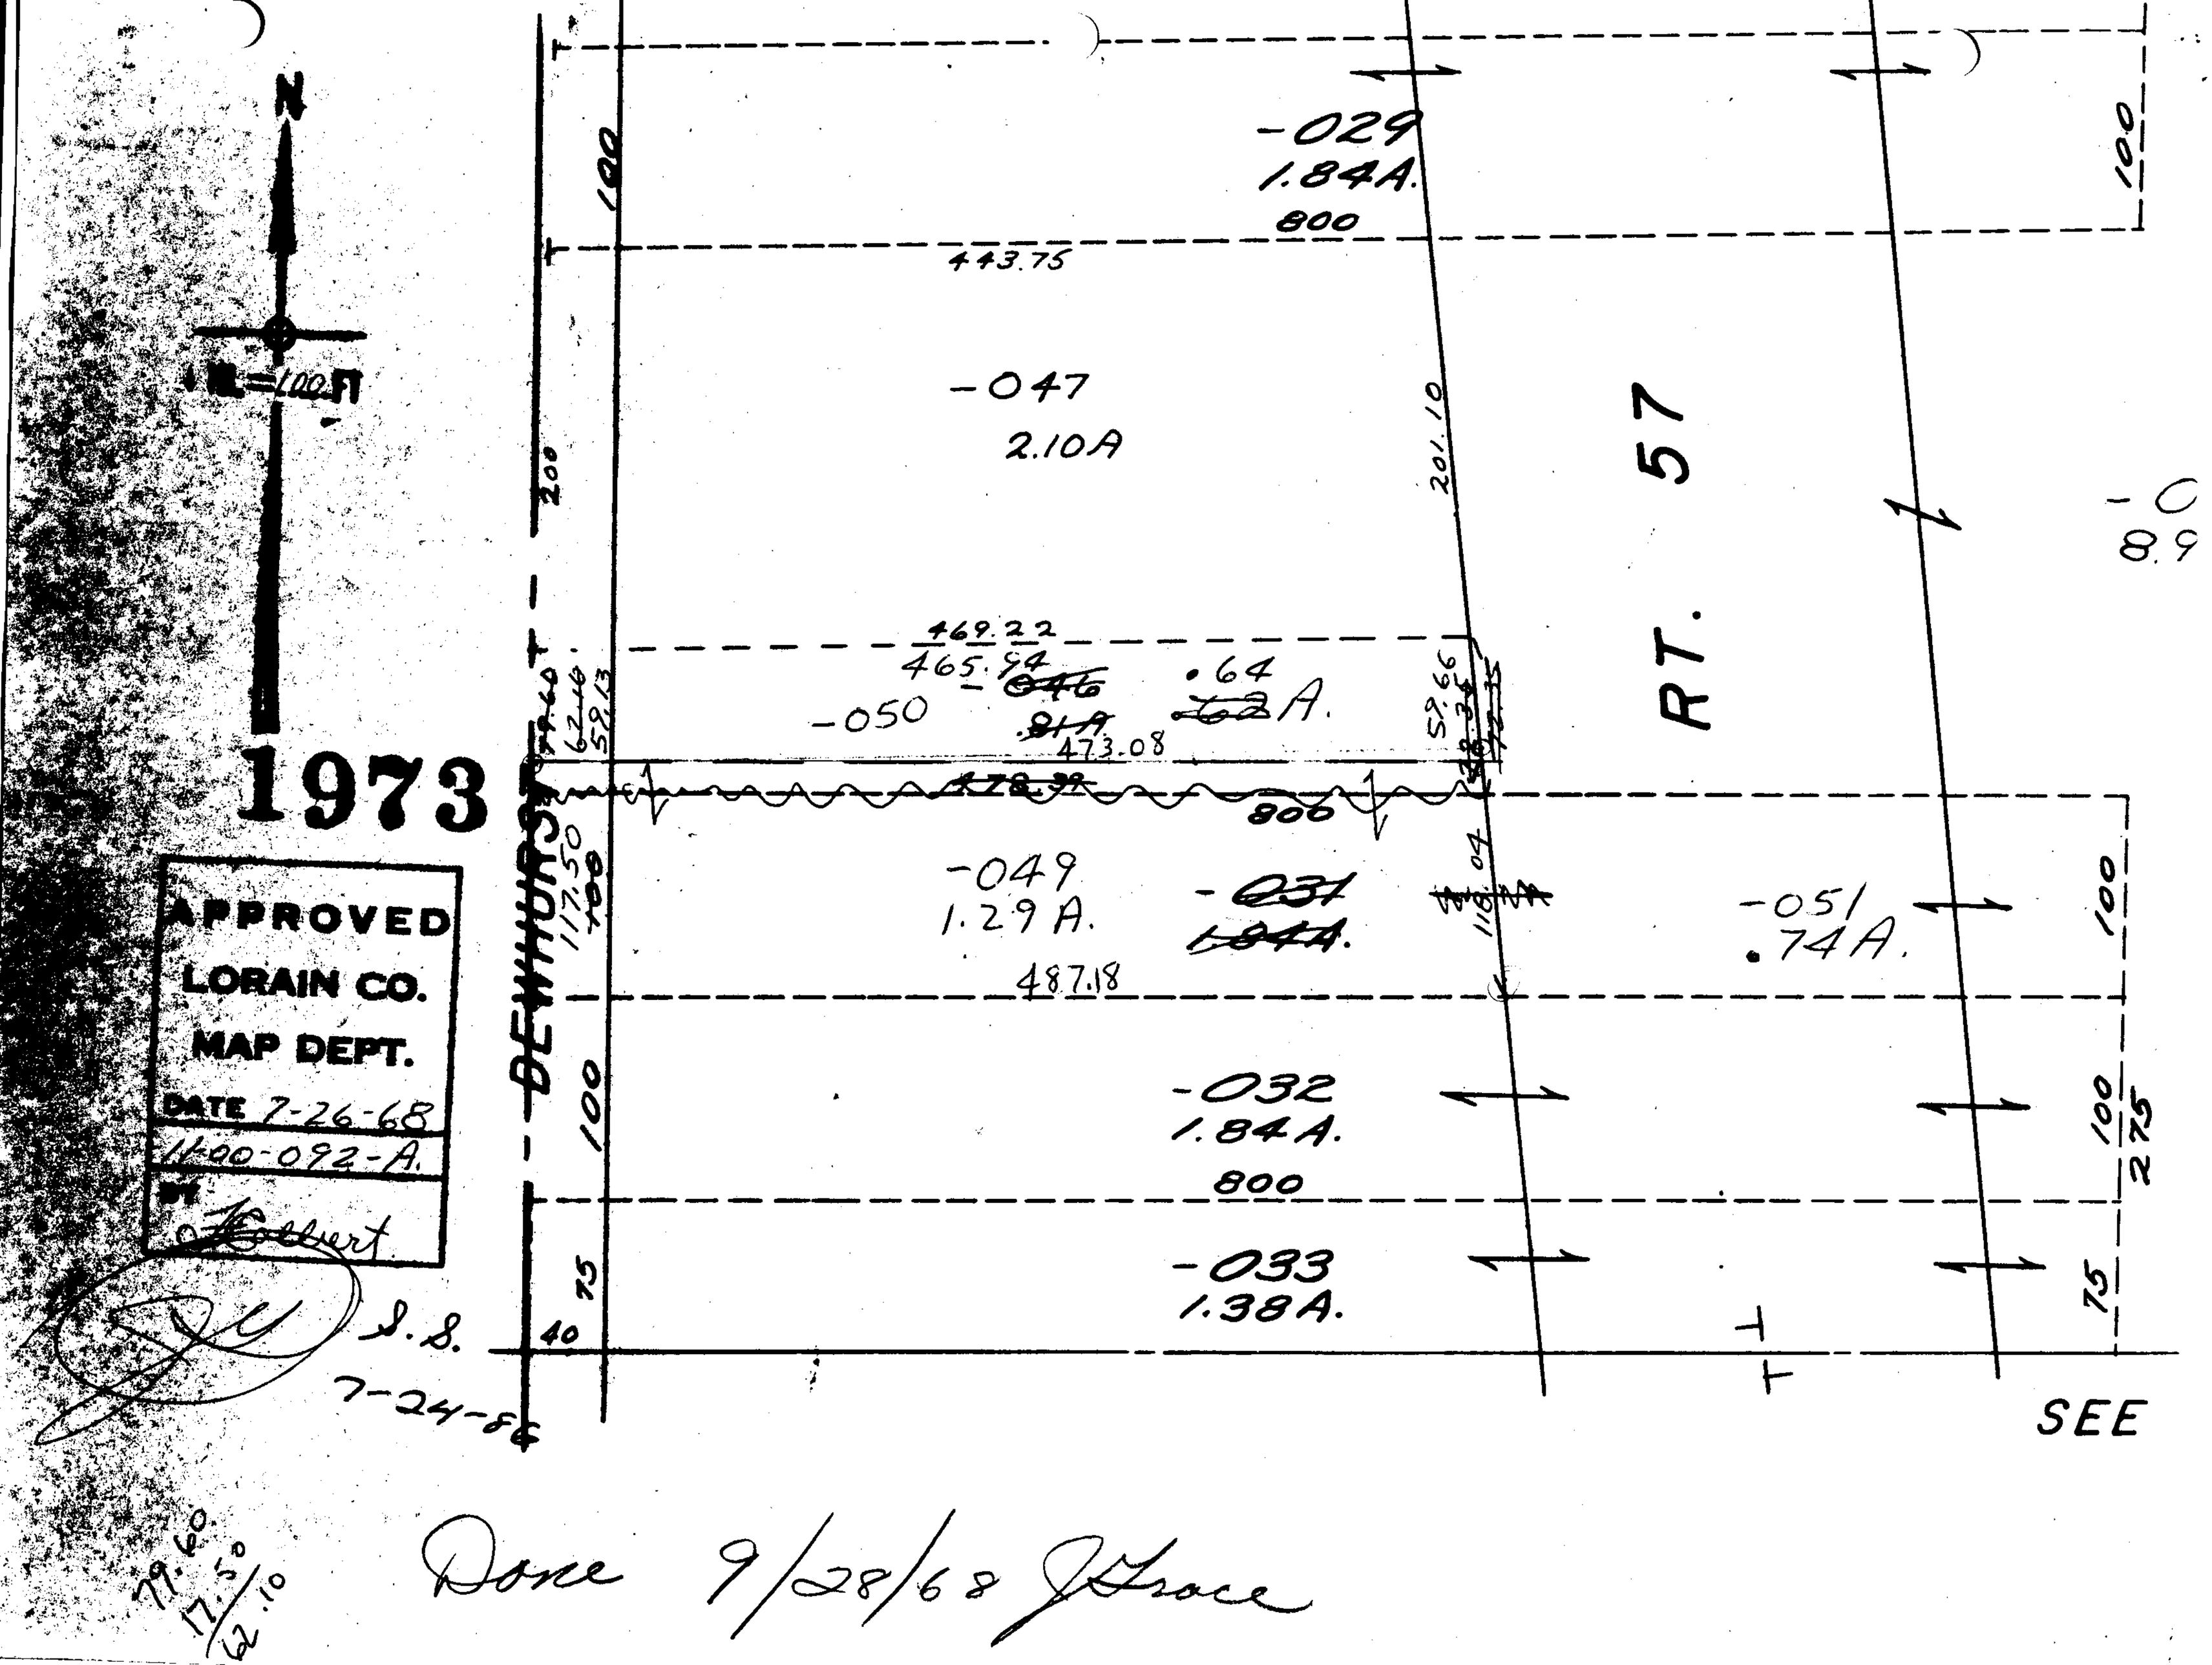
N
1 IN. = 100 FT
1973
APPROVED
LORAIN CO.
MAP DEPT.
DATE 7-26-68
11-00-092-A.
BY
-029
1.84A.
800
443.75
-047
2.10A
201.10
RT. 57
-0
8.9
469.22
465.94
-046
.64
-050
.81A
.62A.
473.08
59.66
800
-049
1.29 A.
-031
1.84A.
118.04
-051
.74A.
487.18
-032
1.84A.
800
-033
1.38A.
DEWHURST
100
200
100
100
100
100
275
75
75
40
SEE
S.S.
7-24-86
79.60
17.50
62.10
Done 9/28/68 J Grace