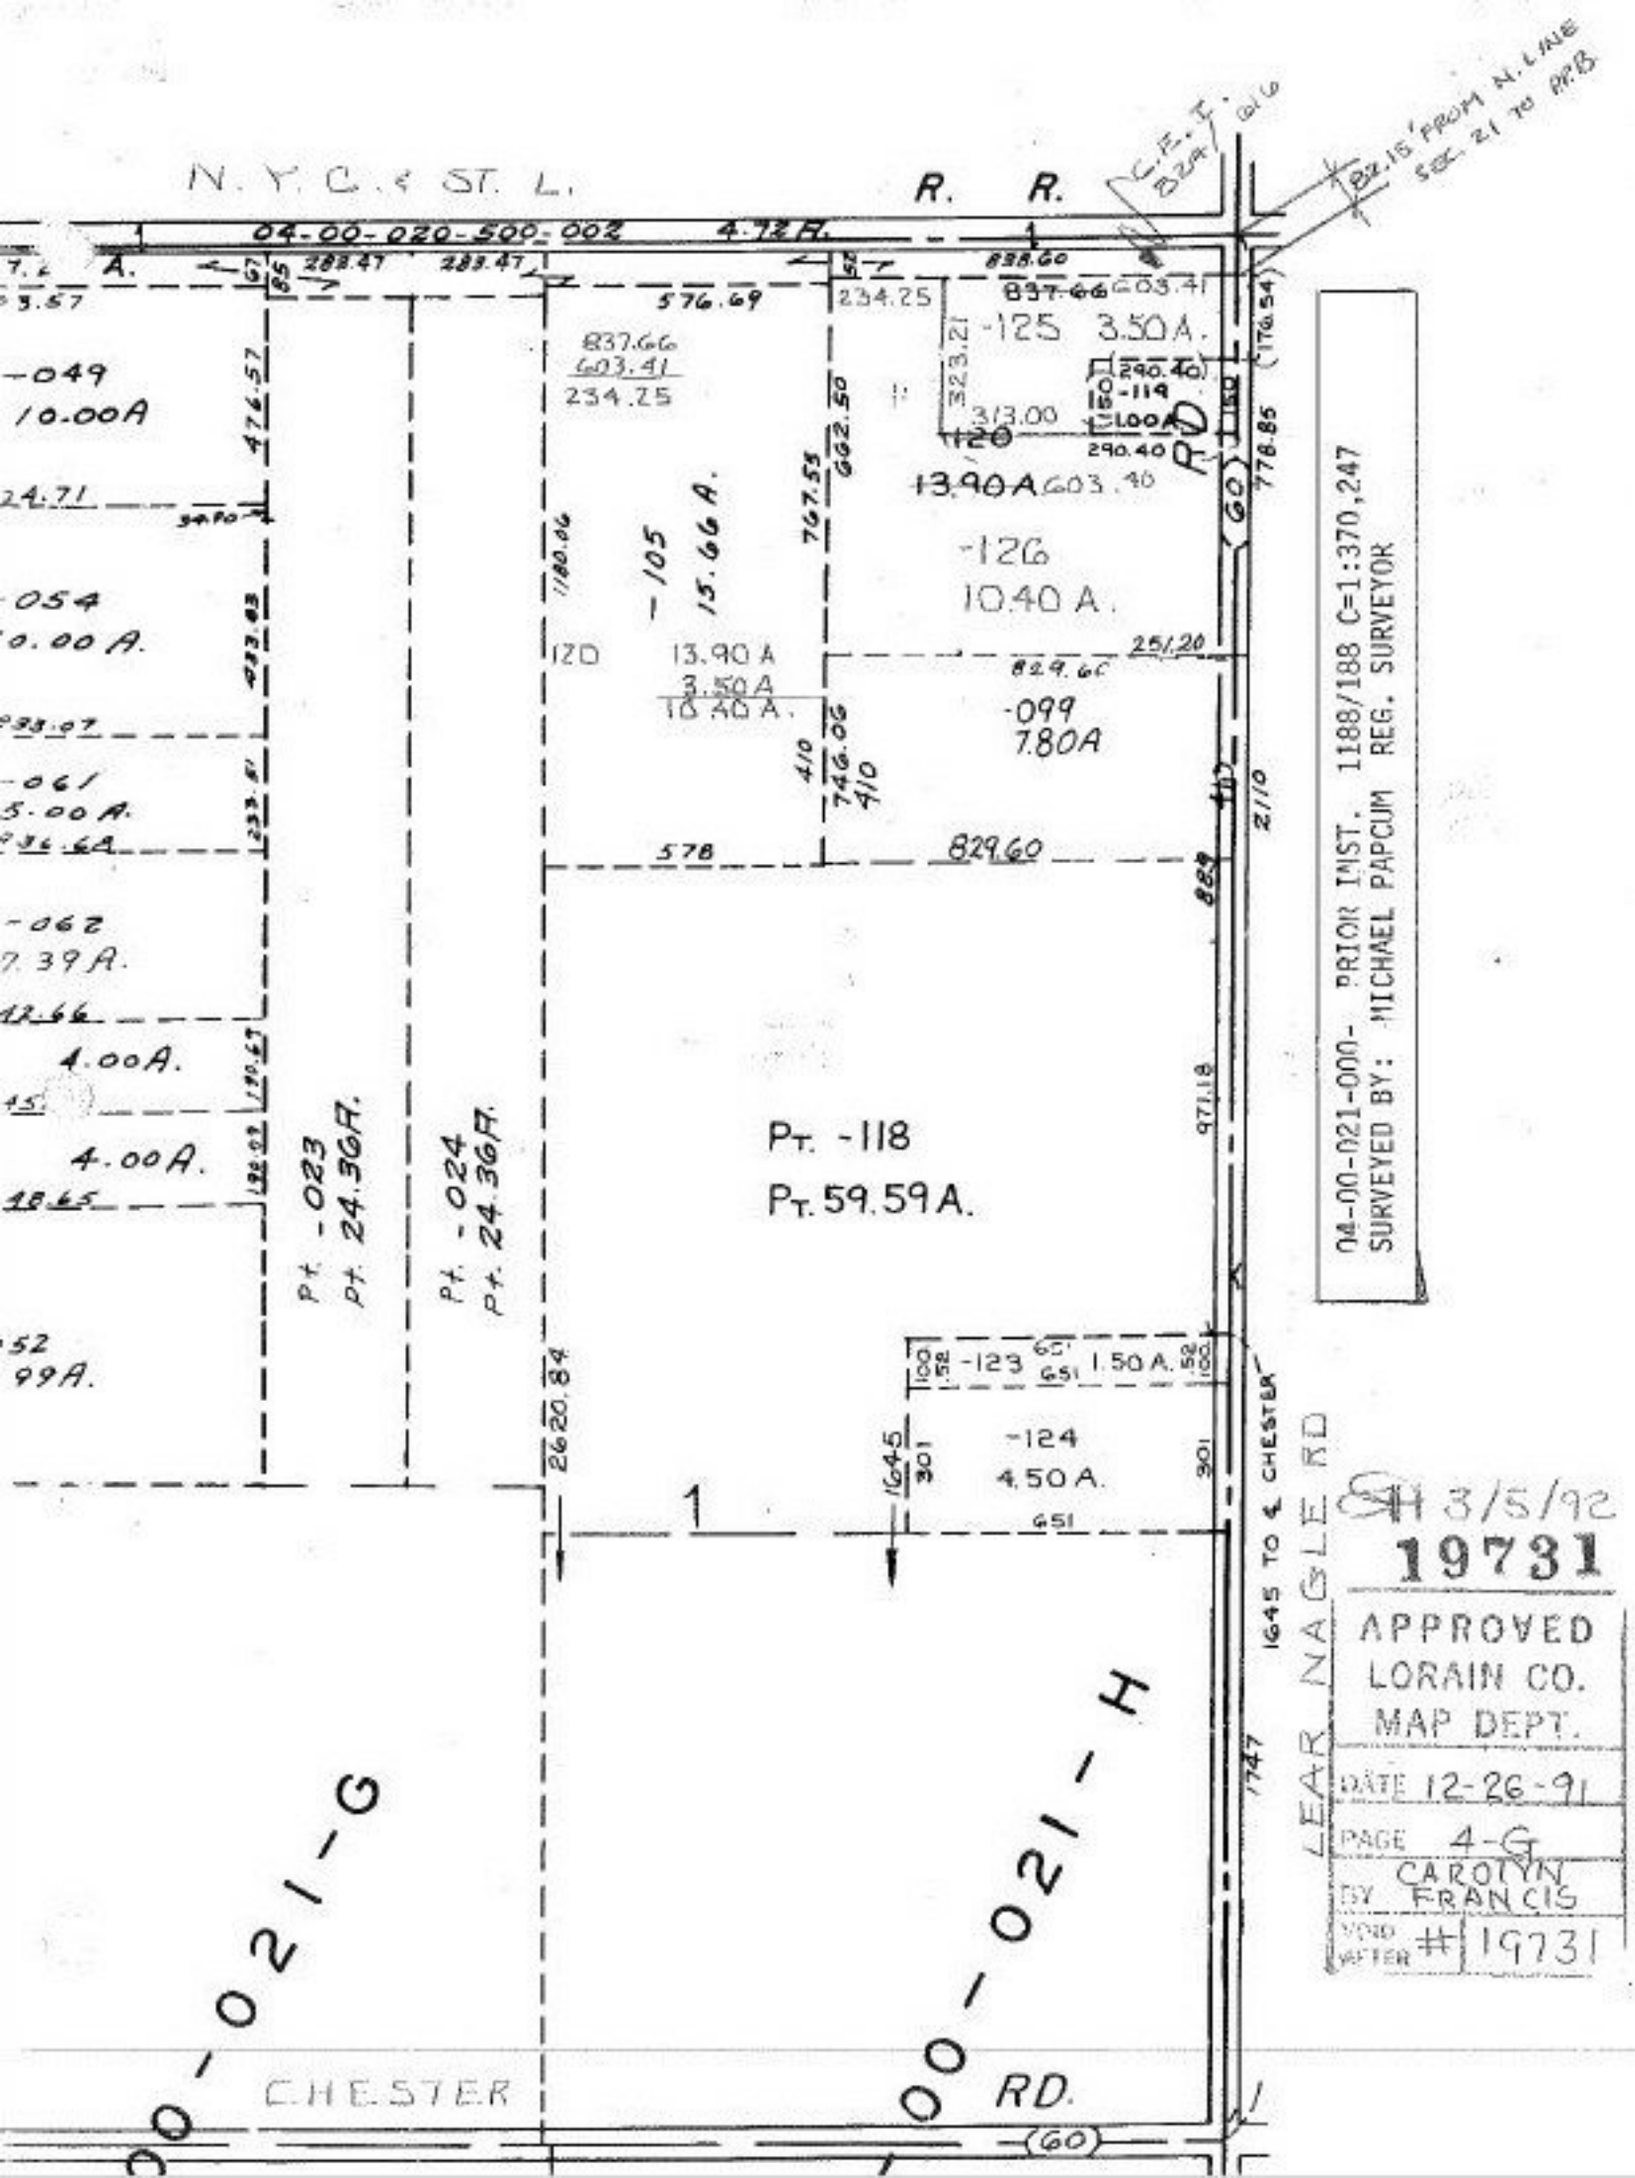
N. Y. C. & ST. L. R. R.
04-00-020-500-002 4.72 A.
182.15' FROM N. LINE SEC. 21 TO R/R
C.E.T. 0.16
288.47
288.47
576.69
838.60
837.66
603.41
234.25
-125 3.50 A.
323.21
313.00
290.40
-119
1.00 A.
290.40
RD.
778.85 (1760.54)
603.40
13.90 A
-126
10.40 A.
-105
15.66 A.
1180.06
767.53
662.50
476.57
-049
10.00 A
-054
10.00 A.
-061
5.00 A.
-062
7.39 A.
4.00 A.
4.00 A.
Pt. -023
Pt. 24.36 A.
Pt. -024
Pt. 24.36 A.
120
13.90 A
3.50 A
10.40 A.
746.06
410
578
829.60
251.20
829.60
-099
7.80 A
971.18
2110
Pt. -118
Pt. 59.59 A.
2620.84
-123 1.50 A.
-124
4.50 A.
1645
301
651
1645 TO E. CHESTER
LEAR NAGLE RD
1747
00-021-G
00-021-H
CHESTER RD.
(60)
04-00-021-000- PRIOR INST. 1188/188 C=1:370,247
SURVEYED BY: MICHAEL PAPCUM REG. SURVEYOR
APPROVED
LORAIN CO.
MAP DEPT.
DATE 12-26-91
PAGE 4-G
BY CAROLYN FRANCIS
VOID AFTER # 19731
3/5/92
19731